
UCCS KEYSTONE BOILER REPLACEMENT

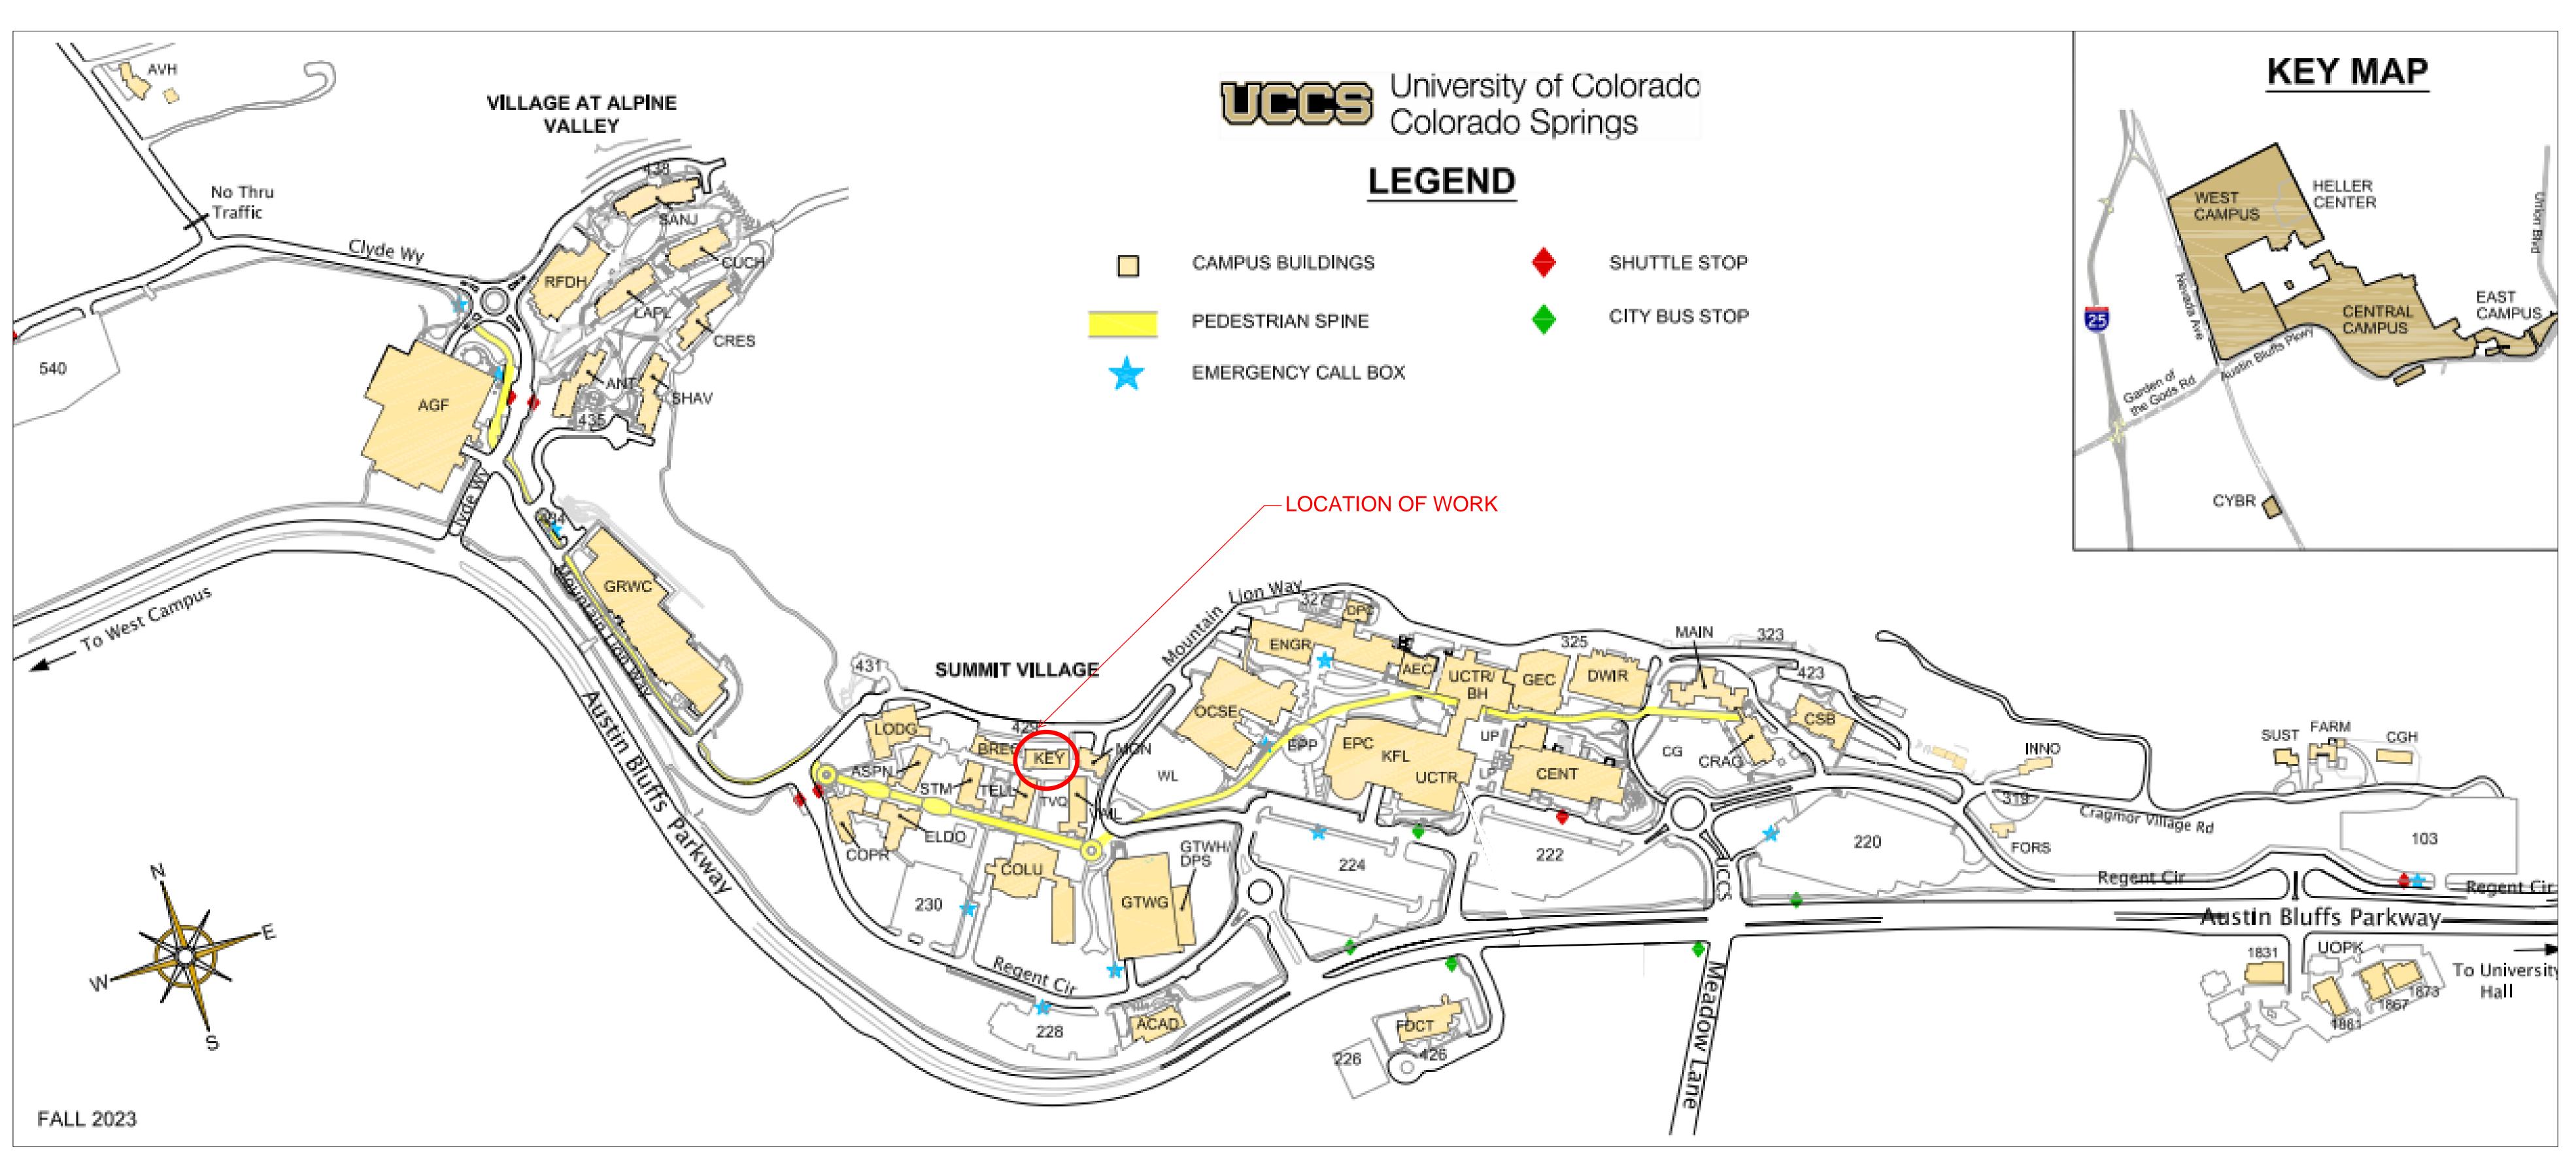

COVER SHEET

AS BUILT DRAWINGS (FOR REFERENCE)

SD1 SITE PLAN


A5 BUILDING C - PLAZA LEVEL FLOOR PLAN


M-20 MECHANICAL ROOM FOR BUILDINGS 'B', 'C', & 'D'

M-23 BLDG 'B', 'C', 'D', 'F', 'G', & 'H' HEATING WATER SCHEMATIC

M-26 SCHEDULES

M-27 SCHEDULES

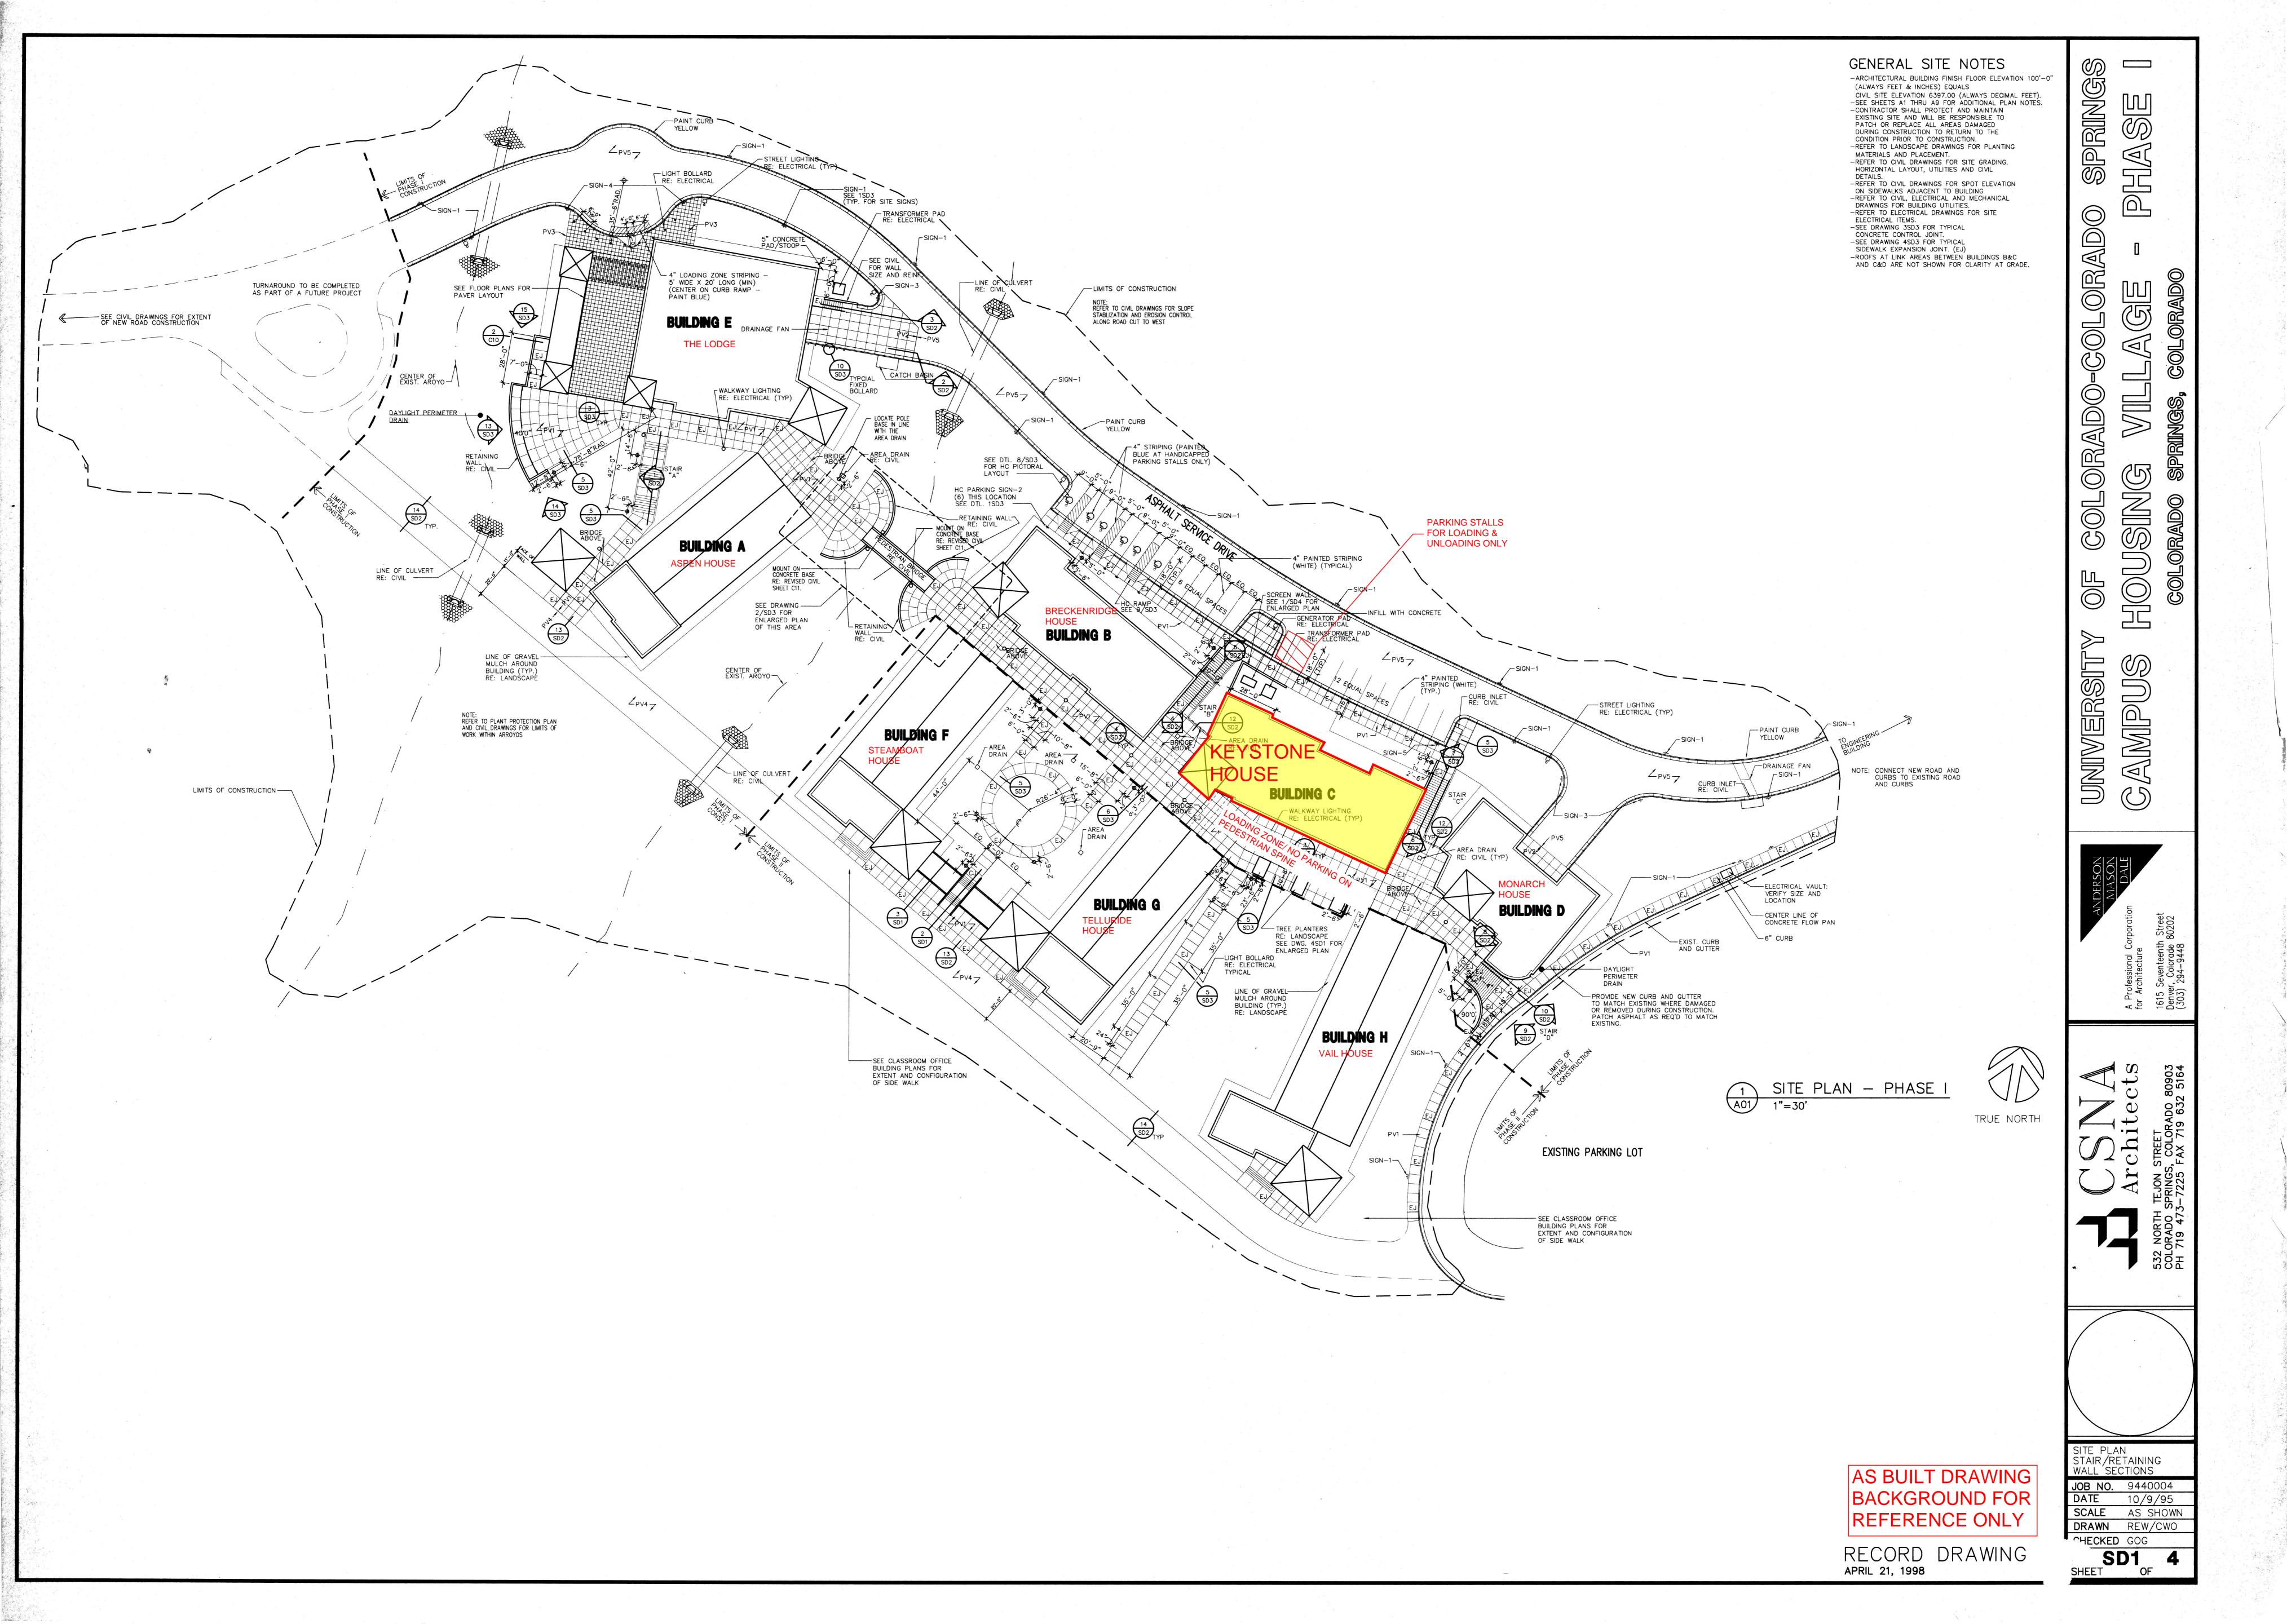

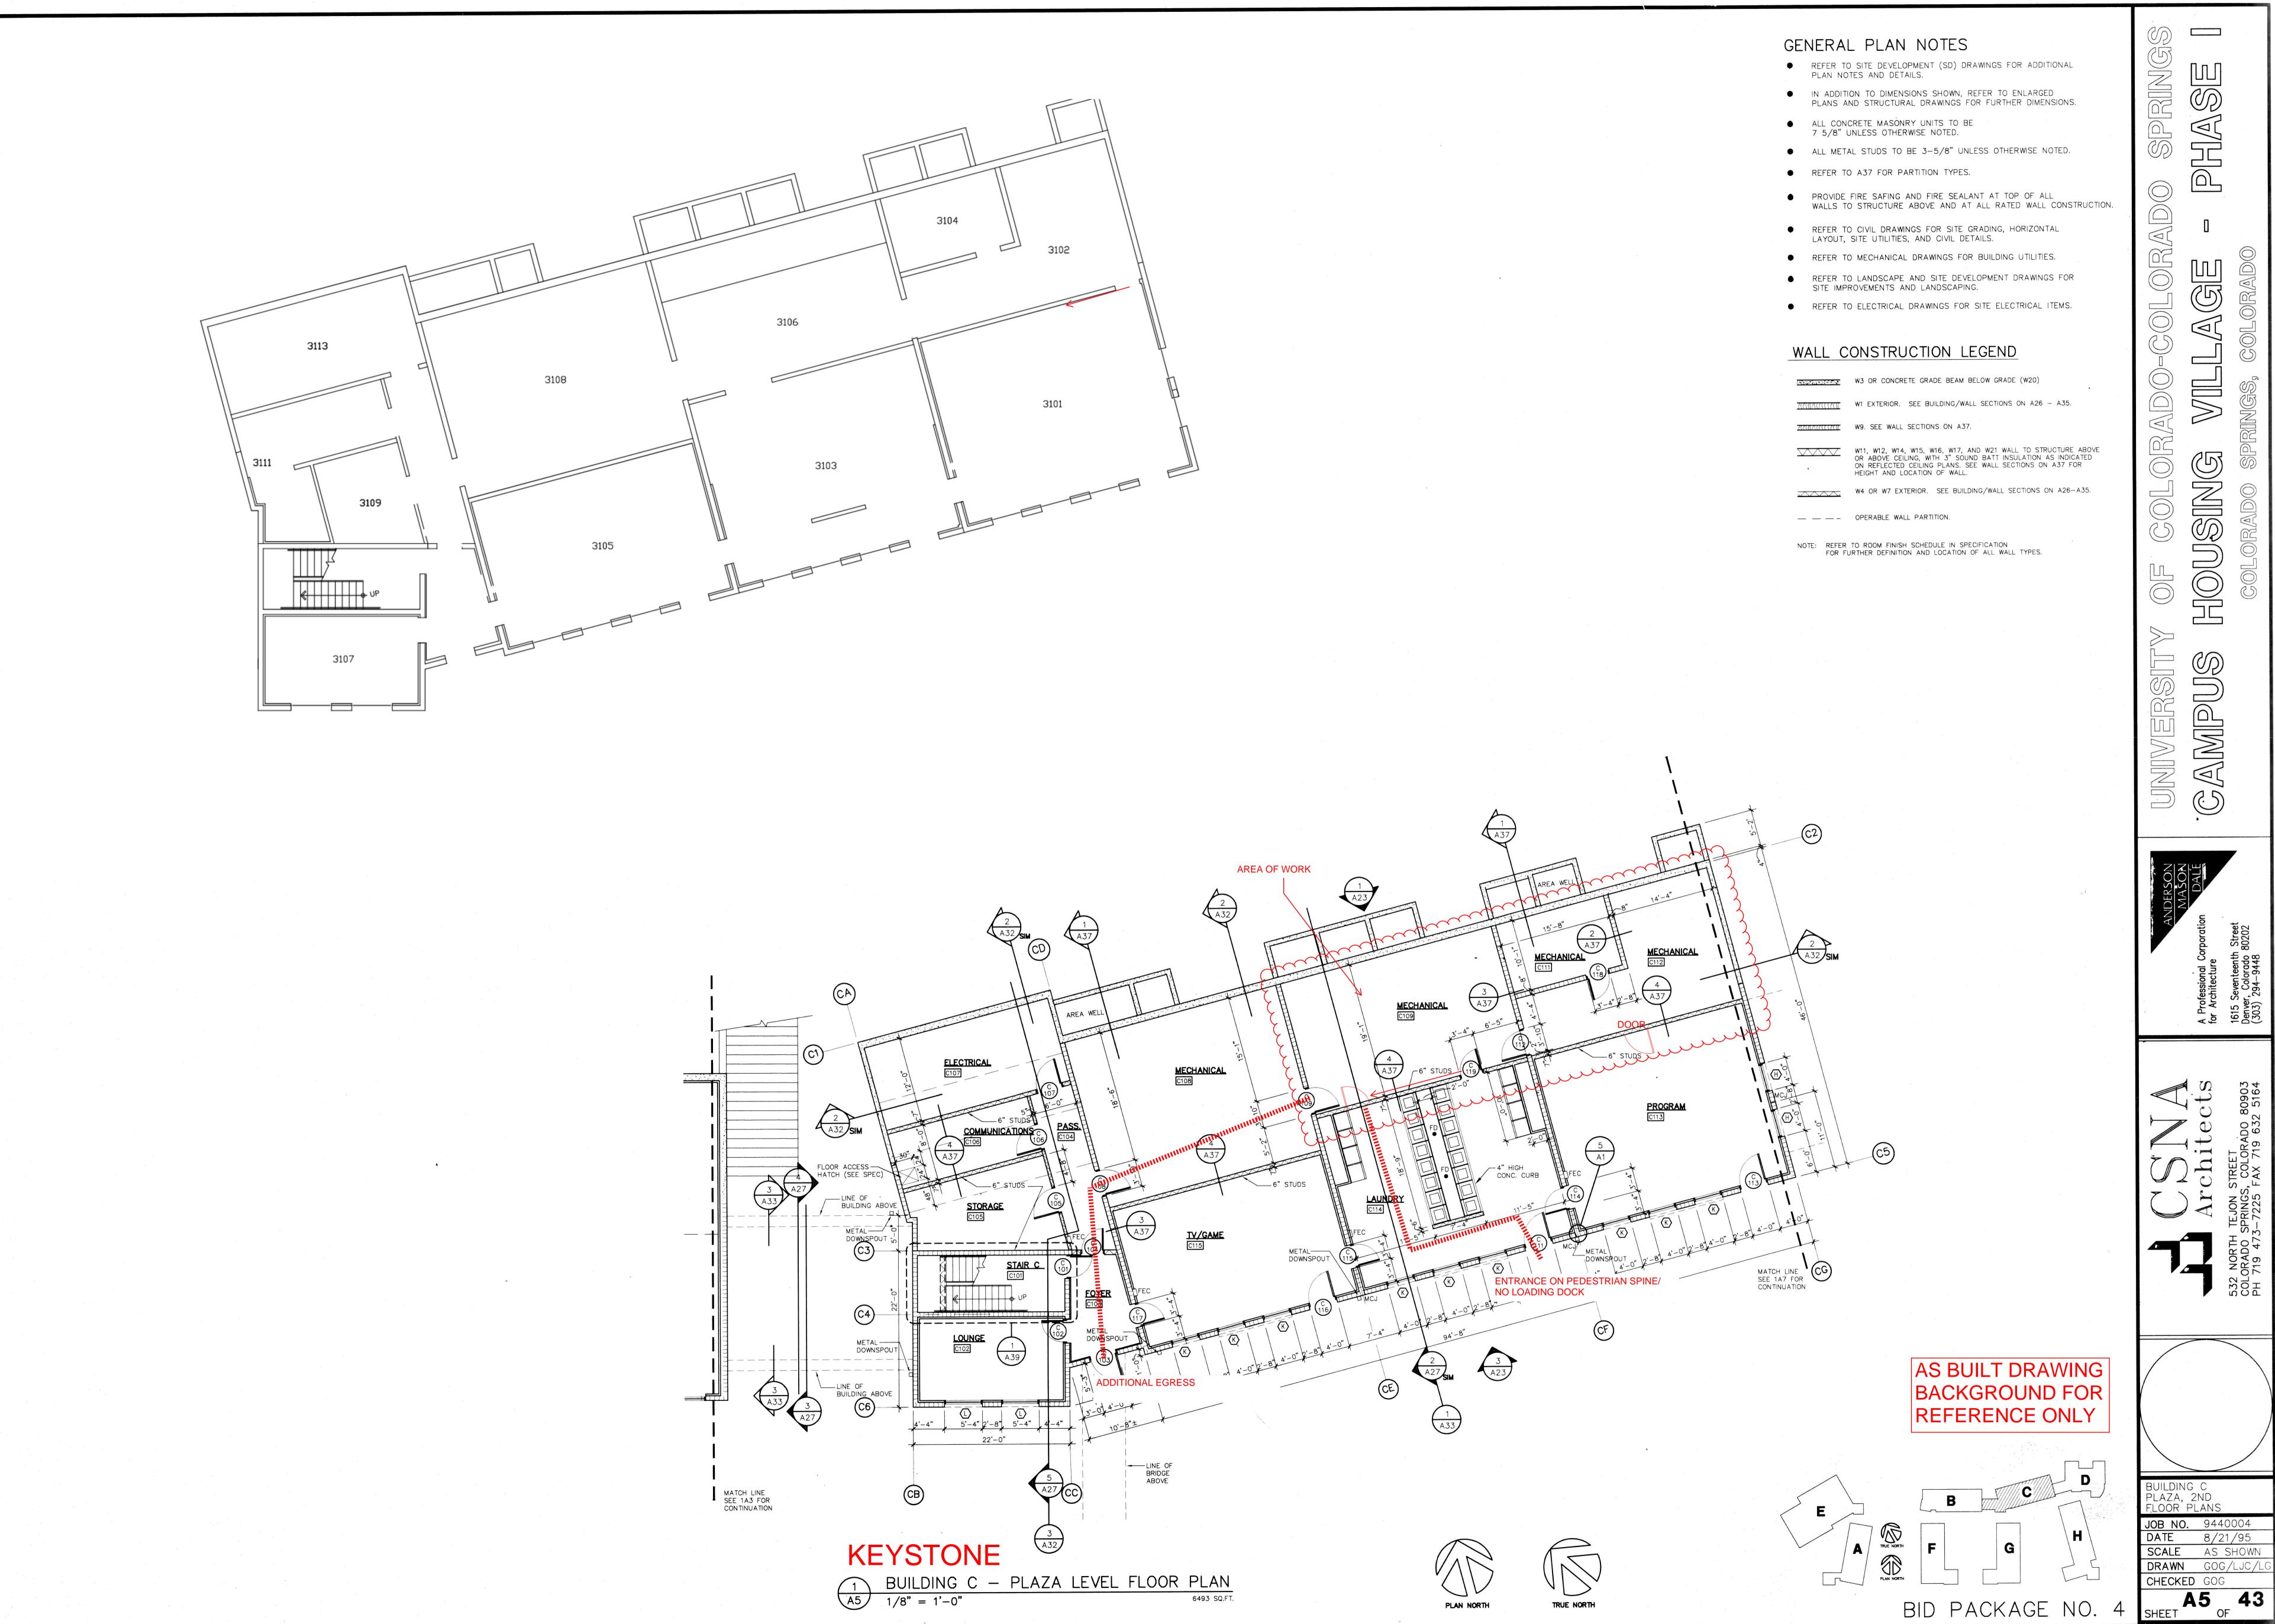

FILENAME: X: \UCCS\9440004\CD\A05.DWG

BUILDING C PLAZA, 2ND FLOOR PLANS


JOB NO. 9440004


DATE 8/21/95

SCALE AS SHOWN

DRAWN GOG/LJC/LG

CHECKED GOG

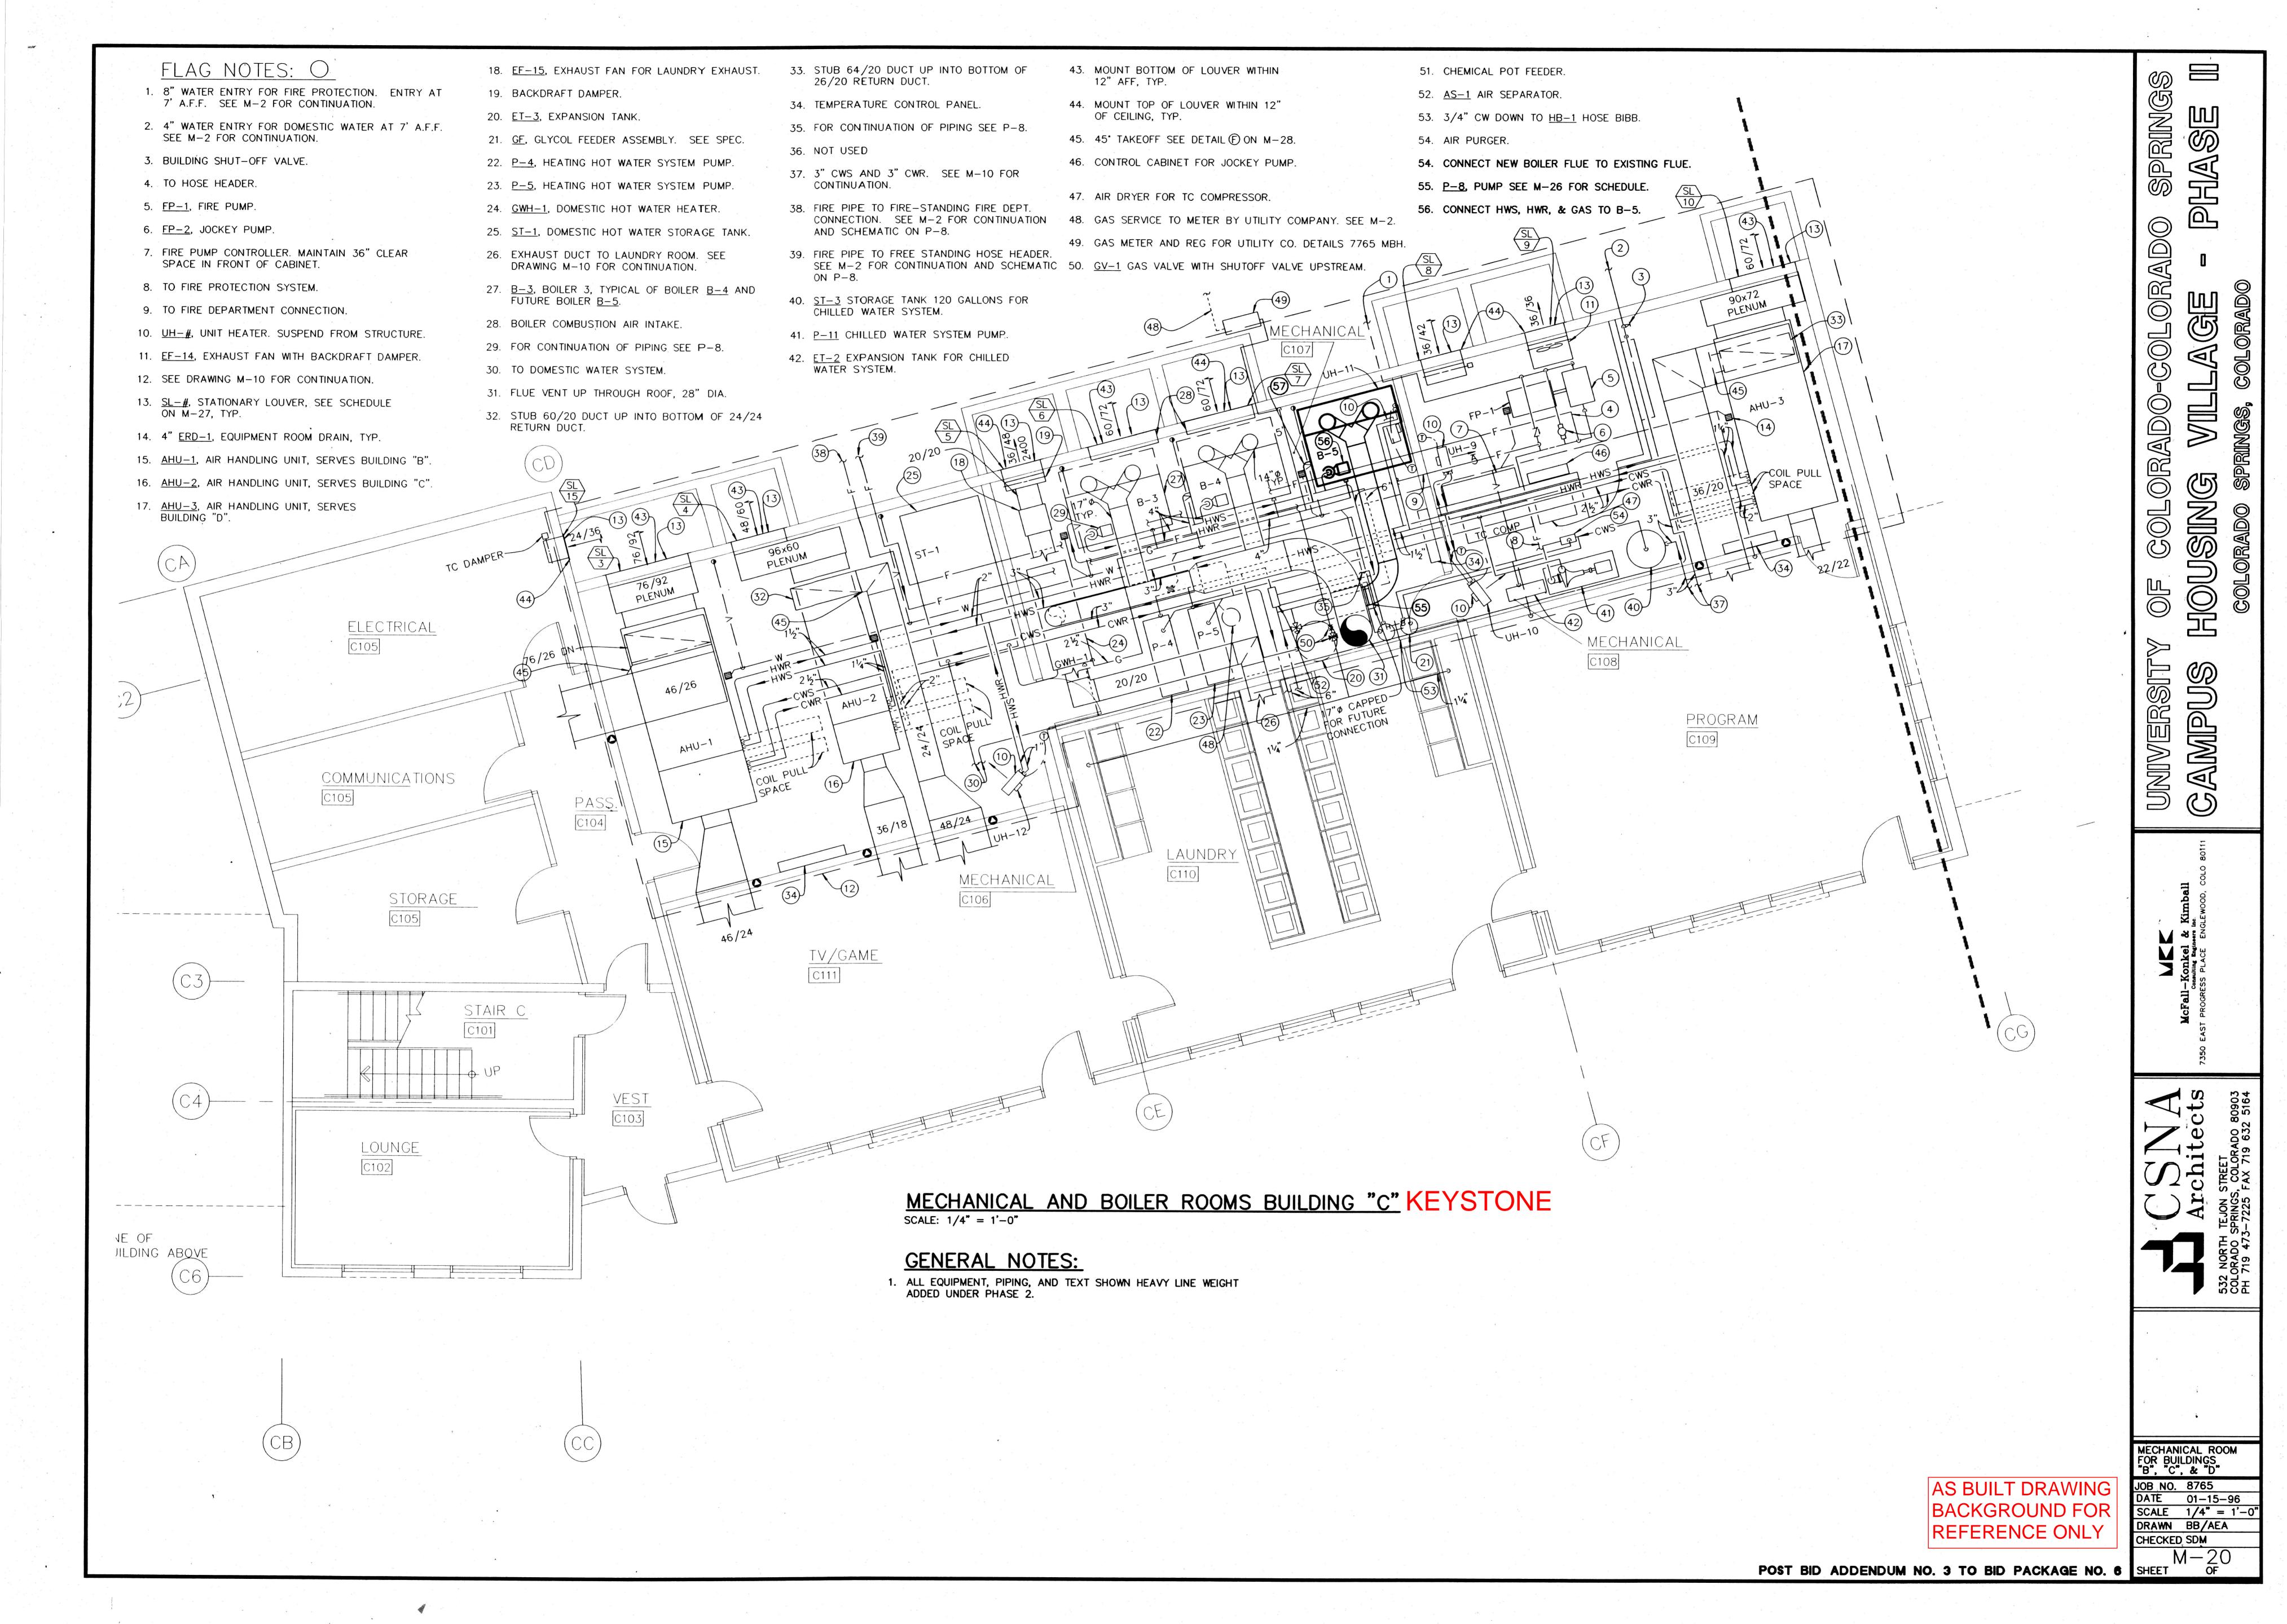

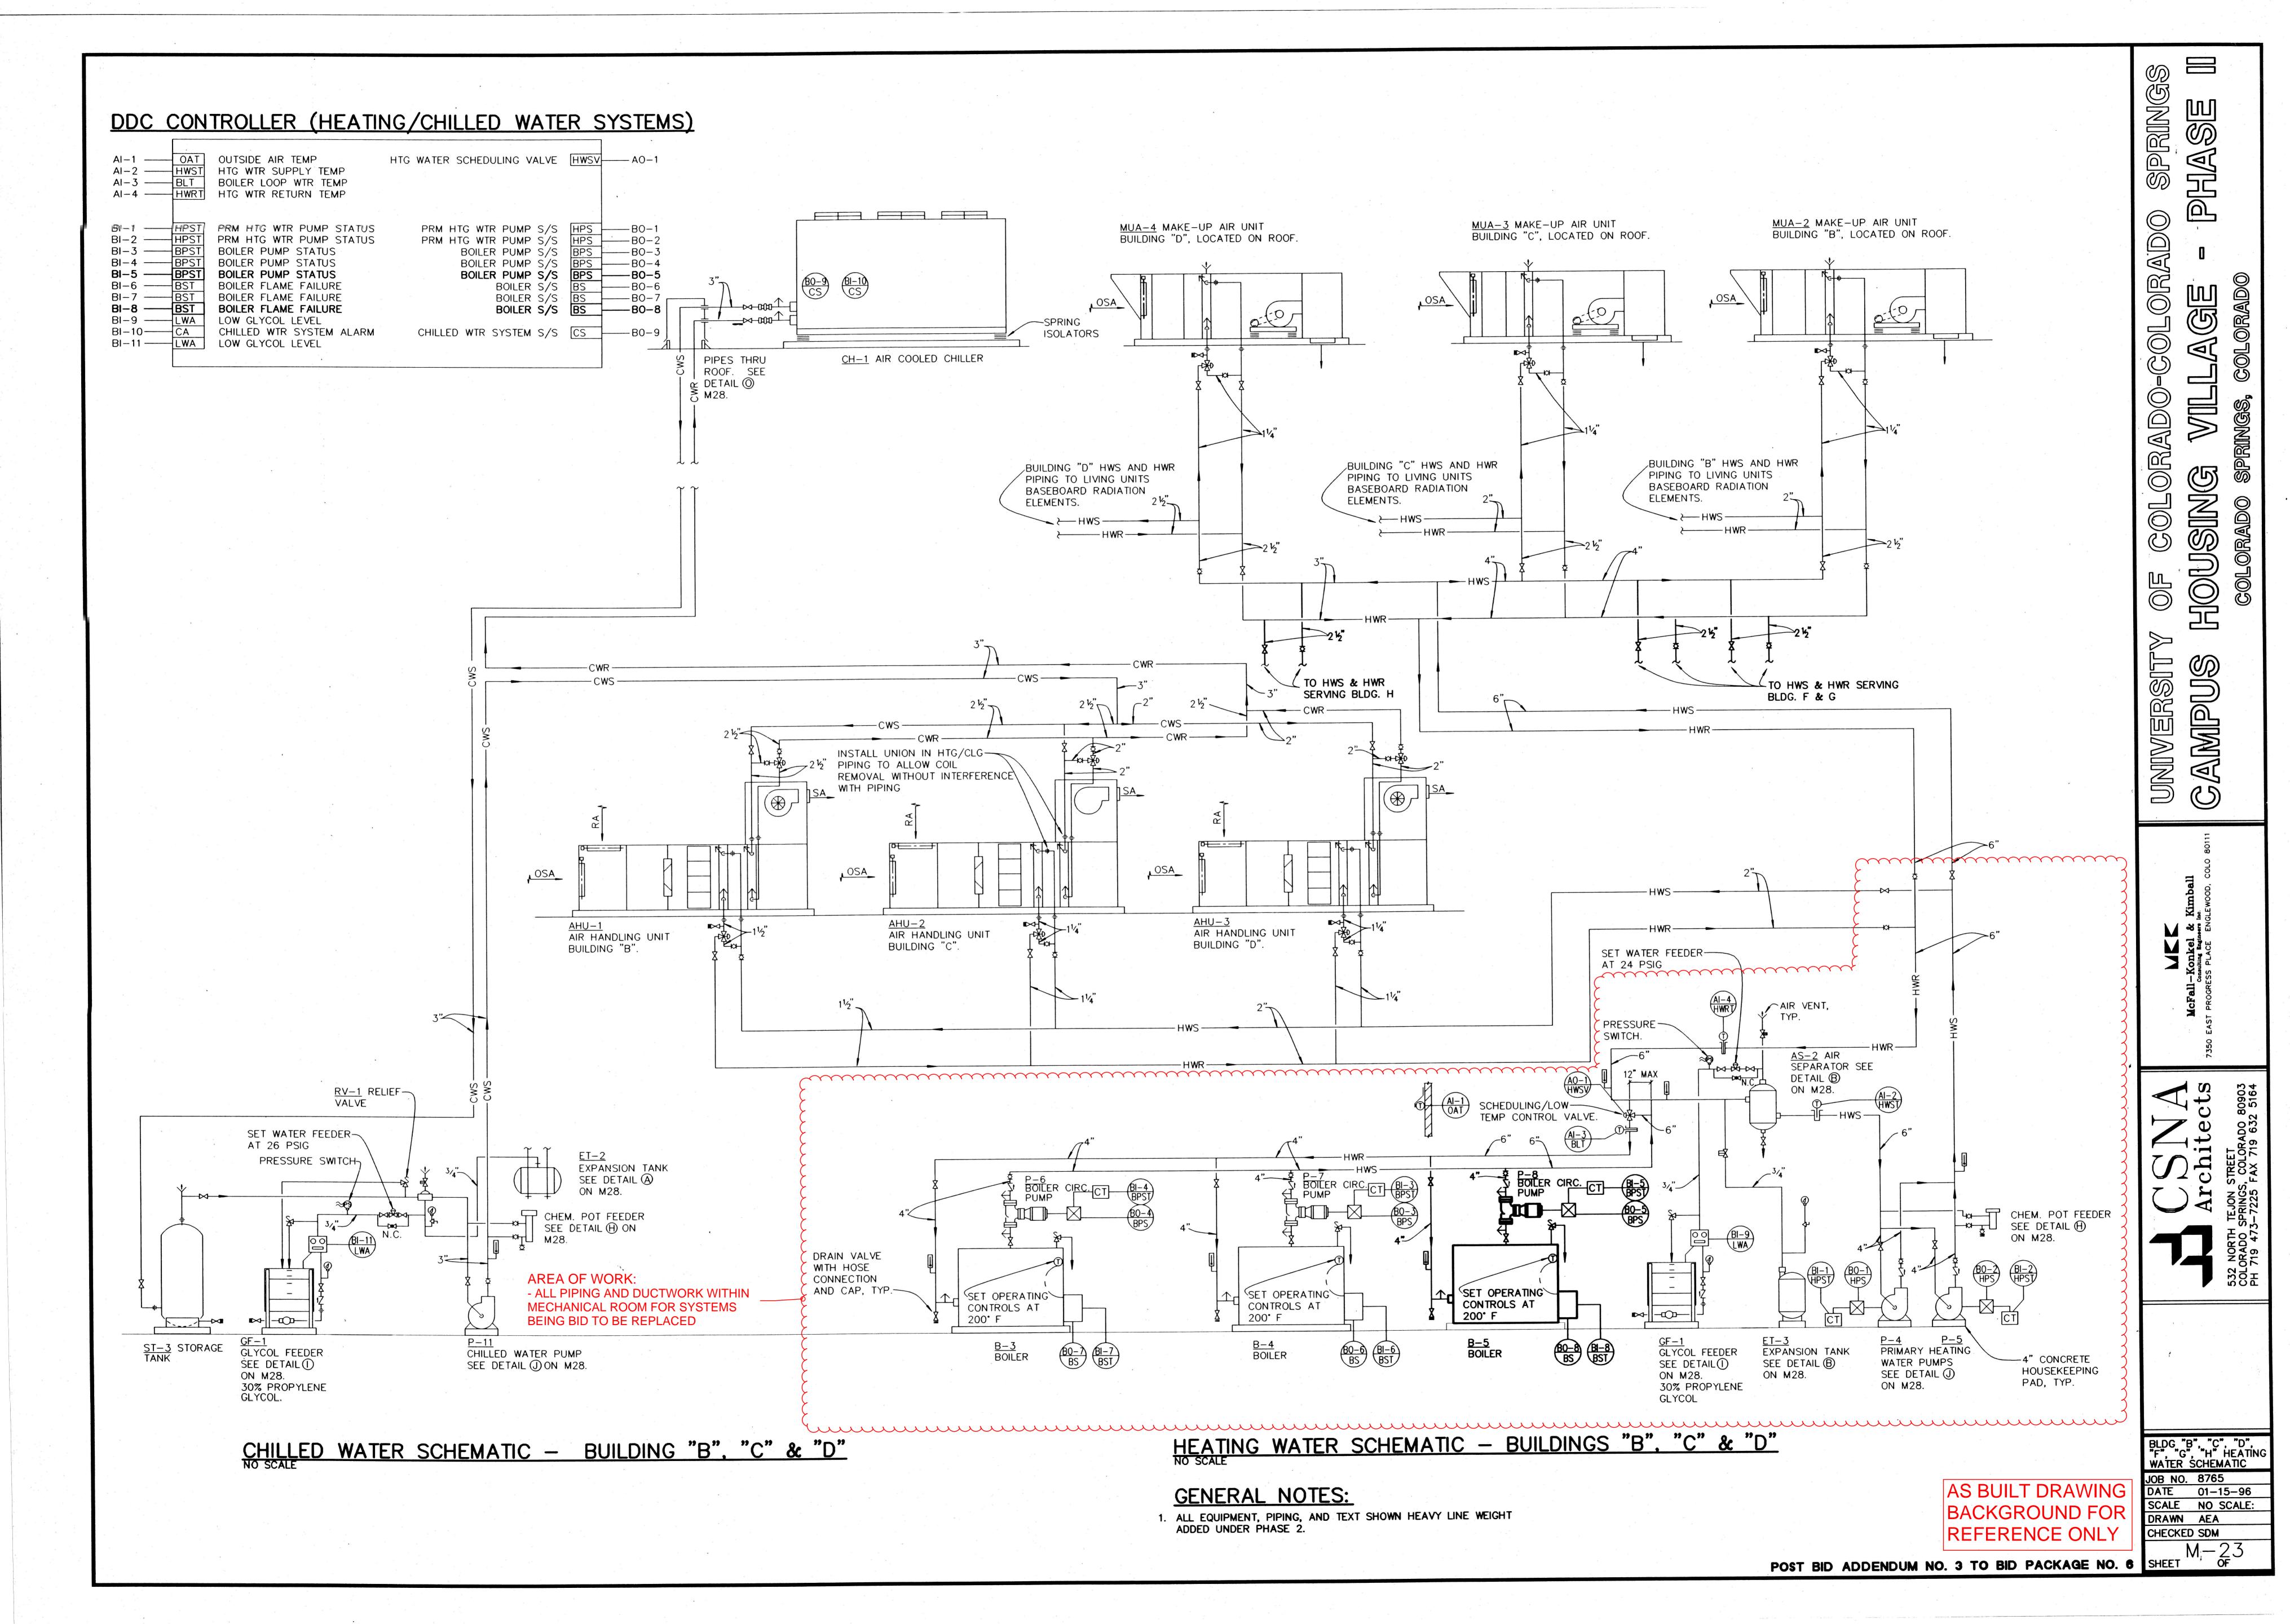

JOB NO. 8765
DATE 01-15-96 SCALE NO SCALE
DRAWN AEA
CHECKED SDM

~			, *						2					AIF	₹ C	COOL	ED C	HILLE	ER SC	HEDUL	E	
ITEM	DWG.	TYPE	CAP TONS	MCA		EVAPORA				OMPRESSO	T			СО	NDENS	SER FAN	·	COND.	%	OP. WT. LBS.	MANUFACTURER	NOTES
		e e	10110		EWT F	LWT GPM	P.D. FEET	NO.	V-Ø	STRTR	KW	RLA	LRA	NO. I	HP	V-Ø	STRTR	TEMP.	GLYCOL PROPYLEN	IE LBS.	& MODEL NO.	
CH-1	M-17	SCROLL	50	97	55	45 115	17.5	4	460-3	INTEGRAL	55.7 1	5.5/24.2	5/142	6	1	460-3	INTEGRAL	95	30	5800	TRANE CGAE-C50	BUILDINGS "B", "C", & "D"
CH-2	M-21	SCROLL	60	119	55	45 130	18.15	4	460-3	INTEGRAL	73.1	25.4	142	6	1	460-3	INTEGRAL	95	30	6700	TRANE CGAE-C60	BUILDING E
						-	A 10 PM					-			-							

								1 1 1 1 1 1 1 1 1 1 1 1 1 1 1 1 1 1 1		~.				Al	RH	AND	LIN(G UN	NT/	/ RE	TUR	N FA	N SC	HED	ULE	,				, , , , , , , , , , , , , , , , , , ,		
EM C	WG.	SERVICE				. *	SUPPLY	AIR FAN					. (CHILLE	D WATE	R COIL		,			, 1		HEATI	NG HOT	WATER	COIL				OP. WT	MANUFACTURER	NOTES
. '	0.		CFM	MIN. OSA	FAN	E.S.P.	T.S.P.	MOTOR			SENS.	E.A.	ſ. Ļ.A.		CHILLED			MAX.		HEATING	G CAP.	E.A.T.	L.A.T.		TING W			MAX. A	P	LBS.	& MODEL NO.	NOTES
				CFM	''' -	ALT.	ALT.	HP	V-ø	STRTR	CAP.		, F		M E.W.T	. L.W.T.	% GLY	AIR	WATER	CFM	MBH	F	F	GPM	E.W.T.	L.W.T.	% GLY	AIR	WATER			*
1-1 M	-20 P	LDG. "B"	11 140		EC	1 51	7 10	15	460 7	1110	The state of the s	and the second s	B DB	COLUMN TO SERVICE STATE OF THE	- I -				FT. W.C			DB	DB		F	Ŧ	(PROP)	IN. W.C.	FT. W.C.		,	
							3.18	15		MAG-HOA					5 45	55°		0.35	8.11	2800	84	20	55	13	200	170	30	0.15	0.68	2766	TRANE MCC SIZE 21	
7 14	20 0	LDG. "C"	4980	2500	FC		2.92	5		MAG-HOA					5 45°			0.33	4.03	4980	82	38	55	10	200	170	30	0.11	0.51		TRANE MCC SIZE 10	
- 3 M	-20 B	LDG. "D"	6920	/65	FC	1.55	2.67			MAG-HOA					5 45°		30%	0.30	4.82	1780	23	40	55	10	200	170	30	0.06	0.46		TRANE MCC SIZE 14	
		INING RM					2.58			MAG-HOA	208	83 6	2 60 5	54 4	5 45°	55°	30%	0.20	5.99	5000	378	-1	87	30	200	170	30	0.10	0.86		TRANE MCC SIZE 21	
		ANQUET		*		1	3.62	7-1/2	460-3	MAG-HOA	176	80 6:	2 60 5	55 4	0 45	55*	30%	0.17	4.37	3500	236	0	75	16	200	170	30	0.11	0.53		TRANE MCC SIZE 21	*3200/1600 CFM HI/LO
-6 M -	-21 S	ERVERY	7200	7200	FC	1.00	2.32	5	460-3	MAG-HOA	201	91 6:	2 60 5	51 4	5 45°	55°	30%	0.42	4.98	7200	548	-1	82	40	200	170	30	0.13	2.01	2207	TRANE MCC SIZE 14	MIN OA FROM CO ₂ SENSO 2 SPEED MOTOR

TEM DWO		·		T			SUPPLY	AIR FAN					10	CHILLE	D WATE	R COIL					, ,		HEAT	ING HO	T WATER	R COIL	2			OP. WT.	MANUFACTURER	NOTES
110.			CFM			E.S.P.	T.S.P.	MOTOR		T 0====	SENS.	E.A.T	· LA		CHILLED			MAX.			G CAP.	E.A.T.			ATING W			MAX. A	A P	LBS.	& MODEL NO.	NOILS
		* ,		CFM		ALT.	ALT.	HP	V-Ø	STRTR	MBH	DB WE	DDI		PM E.W.T	. L.W.T.	% GLY	AIR IN W.C.	WATER FT. W.C	CFM	MBH		F	GPM	E.W.T.	L.W.T	. % GLY (PROP)		WATER			, , ,
IU−1 M−2	O BIT	DC "P"	11 140	2040	EC	1 51	7 10	15	460 7	1110 1101	070.6											DB	DB		l r		(PROP)	IN. W.C.	FT. W.C.			
							3.18	15		MAG-HOA		78 62	2 55	54 5	5 45	55°	30%	0.35	8.11	2800	84	20	55	13	200	170	30	0.15	0.68	2766	TRANE MCC SIZE 21	
-2 M-2	OBL	DG. "C" 4	4980	2500	FC		2.92	5		MAG-HOA		83 62	2 55	54 25	5 45°	55	30%	0.33	4.03	4980	82	38	55	10	200	170	30	0.11	0.51		TRANE MCC SIZE 10	
		DG. "D" (1.55	2.67	7-1/2	460-3	MAG-HOA	138	77 62	2 55	54 35	5 45°	55°	30%	0.30	4.82	1780	23	40	55	10	200	170	30	0.06	0.46	2314	TRANE MCC SIZE 14	
		VING RM 1					2.58	10	460-3	MAG-HOA	208	83 62	60	54 4	5 45°	55°	30%	0.20	5.99	5000	378	-1	87	30	200	170	30	0.10	0.86			
J - 5 M - 2	1 BAI	NQUET	9,500	3200	FC	2.26	3.62	7-1/2		MAG-HOA		80 62						0.17	4.37	3500	236	 	75	16		170	70	0.10			TRANE MCC SIZE 21	
				*		,				1107	1,,,,			55 4	0 73	33	30%	0.17	4.57	3300	236	0 ,	75	16	200	170	30	0.11	0.53	2698	TRANE MCC SIZE 21	*3200/1600 CFM HI/LO MIN OA FROM CO ₂ SENSOR
U-6M-2	1 SEF	RVERY	7200	7200	FC	1.00	2.32	5	460-3	MAG-HOA	201	91 62	60	51 4	5 45°	55°	30%	0.42	4.98	7200	548	-1	82	40	200	170	30	0.13	2.01	2207	TRANE MCC SIZE 14	
													F 0		7					1200	10.0	<u> </u>	02	1 10	200	170	50	0.15	2.01	2207	TRANE MCC SIZE 14	2 SPEED MOTOR

,			,	2 × 1							, ,	IAK	E-UF	AIR	UN	IT S	CHED	ULE (HOT	WATER)				 2 2		
ITEM	DWG.	SERVICE				PLY AIR F							НС	T WATER	COIL				OP.	MANUFACTURER	NOTES		 		* * *	
	NO.			FAN	E.S.P. IN. W.C.	T.S.P.	RPM			DATA	CAP. MBH	E.A.T.	L.A.T.		ŅG WA			Χ . Δ Ρ	WT.	& MODEL NO.						
			*	l ''' -	ALT.	Ø ALT.	MAA.	HP	V-ø	STRTR	МВП	F	r	GPM	E.W.T	Ļ.W.T.	AIR	WATER FT. W.C.	LDS.	,						
MUA-1	M-5	BLDG "A"	3000	FC	.375	1.48	1120	2 4	160-3	MAG-HOA	144.2	2	58	10	200	170	.06	.22	3500	TRANE PCC-07						
MUA-2		BLDG "B"	3600	FC	.375	1.68	1250			MAG-HOA	173	2	58	12	200	170	.10	.29	3500	TRANE PCC-07			 			
	M-13	BLDG "C"	3600	FC	.375	1.68	1250			MAG-HOA	173	2	58	12	200	170	.10	.29	3500	TRANE PCC-07	,					
MUA-4 I			2400	FC	.375	1.23	1000	10 to		MAG-HOA	115.3	2	58	Х	200	170	.04	.16	3500	TRANE PCC-07			 ,			
MUA-7			3300 3300	FC	0.5	1.1	980			MAG-HOA	158	2	58	11	200	170	.04	.16	3500	TRANE PCC-07						
MUA-8		BLDG "H"		FC	0.5	1.2	1132			MAG-HOA MAG-HOA	158 187	2	58	17	200	170	.04	.16	3500	TRANE PCC-07						
					5.5	L ''-	152			WAG TION	107		1 36	13	200	170	.04	.16	3500	TRANE PCC-07			,	-		5 5

	MAKE	-UP AIR UNIT SCHEDULE (DIRECT GAS F	TRED)	
	HEATING CAPACITY - GAS INPUT OUTPUT TEMP. MBH @ S.L. RISE	EVAPORATIVE COOLING SECTION CONDITIONS EVAP. EVAP. MAX. FACE PUMP MEDIA AIR A VELOCITY FPM FPM N. WELOCITY FPM N. MEDIA DEPTH IN. MEDIA DEPTH IN.	OP. MANUFACTURER WT. LBS.	NOTES
MUA-5 M-21 KITCHEN 10350 FC 2.2 7-1/2 460-3 INTEGRAL	718 460 74	91 62 63 90 600 1/4 115-1 12" 0.2	25 2800 ENGINEERED AIR HE 131Q	DIRECT GAS FIRED HEATING.

						R	DOF	TOP	HVA	AC UNIT	SCHED	ULE (GAS FII	RED H	TG./ C)X C	LG.)		· ·				
ITEM	DWG. NO.	SERVICE	CFM	SUPPLY MIN. OSA CFM	Y AIR FAN FAN TYPE	ESP IN. W.C.	RPM		PLY FAN	MOTOR DATA STRTR	CIDCUIT	HE FUEL TYPE		OUTPUT		COOLING EAT F		TY F COND. TEMP. F	OP. WT.	MANUFACTURER & MODEL NO.	NOTES		
RTU-1	1 M-2	RETAIL & OFFICE	850	180	FC	.37	1725	1/2	208-1	INT.	15.7	NAT	MBH @S.L. 50	MBH CALT.	18.8	91/62		105	LBS.	TRANE YCCO24F		,	

4	e e			BOI	LER S	SCH	IEDI	JLE	(H	OT W	ATER)	
ITEM	DWG. NO.	SERVICE	TYPE	INPUT MBH	ACITY OUTPUT MBH ALT.	EWT F	LWT F	GPM		OP. WT. LBS.	MANUFACTURER & MODEL NO.	NOTES
B-1	M-21	A, & E	CAST IRON	1690	1085	174	200	95	NG	5150	WEIL McLAIN LGB-14	30% PROP GLYCOL
B-2	M-21	A, & E	CAST IRON	1690	1085	174	200	95	NG		WEIL McLAIN LGB-14	
B-3	M-20	B, C, & D	CAST IRON	1820	1164	177	200	116	NG		WEIL McLAIN LGB-15	
B-4	M-20	B, C, & D	CAST IRON	1820	1164	177	200	116	NG		WEIL McLAIN LGB-15	
B-5	M-20	B, C, & D	CAST IRON	1820	1164	177	200	116	NG		WEIL McLAIN LGB-15	

		E	XPAN	SION	TANK	SCHEDU	JLE ([DIAPHRAGM	TYPE)
ITEM	DWG. NO.	SERVICE	VOL	UME	%	FILL PRESS	OP. WT.	MANUFACTURER	NOTES
	9		TANK	ACCEP- TANCE	GLYCOL PROPYLENE	PSI	LBS	& MODEL NO.	
ET-1	M - 21	B-1,2	119	119	30%	26	1300	AMTROL 500L	BLDGS "A" & "E"
ET-2	M-20	CH-1	10.5	4.65	30%	26	150	AMTROL AX40	BLDGS "B", "C", & "D"
ET-3	M-20	B-3,4,5	342	167	30%	24	4100	AMTROL 1400L	BLDGS "B", "C", & "D"
ET-4	M-21	CH-2	2.18	.63	30%	15	120	AMTROL AX15	BLDGS "A" & "E"

		,				×	P	JN	1P	SCH	IEDUL	E		·	
ITEM	DWG. NO.	TYPE	SERVICE	GPM	GLY.	TOTAL HEAD FT. W.C.	NPSH FT. W.C.	HP	RPM	MOTOR V-ø		op. Wt LBS.	MANUFACTURER & MODEL NO.	NOTES	CON- TROL
P-1	M - 21	BASE MTD.	CHILLED	130	30%	50	3.18	5	1750	460-3	MAG-HOA	350	B&G SERIES 1510 2-1/2AB	SERVES BLDGS A & F	***
P-2	M - 21	BASE MTD.	PRIM. HTG. WTR.	95	30%	50	4.2				MAG-HOA		B&G SERIES 1510 1-1/2BC		***
			PRIM. HTG. WTR.	95	30%	50	4.2	3	1750	460-3	MAG-HOA	205	B&G SERIES 1510 1-1/2BC		***
			PRIM. HTG. WTR.	210	30%	60	5	5	1750	460-3	MAG-HOA	350	B&G SERIES 1510 2BC	SERVES BLDGS B, C, & D	
			PRIM. HTG. WTR.	210	30%	60	5	5	1750	460-3	MAG-HOA	350	B&G SERIES 1510 2BC	SERVES BLDGS B, C, & D	
			B RECIRC	116	30%	20	3.9	1	1750	460-3	MAG-HOA	300	B&G SERIES 80 3x3x7B	SERVES BLDGS B, C, & D	
			B RECIRC	116	30%	20	3.9	1	1750	460-3	MAG-HOA	300	B&G SERIES 80 3x3x7B	SERVES BLDGS B, C, & D	***
			B RECIRC	116	30%	20	3.9	1	1750	460-3	MAG-HOA	300	B&G SERIES 80 3x3x7B	SERVES BLDGS B, C, & D	***
			B RECIRC	95	30%	20	3.7	1	1750	460-3	MAG-HOA	205	B&G SERIES 80 21/2×21/2×7	SERVES BLDGS A & E	***
			B RECIRC	95	30%	20.	3.7	1	1750	460-3	MAG-HOA	205		SERVES BLDGS A & E	***
		BASE MTD		115	30%	65	4.5	5	1750	460-3	MAG-HOA	205	B&G SERIES 1510 1-1/2BC	SERVES BLDGS B, C, & D	***
			DOM. WATER 110°	5.5	0%	8	_	1\12	1750	115-1	. —		B&G SERIES 100	SERVES BLDGS A & E	***
			DOM. WATER 140°		0%	4.0	_	1\12	1750	115-1		×	B&G SERIES 100	SERVES BLDGS A & E	***
		•	DOM. WATER	9.5	0%	6	_	1\12	1750	115-1	_		B&G SERIES 100	SERVES BLDGS B, C, & D	***
			DOM. WATER	3.5	0%	5	_	1\12	1750	115-1	_		B&G SERIES 100	SERVES BLDG H	***
			DOM. WATER	3.0	0%	3.0	_	1\12	1750	115-1	_		B&G SERIES 100	SERVES BLDG G	***
			DOM. WATER	4.0	0%	8				115-1		N er	B&G SERIES 100	SERVES BLDG F	***
			FIRE PUMP			47 PSI		75	1750	460-3	*			**	***
FP-2	M - 20	IN-LINE	JOCKEY FP	15	0%	52 PSI	_	3	1750	4603	*		_	**	***

* STARTER INTEGRAL WITH PUMP CONTROLLER ** CONTRACTOR RESPONSIBLE FOR ACTUAL PUMP SELECTION, HP LISTED ARE MAX. ALLOWED. *** SEE SECTION 15900

,1 *				WATE	RH	EA	TER	SCH	EDUL	E (GA	S FIRED)	6
ITEM	DWG.			RECOVERY	TEMP.		CIRCUL	ATING PUM	P	v .	MANUFACTURER	NOTES
	NO.	GAL.	MBH INPUT S.L.	GPH	RISE F	HP	GPM	VOLT-Ø	FT. HEAD	WEIGHT	& MODEL NO.	R
GWH-1/ST-1	M-20	700	2065	2035	100	1/2	90	115-1	15	1376/9531	LOCHINVAR CWN 2065	BLDB B,C & D
GWH-2	M - 21	700	2065	2035	100	1/2	90	115-1	15	10907	LOCHINVAR PTN-2065-700-T-H-J	

		· · · · · · · · · · · · · · · · · · ·			FXH	ALIS	TF	ΔΝ	<u> </u>	CHI	EDUL	F			
ITEM	DWG.	TYPE	AREA SERVED	CFM		DRIVE	SONES		MO	OR D	ATA	OP. WT.	MANUFACTURER & MODEL NO.		NOTES
			,					HP	RPM	V-ø	STRTR	LBS.	& MODEL NO.		,
			"B" PLAZA LVL	950	0.5	BELT	4.7	1/4	875	115-1		60.	GREENHECK CSP-	-160A	*
		UPBLAST	BLDG. "A"	3,000	0.5	BELT							GREENHECK CUBE		* RUNS CONTINUOUSLY
		DOME	BLDG. "B"	3,600	0.5	BELT	14.0	3/4	1055	460-3	MAG-HOA	100	GREENHECK GB-	180	* RUNS CONTINUOUSLY
	M-13		BLDG. "C"	3,600	0.5	BELT	14.0	3/4	1055	460-3	MAG-HOA	100	GREENHECK GB-	180	* RUNS CONTINUOUSLY
	M-17		BLDG. "D"	2,400	0.5	BELT	12.5	1/2	1028	115-1		90	GREENHECK GB-	160	* RUNS CONTINUOUSLY
Committee of the Committee of	M-19		TOILETS "E"	1020	0.375	BELT	8.7	1/4	1490	115-1	-	50	GREENHECK GB-	100	*
		UPBLAST	SERVERY HOOD	1500	1.5	BELT	12.3	3/4	1440	460-3	MAG-HOA	70	GREENHECK CUBE	160HP	*
		UPBLAST	SERVERY HOODS	7000	2.25	BELT	26	5	1010	460-3	MAG-HOA	230	GREENHECK CUBE	300HP	*
		UPBLAST	KITCHEN HOOD	5400	2	BELT	22	- 3	1200	460-3	MAG-HOA	150	GREENHECK CUBE	240HP	*
			KITCHEN HOOD	4000	1.5	BELT	17.4	2	1015	460-3	MAG-HOA	150	GREENHECK CUBE	220HP	*
		UPBLAST	KITCHEN HOOD	3000	2	BELT	19.75	2	1545	460-3	MAG-HOA	100	GREENHECK CUBE	180HP	*
F-12	M-21		TOILETS (KIT)	850	.625	BELT	8.2	1/4	1535	115-1		50	GREENHECK GB 1	00	*
F-13	M -19	UPBLAST	PANTRY W/ BACKDRAFT DAMPER	900	.375	BELT	7.1	1/4	1045	115–1		60	GREENHECK CUBE	120	* LINE VOLTAGE WALL SWITCH
		WALL PROP	FIRE PUMP	2500	.5	BELT		3/4	2155	460-3	MAG-HOA	110	GREENHECK TAB-	-18M	*
-15	M-20	IN-LINE (CLG)	LAUNDRY	2400	.625	BELT	18				MAG-HOA	,	GREENHECK BSQ-		*
-16	M-10	IN-LINE (CLG)	ELEC-C107	1065	.5	BELT	12.8	818 W	1610	115-1	_		GREENHECK SP 1		* INTEGRAL GRILLE-8.6 AMPS
			DISH HOOD W/ BACKDRAFT DAMPER	750	.625	BELT	11,1	1/4	1295	115–1		60	GREENHECK CUBE	140HP	LINE VOLT WALL SWITCH
			BLDG. "C" FLUE	- -	_	- .		350W	1600	115-1		90	EXHAUSTO		TYP. 2 FANS MOUNTED TOGETHER PACKAGED CONTROL
	M-31	N N N N N N N N N N N N N N N N N N N	BUILDING F	3300	.625	BELT	11.4	3/4	860	460-3	MAG-HOA		GREENHECK CUBE	200	The second secon
	M - 34		BUILDING G	3300	.625	BELT	11.	3/4	860	460-3	MAG-HOA		GREENHECK CUBE		
-21	M-37	UPBLAST	BUILDING H	3900	.625	BELT	13.1	1	930	460-3	MAG-HOA		GREENHECK CUBE		

* SEE SECTION 15900

					HOOD	SCHE	DULE			
TEM	DWG. NO.	SERVICE	CFM	S.P. LOSS IN.	THROAT SIZE IN.	HOOD SIZE IN.	MANUFACTURER & MODEL NO.		NOTES	
H-1	M-19	RELIEF	4250	.05	24 X 48	42 X 77	PENN AIRETTE	a .	BUILDING E BANQUET	
-1	M-21	COMB AIR		.05	30 X 48	50 X 80	PENN AIRETTE			
	5		39						5	
	*									

GENERAL NOTES:

- 1. HEAVY LINE WEIGHT INDICATES NEW EQUIPMENT IN PHASE II
- 2. LIGHT LINE WEIGHT INDICATES EQUIPMENT SPECIFIED IN PHASE I

AS BUILT DRAWING BACKGROUND FOR REFERENCE ONLY

POST BID ADDENDUM NO. 3 TO BID PACKAGE NO. 6 SHEET OF

	u u					HO	Γ۷	VAT	ER	COIL	SCH	IEDI	JLE		
ITEM	DWG.	CFM	MAX. FACE			Ļ.Ą.T.	HEA	TING V	VATER	MAX.	ΔΡ	QP.	COILS	MANUFACTURER	NOTES
	NO.	a	VELOCITY FPM	МВН	DB	(F) DB	GPM	E.W.T. (°F)	L.W.T. (°F)	AIR (IN W.C.)	WATER (FT. W.C.)	WT. LBS.	#-SIZE (LxH)	& MODEL NO.	9
HC-1	M-10	1200	900	43.2	55	91	4.6	200	180	.02	.11	85	24x12	TRANE TYPE WC	
HC-2	M-10	2400	900	86.4	55	90	9.5	200	180	.02	.15	130	28×18	TRANE TYPE WC	
HC-3	M-10	1400	900	50.4	55	96	6.6	200	180	.02	.52	85	24x12	TRANE TYPE WC	
HC-4	M-18	1500	900	51.5	55	95	6.8	200	180	.02	.53	85	24x12	TRANE TYPE WC	

							V	VALL	FIN	1 F	ADIA	ATIOI	N SCHEDULE	
	ITEM			BTUH/LF (DERATED)*		LWT F	TUBE	TING ELE FINS PER FT.	ROWS			FIN SIZE IN.	MANUFACTURER & MODEL NO.	NOTES *BTUH DERATED FOR VELOCITY, GLYCOL, ALTITUDE.
	3BR-1	VARIES	850	600	200	180	3/4"	50	1	3/4"	3/4"	314"	STERLING LB2	
	3BR-2	M-19	850	600	200	180	3/4"	50	1	3/4"	3/4"	31/4"	STERLING LB2	
1	3BR-3	M-19	990	700	200	180	3/4"	40	1	3/4"	3/4"	4 ¹ / ₄ x 3 ⁵ / ₈ "	STERLING VERSA LINE STYLE SS	
	3BR-4	M-19	850	600	200	180	3/4"	50	1	3/4"	3/4"	31/4"	STERLING LB2	

			CA	BIN	ET,	/U	NIT	T H	EA ⁻	ΓEF	?	SCHED	ULE	<u> </u>	TOF	WA	TER)	
ITEM	DWG.	SERVICE	TYPE	CFM	WATER					A	IR	MOTOR	MOTOR DATA		RUNOUT SIZES		MANUFACTURER	NOTES
	NO.		3 9 B	2 u	EWT F	LWT F	GPM	GLY.	PD FEET	EAT	LAT F	HP (or AMPS)		RPM	HWS	HWR	& MODEL NO.	
JH-1		,																NOT USED
JH-2			e e															NOT USED
JH-3	M - 21	MECH E212	HOR.	2400	200	170	5.9	30%	1.20	60	94	1/4	115-1	1140	1"	1"	KINGSTON 134ER-18	3
		RC'V E215		2400					1.20	60	94	1/4		1140	1"	1"	KINGSTON 134ER-18	6
		LOAD D		1450					0.38		96	,	115-1	ar more more man		3/4"	KINGSTON 88ER-14	
		RC'V D		1450	Secretary Commence of the State	second proposition			0.38		96	1/8	115-1	COLUMN TO THE PROPERTY OF THE PARTY OF THE P	3/4"		KINGSTON 88ER-14	
		STORAGE		1450					0.38		96		115-1	1	3/4"		KINGSTON 88ER-14	
		MECH E222		1450					0.38		96	1/8	115-1		3/4"	3/4"	KINGSTON 88ER-14	
		FP ROOM		2400				30%	1.20		94	1/4	115-1		1"	1"	KINGSTON 134ER-18	
		MECH C108		2400				30%	1.20		94	1/4	115-1		1"	1"	KINGSTON 134ER-18	
		MECH C107		2400				30%	1.20		94	1/4	115-1		1"	1"	KINGSTON 134ER-18	
JH-12	M-20	MECH C106	HOR.	2400	200	170	5.9	30%	1.20	60	94	1/4	115-1	1140	1"	1"	KINGSTON 134ER-18	3
UH-1	M-3	FOYER AP	WALL		200	170	1	30%	0.22			0.55A	115-1	2800	3/4"	3/4"	KINGSTON TRW-14	INTEGRAL T'ST
UH-2	M-4	FOYER A2	WALL		200	170	1	30%	0.22			0.55A	115-1	2800	3/4"	3/4"	KINGSTON TRW-14	INTEGRAL T'ST
:UH-3	M-5	FOYER A3	WALL		200	170	1	30%	0.22			0.55A	115-1	2800	3/4"	3/4"	KINGSTON TRW-14	INTEGRAL T'ST
UH-4	M-6	FOYER B103	WALL		200	170	1	30%	0.22			0.55A	115-1	2800	3/4"	3/4"	KINGSTON TRW-14	INTEGRAL T'ST
UH-5	M-7	VEST. B209	WALL		200	170	1	30%	0.22			0.55A	115-1	2800	3/4"	3/4"	KINGSTON TRW-14	INTEGRAL T'ST
UH-6	M-10	VEST, C103	WALL		200	170	1	30%	0.22			0.55A	115-1	2800	3/4"	3/4"	KINGSTON TRW-14	INTEGRAL T'ST
:UH-7	M-14	VEST. D103	WALL		200	170	1	30%	0.22			0.55A	115-1	2800	3/4"	3/4"	KINGSTON TRW-14	INTEGRAL T'ST
UH-8	M-18	VEST. KIT	WALL		200	170	1	30%	0.22			0.55A	115-1	2800	3/4"	3/4"	KINGSTON TRW-14	INTEGRAL T'ST
UH-9	M-18	FOYER KIT	WALL		200	170	1	30%	0.22			0.55A	115 - 1	2800	3/4"	3/4"	KINGSTON TRW-14	INTEGRAL T'ST
UH-10	M-7	CORR B203	WALL		200	170	1	30%	0.22			0.55A	115-1	2800	3/4"	3/4"	KINGSTON TRW-14	INTEGRAL T'ST
UH-11	M-8	CORR B303	WALL		200	170	1	30%	0.22			0.55A	115-1	2800	3/4"	3/4"	KINGSTON TRW-14	INTEGRAL T'ST
UH-12	M - 9	CORR B403	WALL		200	170	1	30%	0.22			0.55A	115-1	2800	3/4"	3/4"	KINGSTON TRW-14	INTEGRAL T'ST
:UH-13	M - 13	CORR C403	WALL		200	170	1	30%	0.22			0.55A	115-1	2800	3/4"	3/4"	KINGSTON TRW-14	INTEGRAL T'ST
UH-14	M-11	CORR C203	WALL	y.	200	170	1	30%	0.22			0.55A	115 - 1	2800	3/4"	3/4"	KINGSTON TRW-14	INTEGRAL T'ST
UH-15	M-12	CORR C303	WALL		200	170	1	30%	0.22			0.55A	115-1	2800	3/4"	3/4"	KINGSTON TRW-14	INTEGRAL T'ST
UH-16	M-19	MNTR E201	CLG	200	200	170	1	30%	3.9			0.55A	115-1	_	3/4"	3/4"	TRANE FFCB020	INTEGRAL T'ST
UH-17	M-15	FOYER D203	WALL		200	170	1	30%	0.22			0.55A	115-1	2800	3/4"	3/4"	KINGSTON TRW-14	INTEGRAL T'ST
UH-18	M-16	FOYER D303	WALL		200	170	1	30%	0.22	.,		0.55A	115-1	2800	3/4"	3/4"	KINGSTON TRW-14	INTEGRAL T'ST
UH-19	M-17	FOYER D403	WALL	× ,	200	170	1	30%	0.22			0.55A	115-1	2800	3/4"	3/4"	KINGSTON TRW-14	INTEGRAL T'ST
UH-20	M-3	STAIRS A101	WALL		200	170	1	30%	0.22			0.55A	115-1	2800	3/4"	3/4"	KINGSTON TRW-14	INTEGRAL T'ST
UH-21	M-6	STAIRS B101	WALL		200	170	1	30%	0.22			0.55A	115-1	2800	3/4"	3/4"	KINGSTON TRW-14	INTEGRAL T'ST
UH-22	M-16	STAIRS C101	WALL		200	170	1	30%	0.22			0.55A	115-1	2800	3/4"	3/4"	KINGSTON TRW-14	INTEGRAL T'ST
UH-23	M - 14	DINING E109	WALL		200	170	1	30%	0.22			0.55A	115-1	2800	3/4"	3/4"	KINGSTON TRW-14	INTEGRAL T'ST
UH-24	M-18	STAIRS 101	CONC	375	200	170	1	30%	1.1	,		1.6A	115-1	1070	3/4"	3/4"	TRANE FFCB040	REMOTE T-ST
UH-25		STAIRS F101	SURF.		200	170	1	30%	0.22			0.55A	115-1	2800	3/4"	3/4"	KINGSTON TRW-14	INTEGRAL T'ST
UH-26	*	VEST. F108	WALL		200	170	1	30%	0.22			0.55A	115-1	2800	3/4"	3/4"	KINGSTON TRW-14	INTEGRAL T'ST
UH-27	1	VEST. F208	WALL		200	170	1	30%	0.22			0.55A	115-1	2800	3/4"	3/4"	KINGSTON TRW-14	INTEGRAL T'ST
UH-28	3	VEST. F308	WALL		200	170	1	30%	0.22			0.55A	115-1	2800	3/4"	3/4"	KINGSTON TRW-14	INTEGRAL T'ST
UH-29	8	STAIRS G101	SURF.		200	170	1	30%	0.22			0.55A	115-1	2800	3/4"	3/4"	KINGSTON TRW-14	INTEGRAL T'ST
:UH-30	7	VEST. G108	WALL		200	170	1	30%	0.22			0.55A	115-1	2800	3/4"	3/4"	KINGSTON TRW-14	INTEGRAL T'ST
UH-31		VEST. G208	WALL		200	170	1	30%	0.22			0.55A	115-1	2800	3/4"	3/4"	KINGSTON TRW-14	INTEGRAL T'ST
UH-32	4	VEST. G308	WALL	11	200	170	1	30%	0.22	ĺ		0.55A	115-1	2800	3/4"	3/4"	KINGSTON TRW-14	INTEGRAL T'ST
UH-33	\$	STAIRS H101	SURF.	•	200	170	1	30%	0.22			0.55A	115-1	2800	3/4"	3/4"	KINGSTON TRW-14	INTEGRAL T'ST
UH-34	4	VEST. H108	WALL		200				0.22				115-1				KINGSTON TRW-14	INTEGRAL T'ST
UH-35		VEST. H208			200				0.22				115-1				KINGSTON TRW-14	INTEGRAL T'ST
UH-36		VEST. H308			200				0.22				115-1				KINGSTON TRW-14	INTEGRAL T'ST

	*		STAT	IONA	RY LO	OUVER	SCHEDUL	_E _	
ITEM	DWG. NO.	SERVICE	CFM		VELOCITY FPM	MINIMUM FREE AREA SQ FT	LOUVER SIZE IN. W x IN. H	MANUFACTURER & MODEL NO.	NOTES
SL-1	M-6	EXHAUST	950	.06	525	1.6	24x36	AMERICAN WARMING LF-47	μ* n
SL-2	M-10	EXHAUST	1065	.08	525	2	36x24	AMERICAN WARMING LF-47	
SL-3	M-20	O.A. INTAKE	11140	.06	525	21	76x92	AMERICAN WARMING LF-47	,
SL-4	M-20	O.A. INTAKE	5000	.06	525	9.5	48×60	AMERICAN WARMING LF-47	
SL-5	M-20	EXHAUST	2400	.06	525	6	36x48	AMERICAN WARMING LF-47	
SL-6	M - 20	COMBUSTION AIR	8500	.08	600	13	60x72	AMERICAN WARMING LF-47	
SL-7	M - 20	COMBUSTION AIR	8500	.08	600	13	60x72	AMERICAN WARMING LF-47	
SL-8	M - 20	O.A. INTAKE	2500	.08	525	4.5	36×42	AMERICAN WARMING LF-47	
SL-9	M - 20	EXHAUST	2500	.08	700	3.8	36×36	AMERICAN WARMING LF-47	*
SL-10	M-20	O.A. INTAKE	6900	.06	525	13.1	60×72	AMERICAN WARMING LF-47	
SL-11			٨		2				NOT USED
SL-12	M-21	COMBUSTION AIR	5680	.08	600	9.45 TOTAL	(4) 48×48	AMERICAN WARMING LF-47	
SL-13	M-21	O.A. INTAKE	15400	.08	600	25.7 TOTAL	(4) 48×48	AMERICAN WARMING LF-47	
SL-14	M-21	O.A. INTAKE	15400	.08	600	25.7 TOTAL	(4) 48×48	AMERICAN WARMING LF-47	
SL-15	M-20	O.A. INTAKE	1065	.08	600	1.8	24×36	AMERICAN WARMING LF-47	
SL-16	M-19	RELIEF	2500 EA	.02	325	8.45 EA.	96x32	AMERICAN WARMING LF-47	
SL-17	M-17	ELEVATOR VENT	_	.02	_	3	48×24	AMERICAN WARMING LF-47	NEED TC DAMPER FOR LOUVER
SL-18			9				x at	9	NOT USED
SL-19	M-14	RELIEF BLDG. "D"	5000	.02	300	17.07	72×72	AMERICAN WARMING LF-47	
SL-20	M-17	ELEVATOR VENT	_	.02	_	3	48×24	AMERICAN WARMING LF-47	NEED TO DAMPER FOR LOUVER
8					u.				

CAMPUS HOUSING VILLAGE - PHASE I

McFall-Konkel & Kimball
Congulting Engineers Inc.

Architects
Architects

22 NORTH TEJON STREET

ACCHORADO SPRINGS, COLORADO 80903

SCHEDULES

AS BUILT DRAWING
BACKGROUND FOR
REFERENCE ONLY

JOB NO. 8765
DATE 01-15-96
SCALE NO SCALE:
DRAWN AEA
CHECKED SDM