

ARCHITECTURAL / ENGINEERING TEAM

ARCHITECTURE  
CSNA Architects  
532 N. Tejon Street  
Colorado Springs, Colorado 80903  
(719) 473-7225  
contact: Mr. John Goodloe, AIA

STRUCTURAL ENGINEERS  
HCDA Engineering  
545 E. Pikes Peak, Suite 100  
Colorado Springs, Colorado 80903  
(719) 633-7784  
contact: Mr. Andrew Baturevich, P.E.

MECHANICAL ENGINEERS  
AE Associates  
398 Fillmore, Suite 200  
Colorado Springs, Colorado 80907  
(719) 262-9430  
contact: Mr. Rod McCoy, P.E.

ELECTRICAL ENGINEERS  
Red Rock Consulting Engineers  
144 Palisade Circle  
Manitou Springs, Colorado 80829  
(719) 685-1266  
contact: Mr. Jeff Tanner, P.E.

CONSTRUCTION MANAGER/GENERAL CONTRACTOR


Bryan Construction, Inc.  
7025 Campus Drive  
Colorado Springs, Colorado 80920  
(719) 632-5355  
contact: Mr. Brian Burns

# COLORADO SPRINGS EXPO CENTER


## COLORADO SPRINGS, COLORADO

# INTERIOR RENOVATION CONSTRUCTION & PERMIT PACKAGE


JUNE 6, 2011

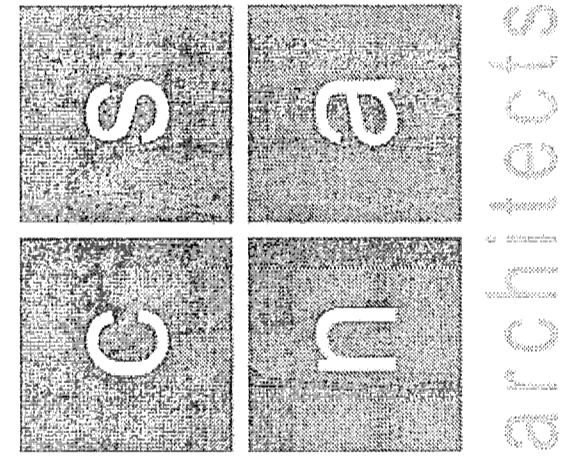

VICINITY MAP

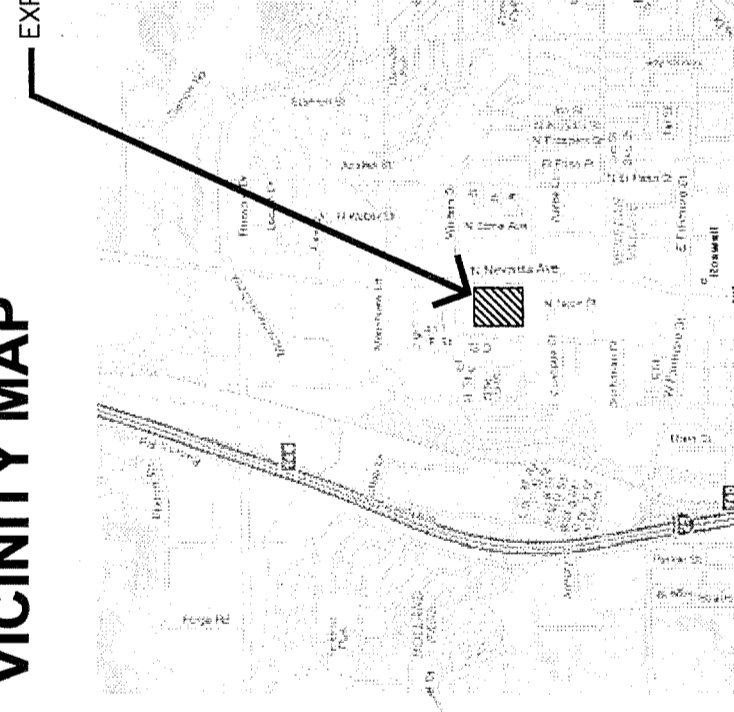

EXPO LOCATION

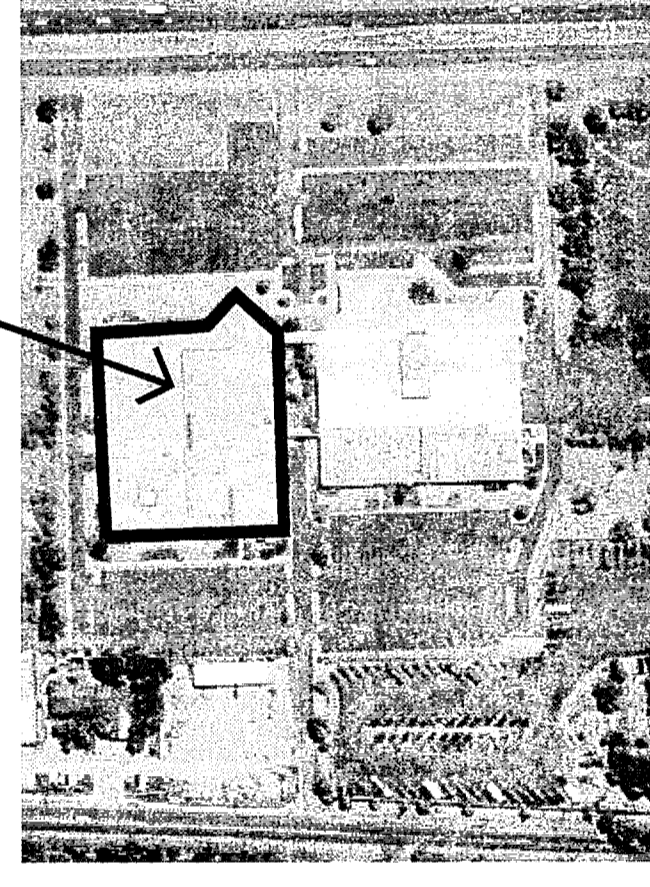

### INDEX TO DRAWINGS

- COVER SHEET
- ARCHITECTURAL
  - CA1.00 LIFE SAFETY PLAN & CODE ANALYSIS
  - A1.00 SITE PLAN
  - A1.01 SITE DETAILS & PARTITION TYPES
  - D1.00 DEMOLITION PLAN
  - A2.00 FLOOR PLAN
  - A2.01 CEILING PLAN
  - A4.00 DOOR SCHEDULE, TYPES, & HARDWARE
  - A4.01 ENLARGED PLANS & INTERIOR ELEVATIONS
- STRUCTURAL
  - S1.0 STRUCTURAL DETAILS & GENERAL NOTES
  - S2.0 ROOF FRAMING PLAN
- MECHANICAL & PLUMBING
  - M0.1 MECHANICAL NOTES & LEGENDS
  - M0.2 MECHANICAL SCHEDULES
  - M0.3 MECHANICAL DIAGRAMS
  - M2.1 MECHANICAL HVAC PLAN - NORTH
  - M2.2 MECHANICAL HVAC PLAN - SOUTH
  - M2.3 MECHANICAL ROOF PLAN
  - P0.1 PLUMBING NOTES & LEGENDS
  - P2.1 PLUMBING PLAN - NORTH
  - P2.2 PLUMBING PLAN - SOUTH
  - P3.1 PLUMBING ENLARGED PLANS
- ELECTRICAL
  - E1.00 ELECTRICAL LIGHTING PLAN
  - E2.00 ELECTRICAL POWER PLAN
  - E3.00 ELECTRICAL FIRE ALARM & ROOF PLAN
  - E4.00 ELECTRICAL SCHEDULES
  - E5.00 ELECTRICAL ONE LINE DIAGRAM
  - E6.00 ELECTRICAL SCHEDULES

### ARCHITECTURAL SYMBOLS

- GRID LINE
- REFERENCE NUMBER
- ENLARGED PLAN
- WALL SECTION
- ELEVATION
- INTERIOR ELEVATION
- DETAIL BUBBLE
- DOOR NUMBER
- ROOM NUMBER
- WINDOW TYPE
- ELEVATION REFERENCE
- PARTITION TYPE TAG
- FLOOR PLAN FLAG NOTE
- CEILING TYPE NOTE
- ELEVATION OR SECTION KEY NOTE

AS NOTED










COLORADO SPRINGS EXPO CENTER  
3650 NORTH NEVADA AVE. BUILDING RENOVATION  
COLORADO SPRINGS, CO

REVISIONS





CEILING PLAN

JOB NO.: 1100611  
DATE: 06/06/2011  
SCALE: AS NOTED  
DRAWN: JFC  
CHECKED: GMF  
A2.01  
SHEET

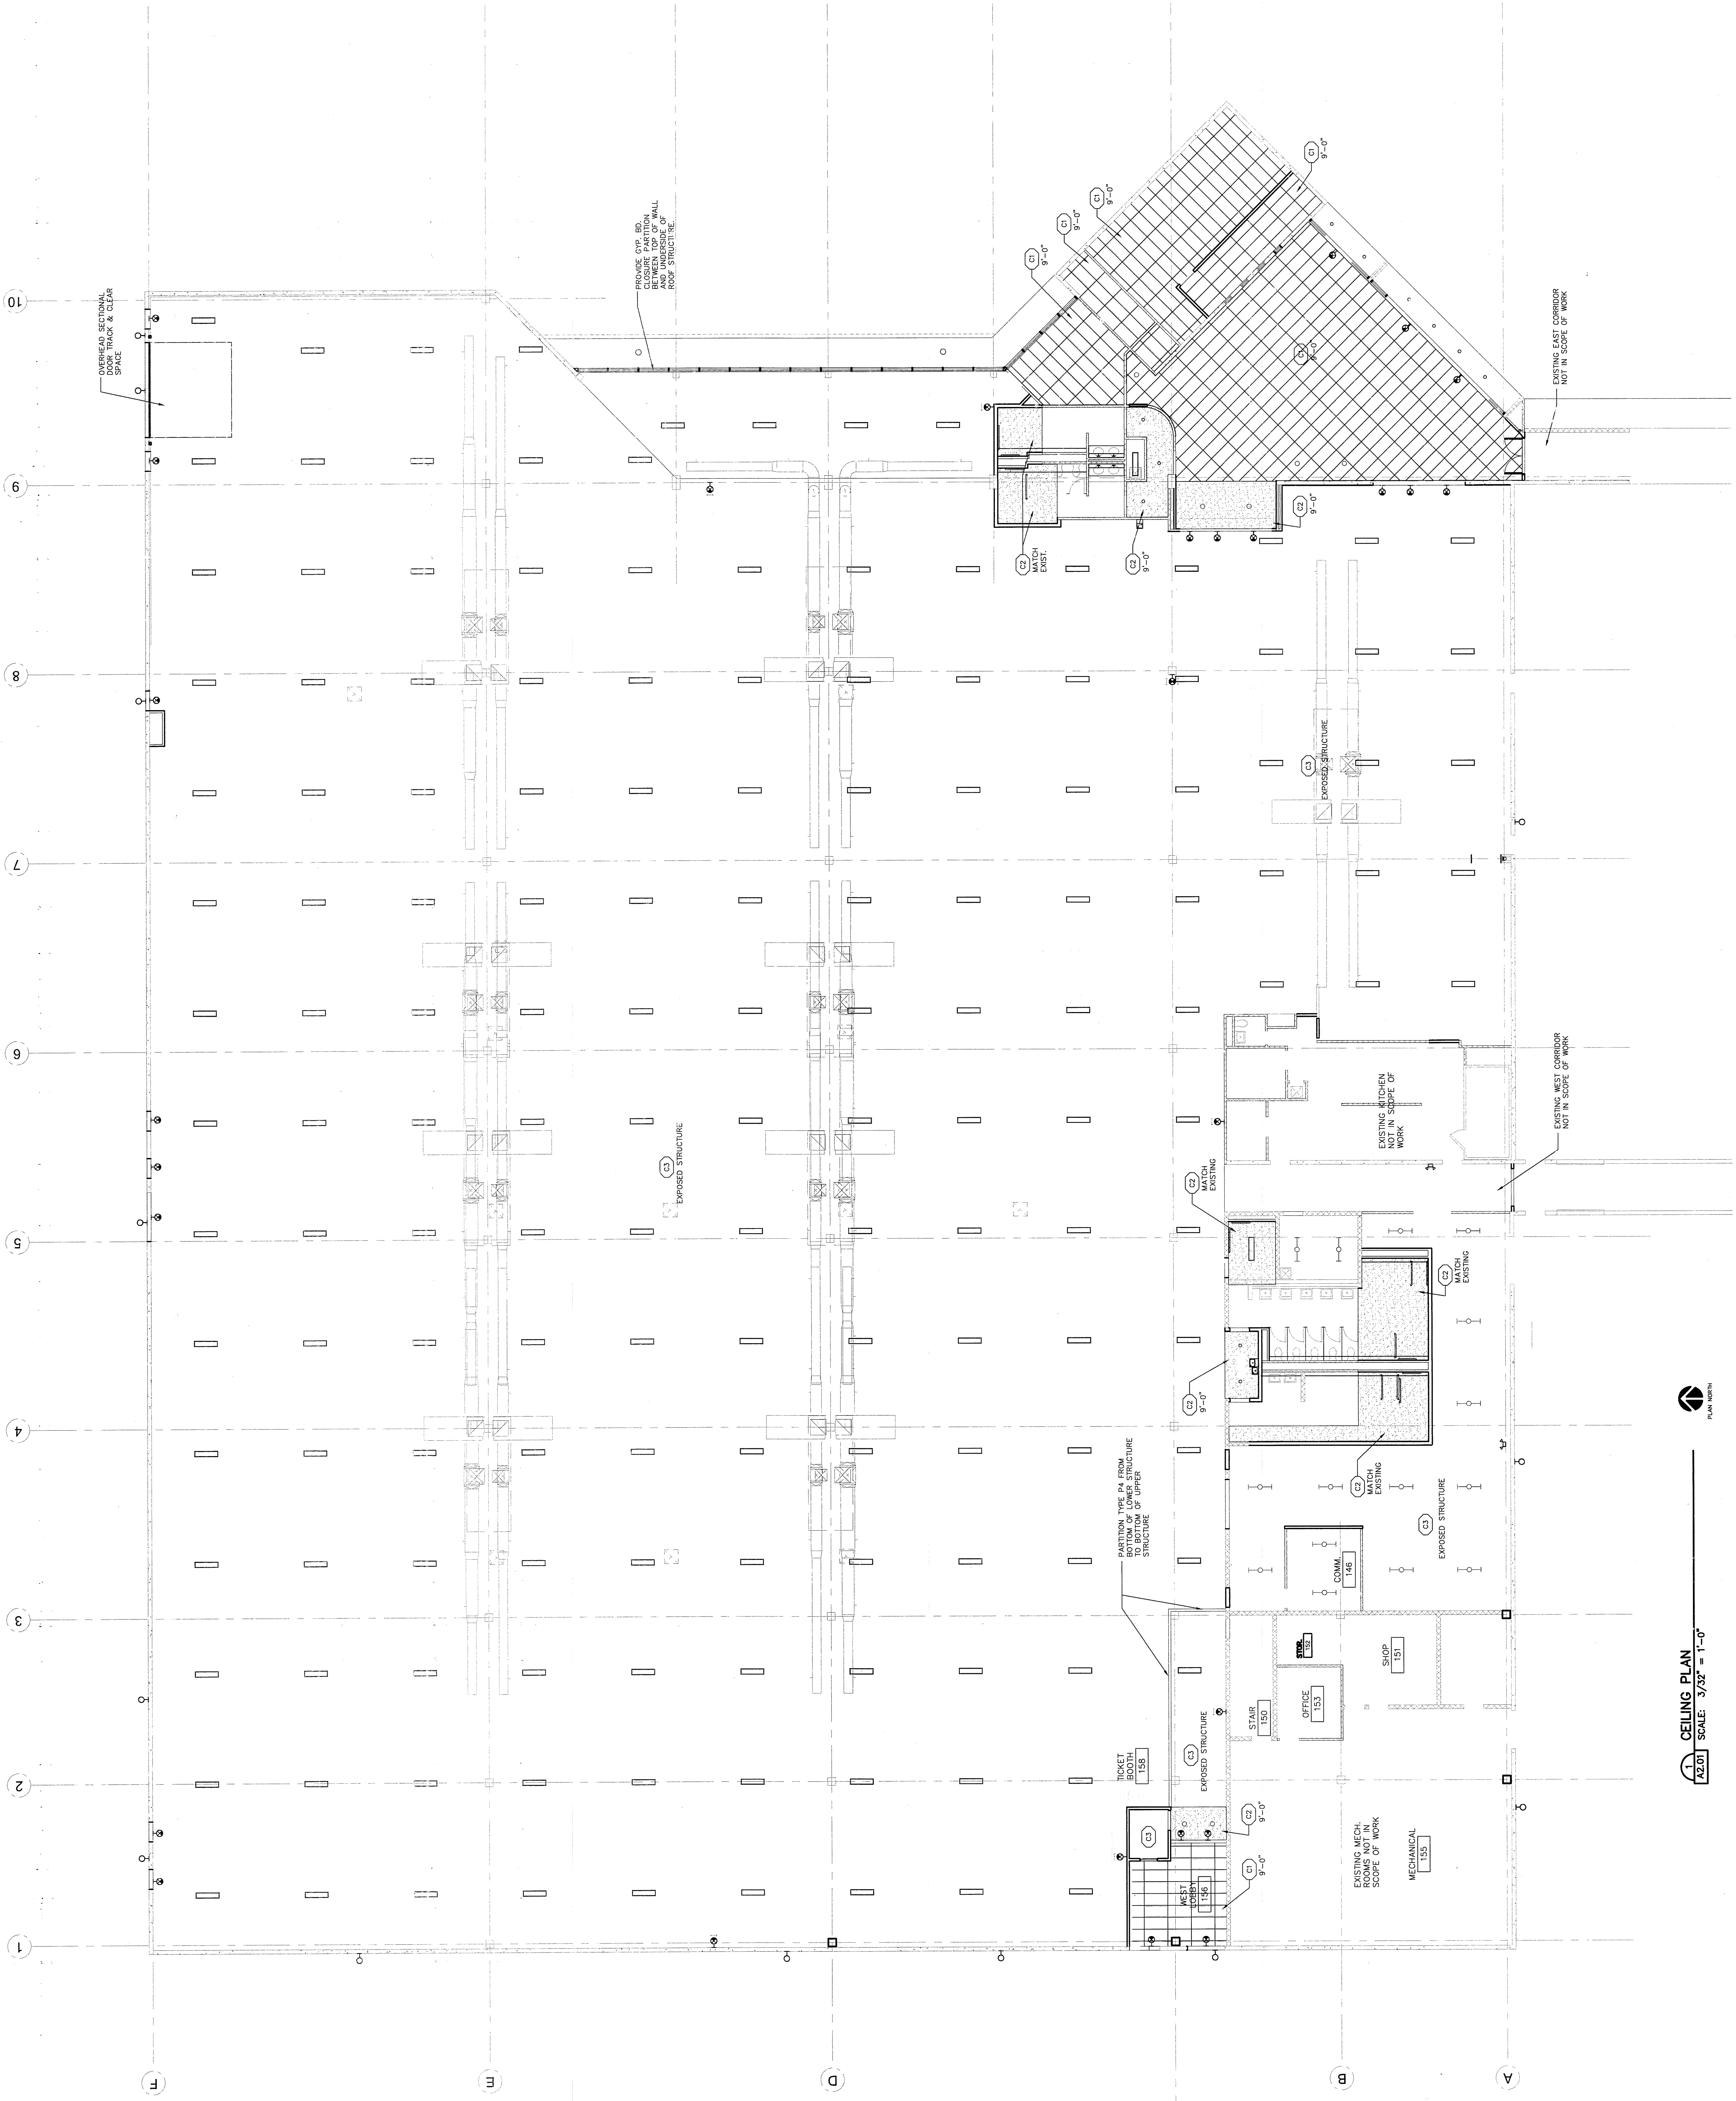

1.1 CEILING PLAN  
A2.01 SCALE: 3/32" = 1'-0"  
PLAN NORTH






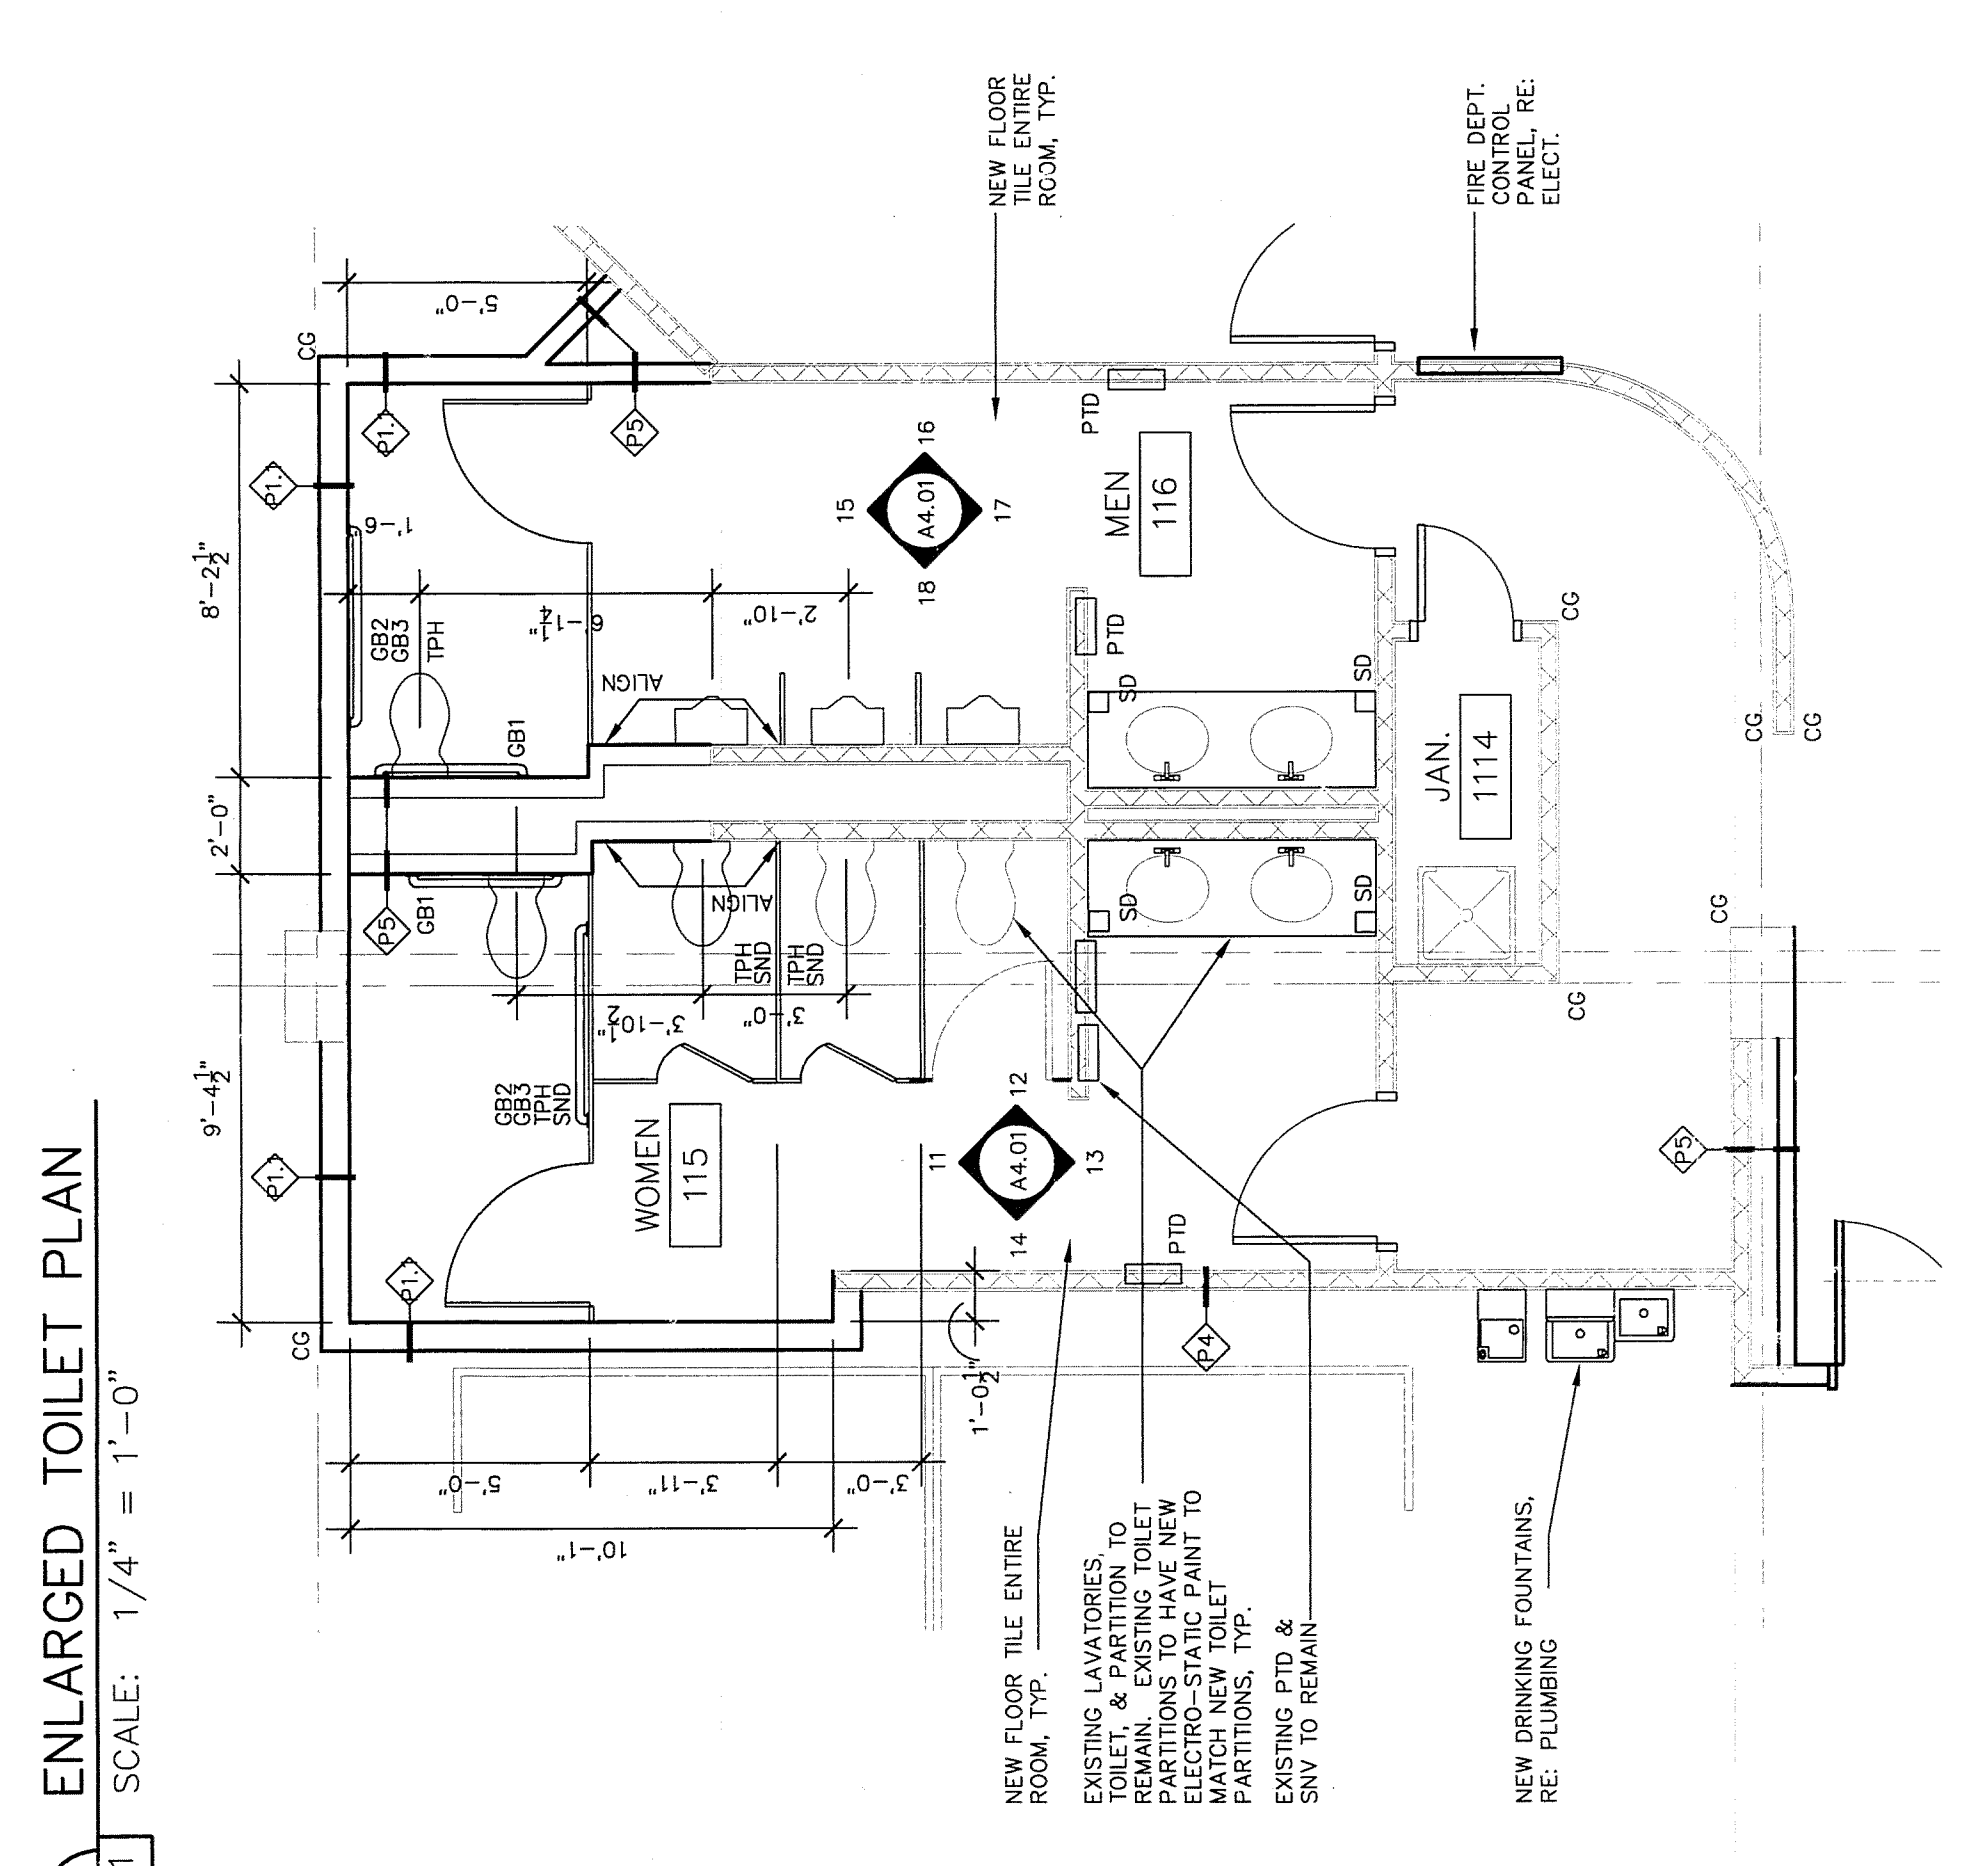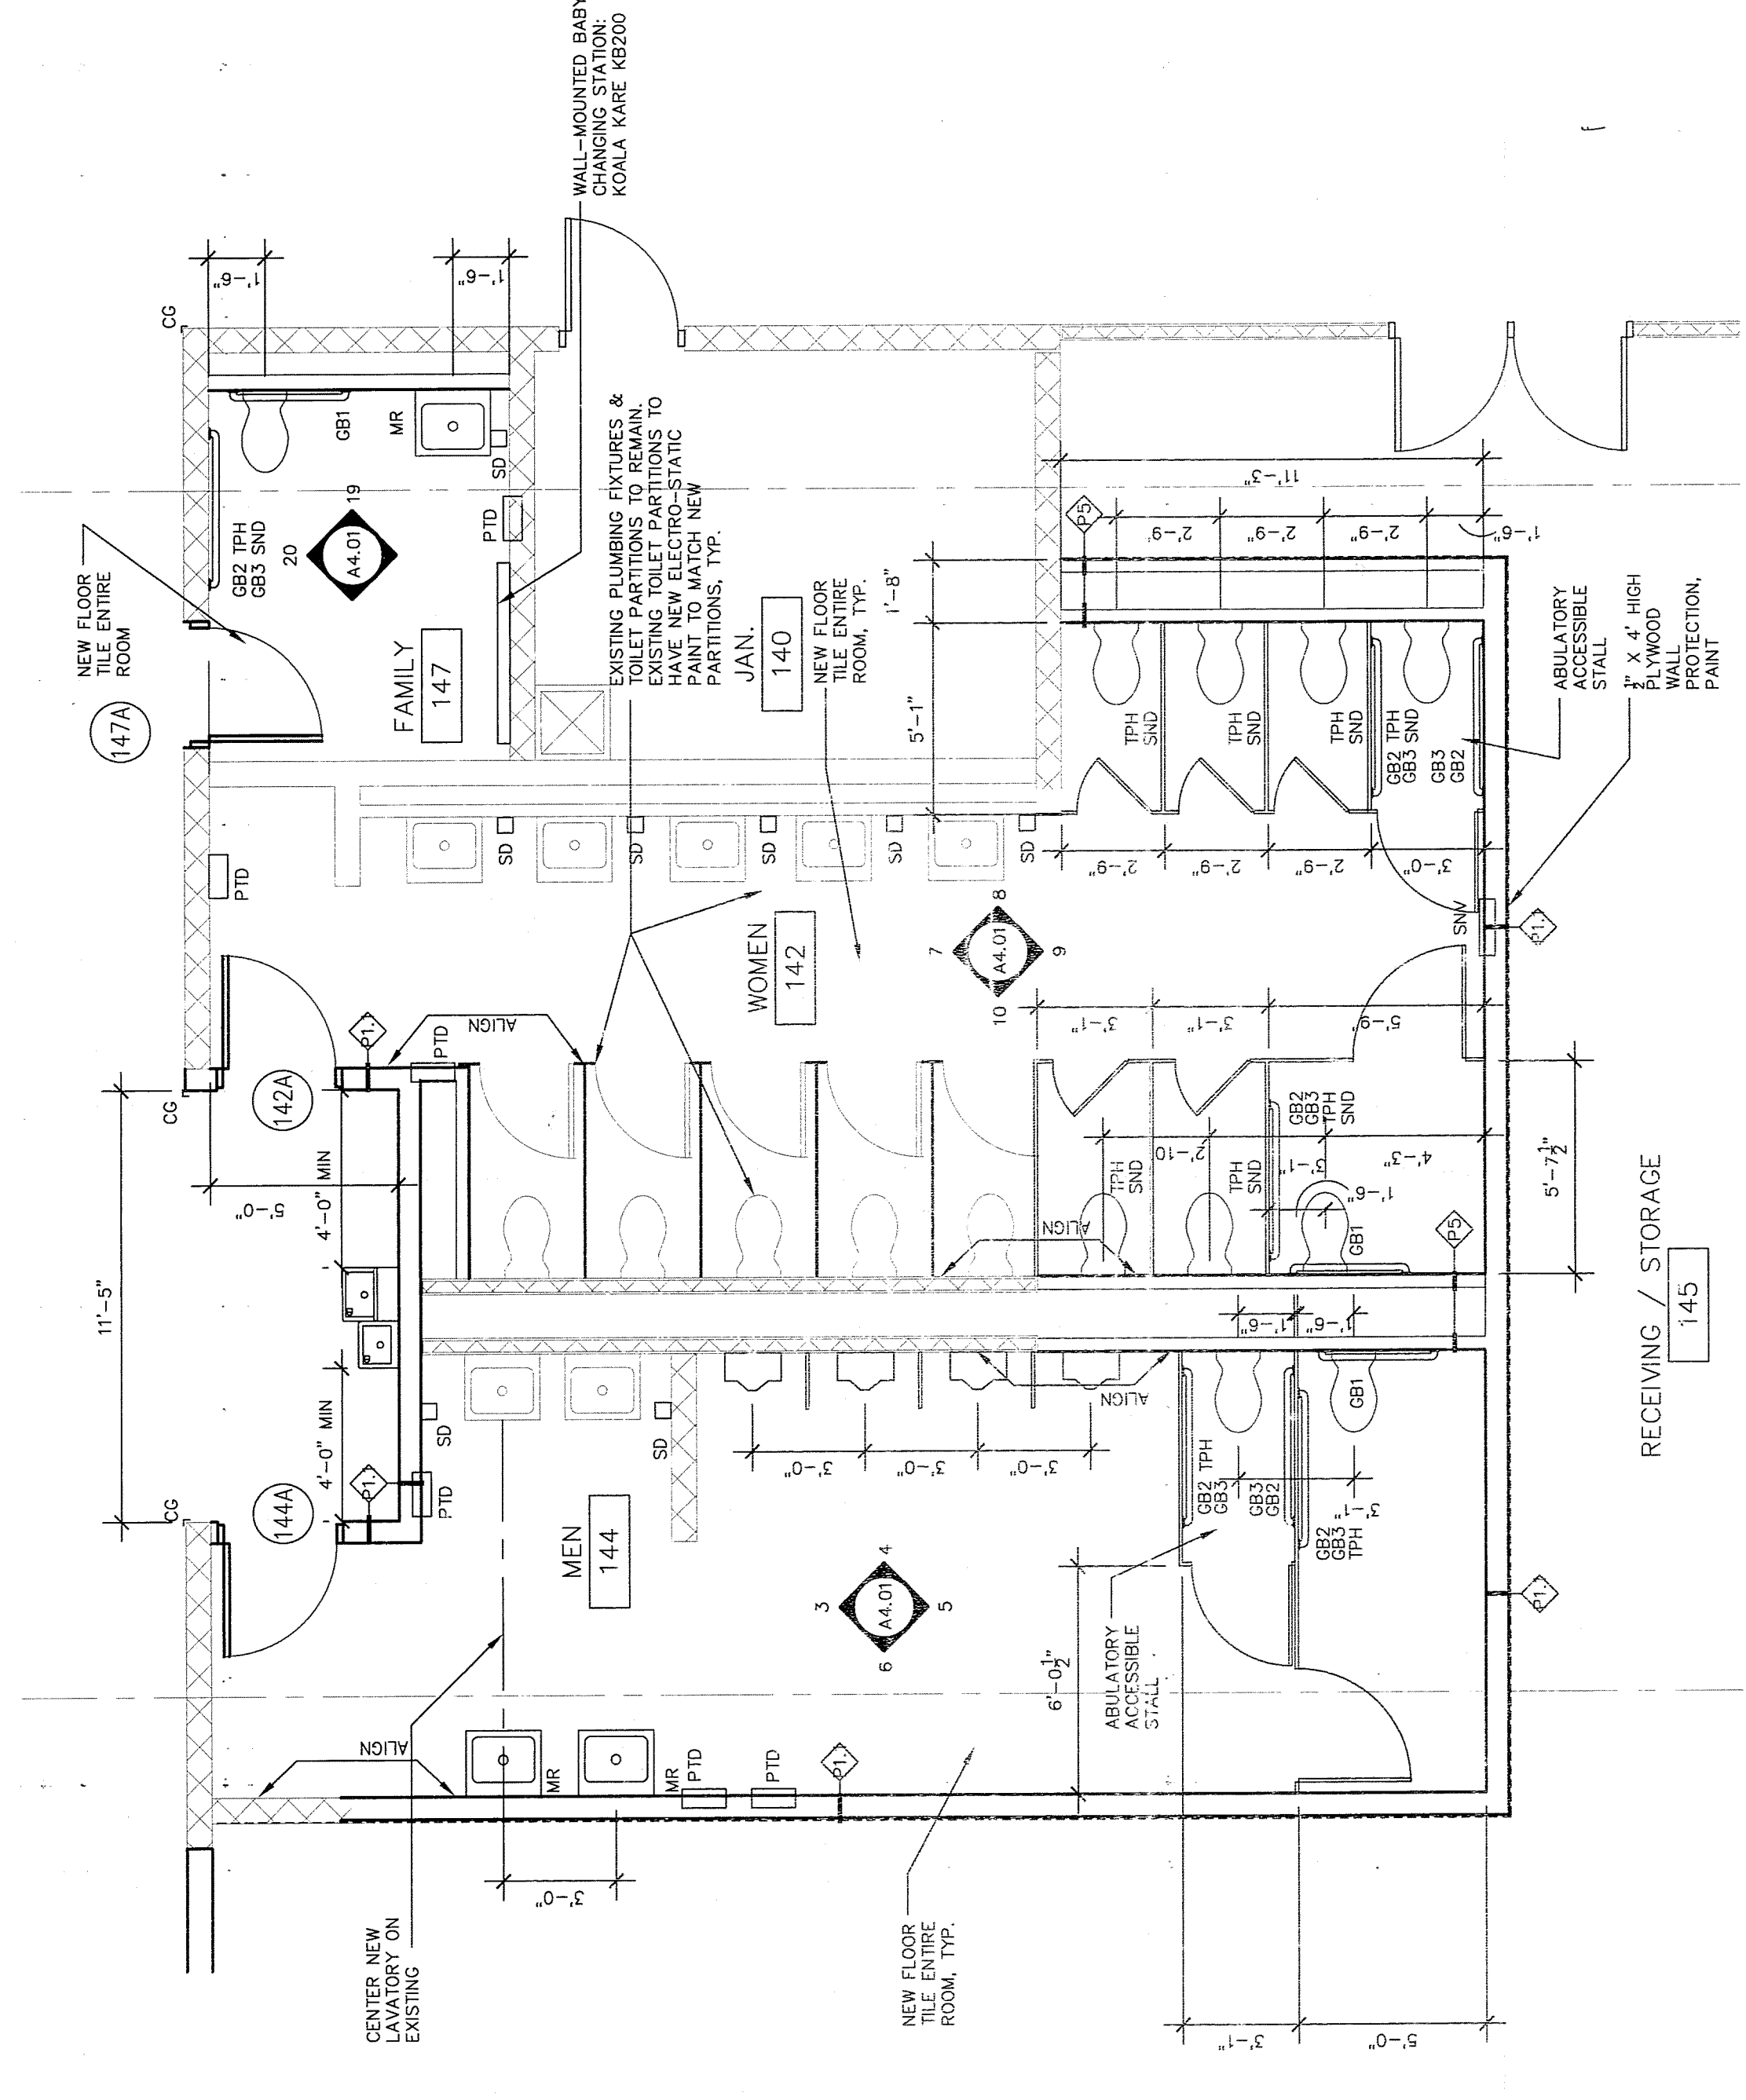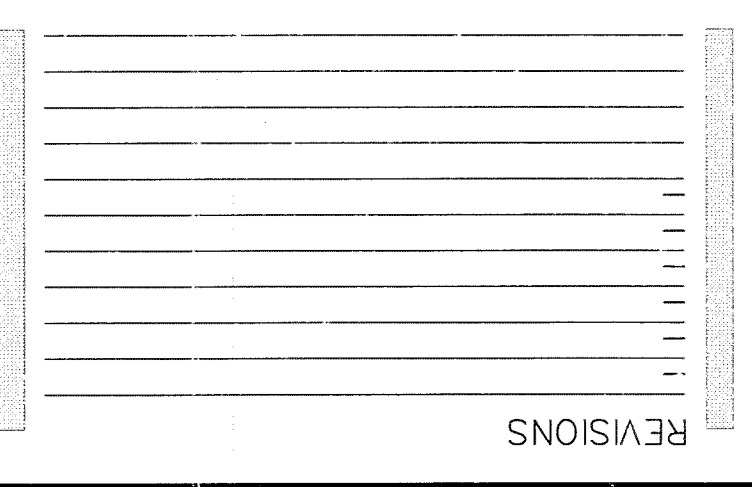


**TOILET ACCESSORY LEGEND**

MARK	DESCRIPTION	MANUFACTURER	PRODUCT NO.	TOP. HGT. A.F.F.
GR1	GRAB BAR, 36"	BOBRICK	E-8805 X 36	36"
GR2	GRAB BAR, 18"	BOBRICK	E-8805 X 18	36"
GR3	GRAB BAR, 18"	BOBRICK	E-8805 X 18	VERT. GRAB BAR PER ANS A117.1
TPH	TOILET PAPER HOLDER	BOBRICK	E-2746	CL. UNIT 19" A.F.F.
SD	SANITARY MARKING DISPOSAL	BOBRICK	E-4354	30" A.F.F. TO TOP OF UNIT
SPV	SPRAY VARNISH VENDING	BOBRICK	E-4705	48" A.F.F. TO TOP OF UNIT
SDP	SOAP DISPENSER	BOBRICK	E-4384	48" A.F.F. TO TOP OF UNIT
PTD	PAPER TOWEL DISP./RECEPT.	BOBRICK	E-4384	48" MAX. TO DISPENSER, SDT
MR	METAL FRAMED MIRROR	BOBRICK	E-165 180	5.0 REFLECTING SURFACE
MT	MOUNTING	BOBRICK	E-4384	48" MAX. TO DISPENSER, SDT
GT	COAT HOOK	BOBRICK	E-542	48" MAX. TO COAT HOOK LOCATIONS, 80" OTHERWISE

NOTES:  
 1. CONFIRM RELOCATION OF EXISTING TOILET ACCESSORIES AT WALLS TO BE DEMOLISHED.  
 2. MANUFACTURER AND MODEL NUMBER OF ALL ACCESSORIES TO BE INSTALLED.  
 3. COAT HOOKS SHALL BE INSTALLED AT EACH TOILET STALL DOOR. COAT HOOKS ARE NOT INDICATED ON DRAWINGS.  
 4. ADA ACCESSIBLE ACCESSORIES SHALL BE MOUNTED IN COMPLIANCE WITH ICC/ANSI A117.1.  
 5. MOUNT TOILET PAPER HOLDERS BETWEEN 7 INCHES AND 9 INCHES IN FRONT OF THE TOILET FRONT EDGE.

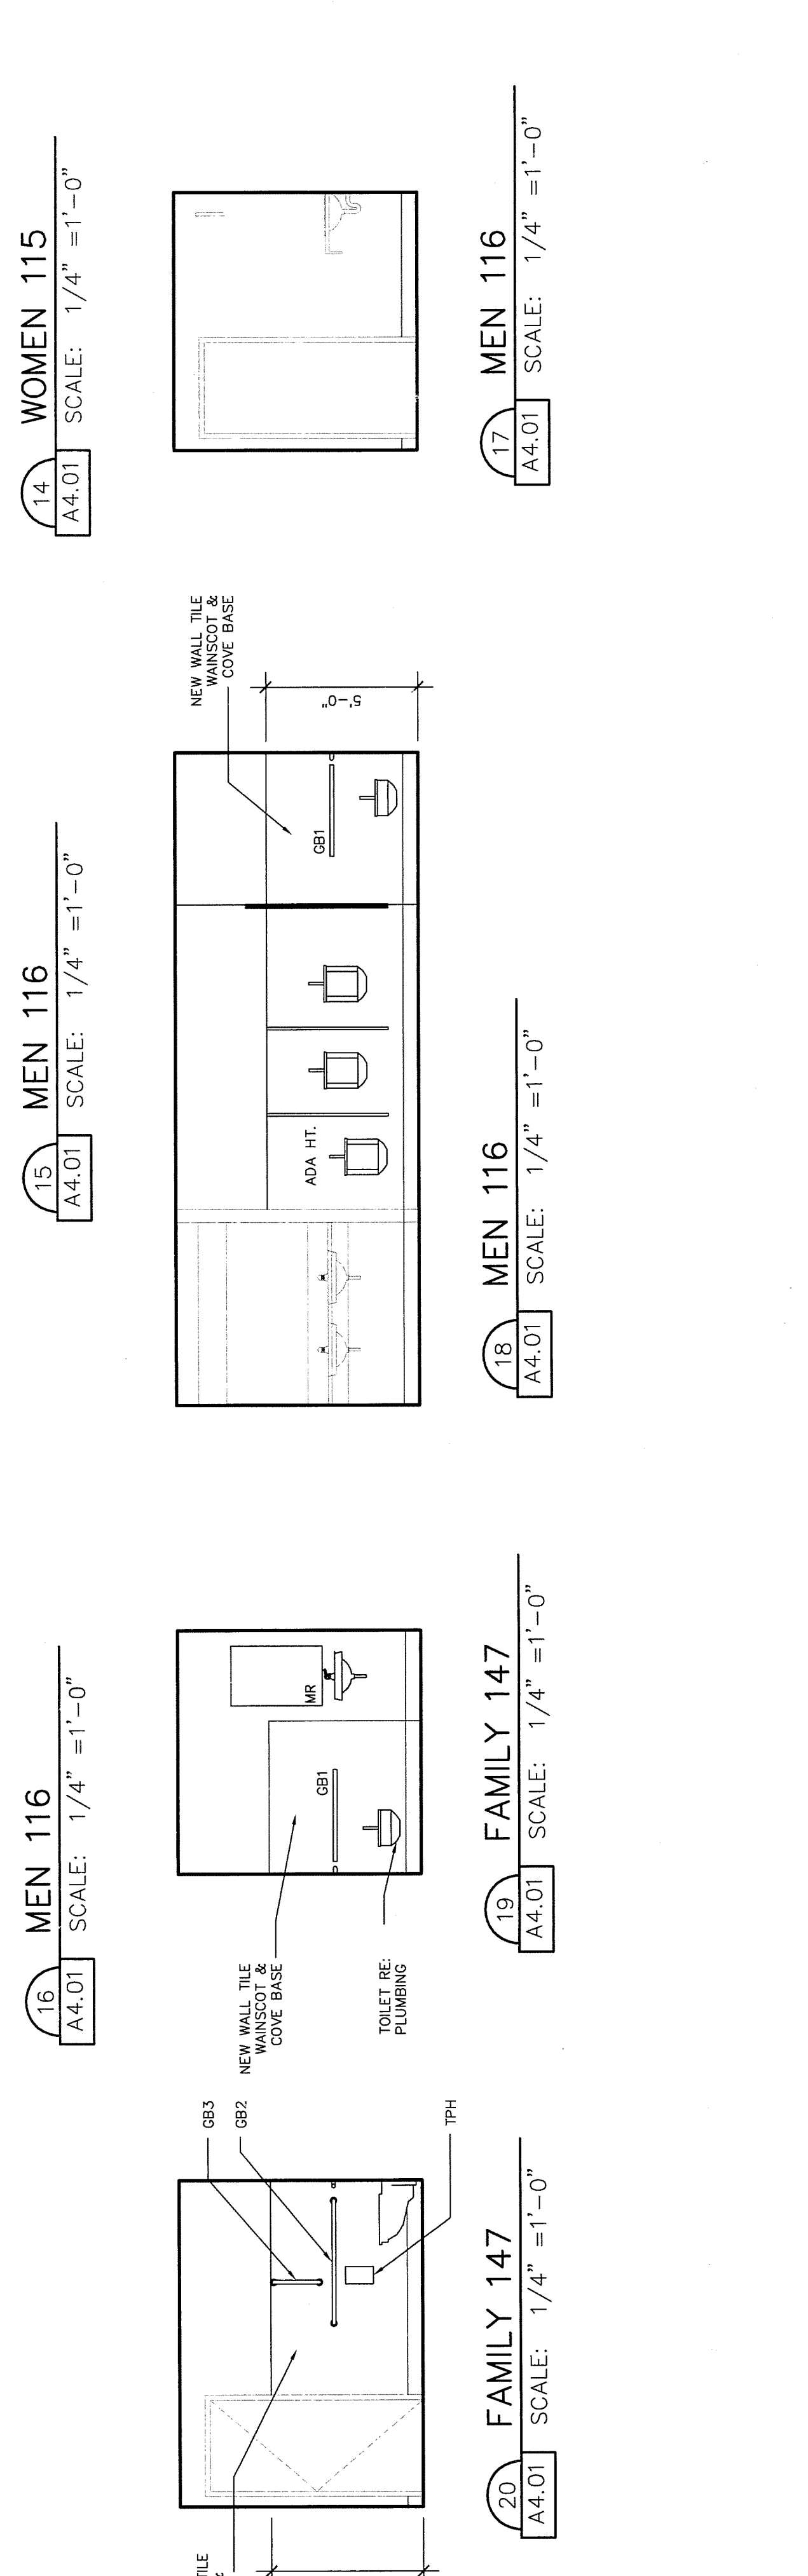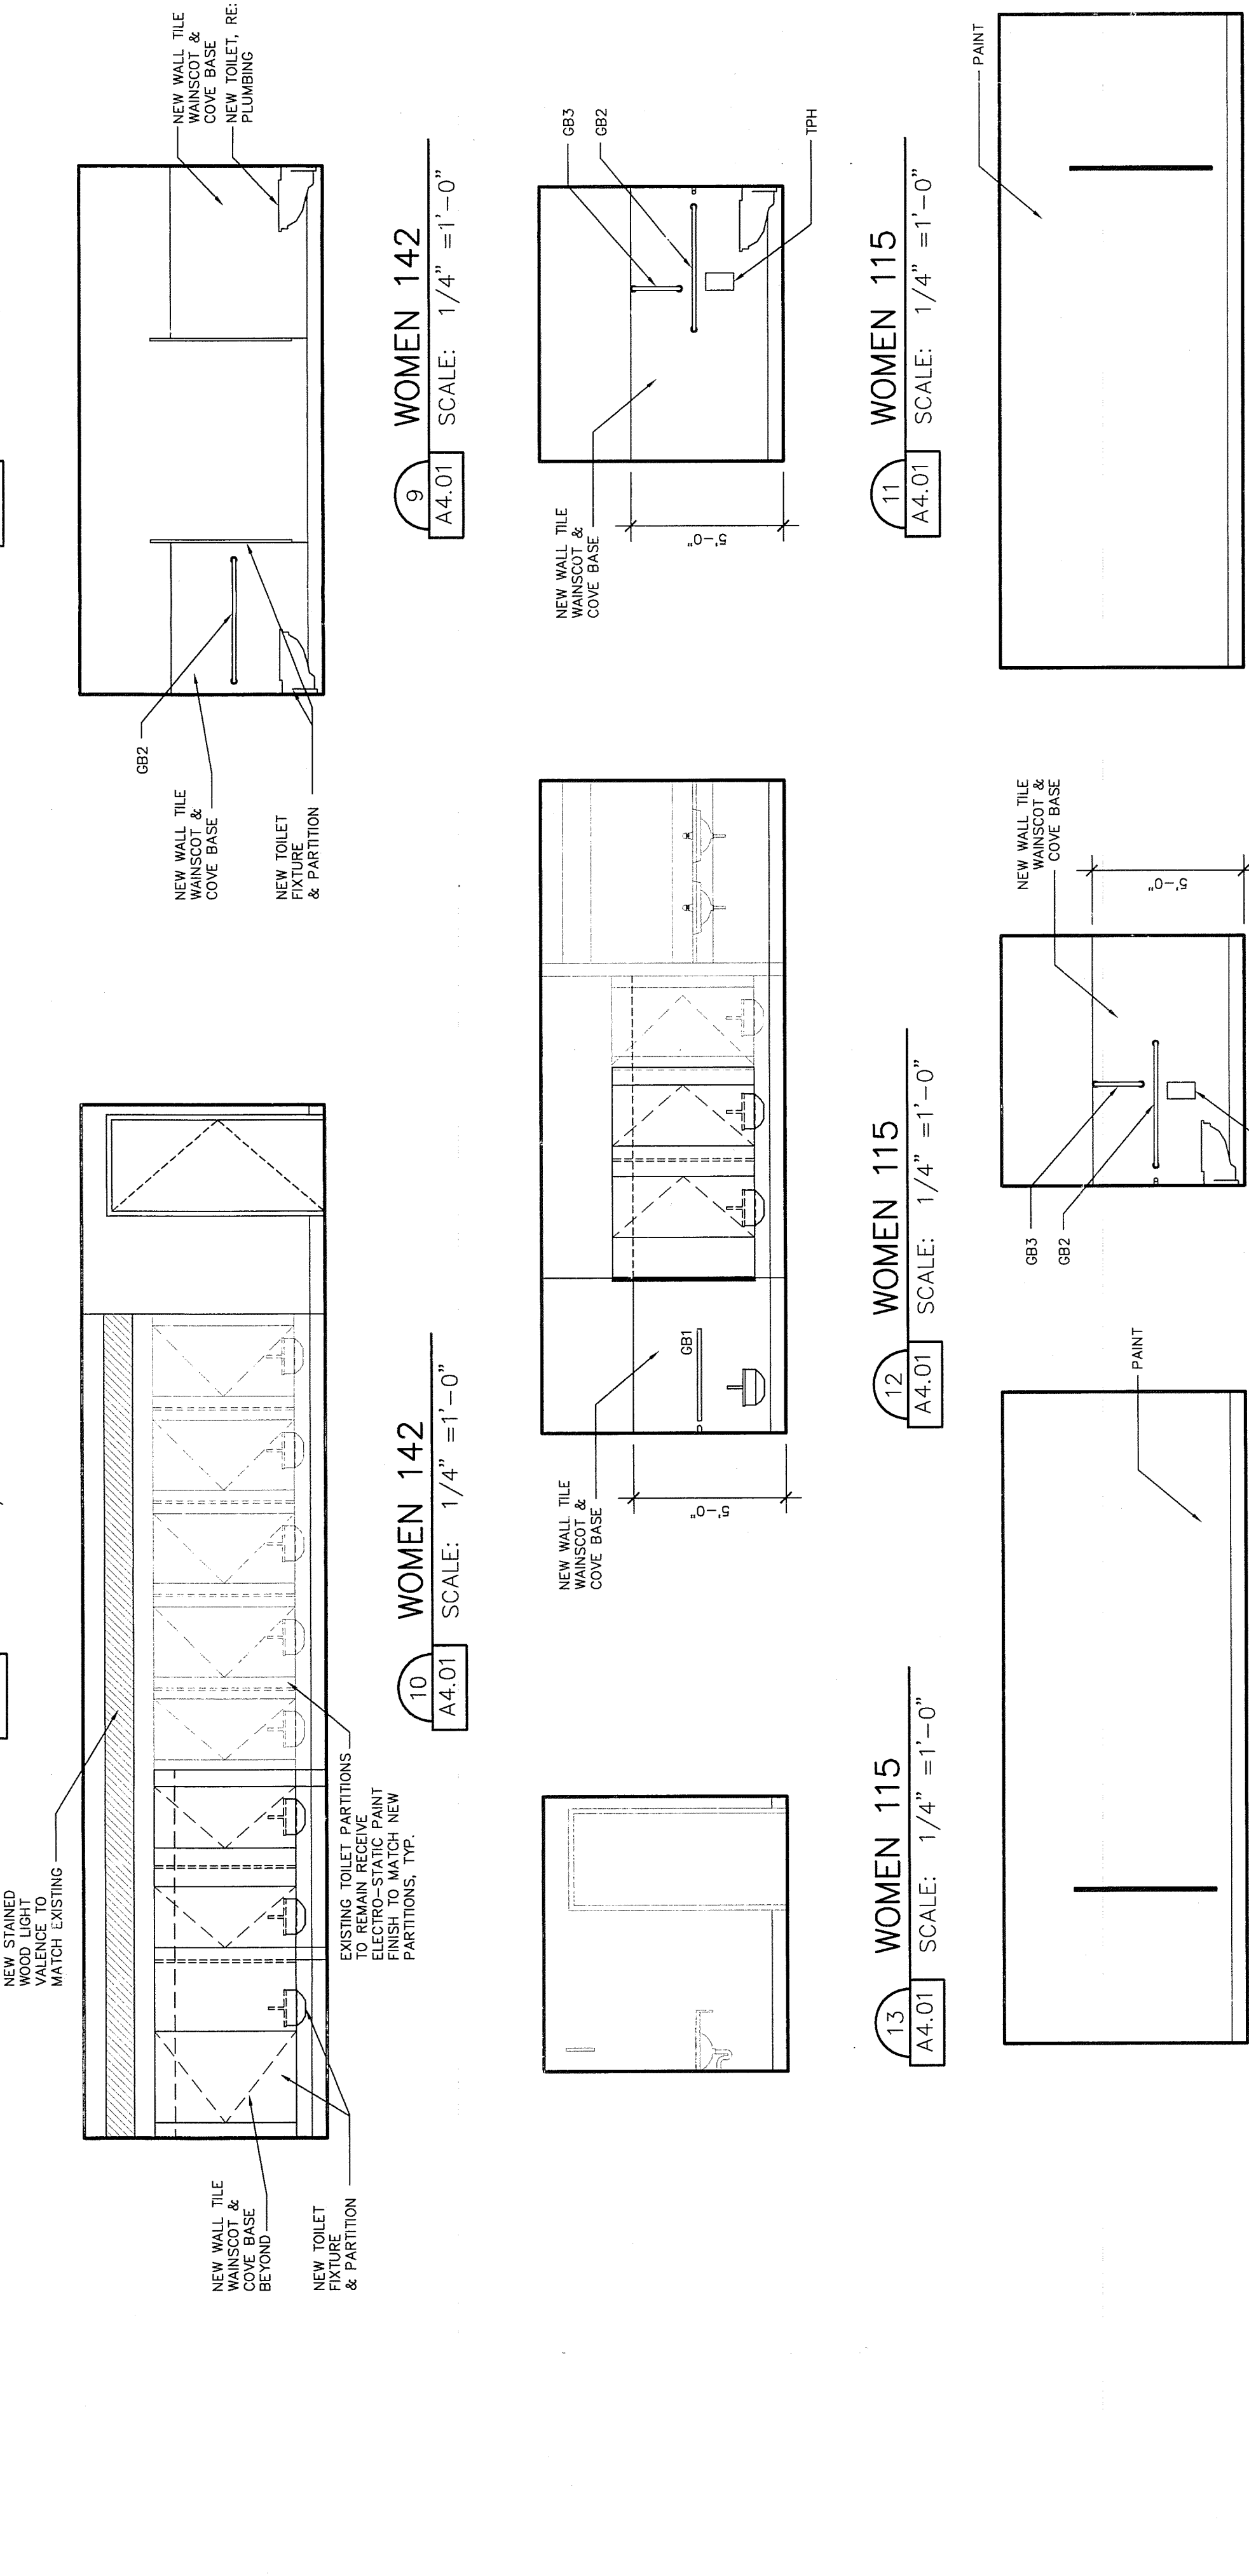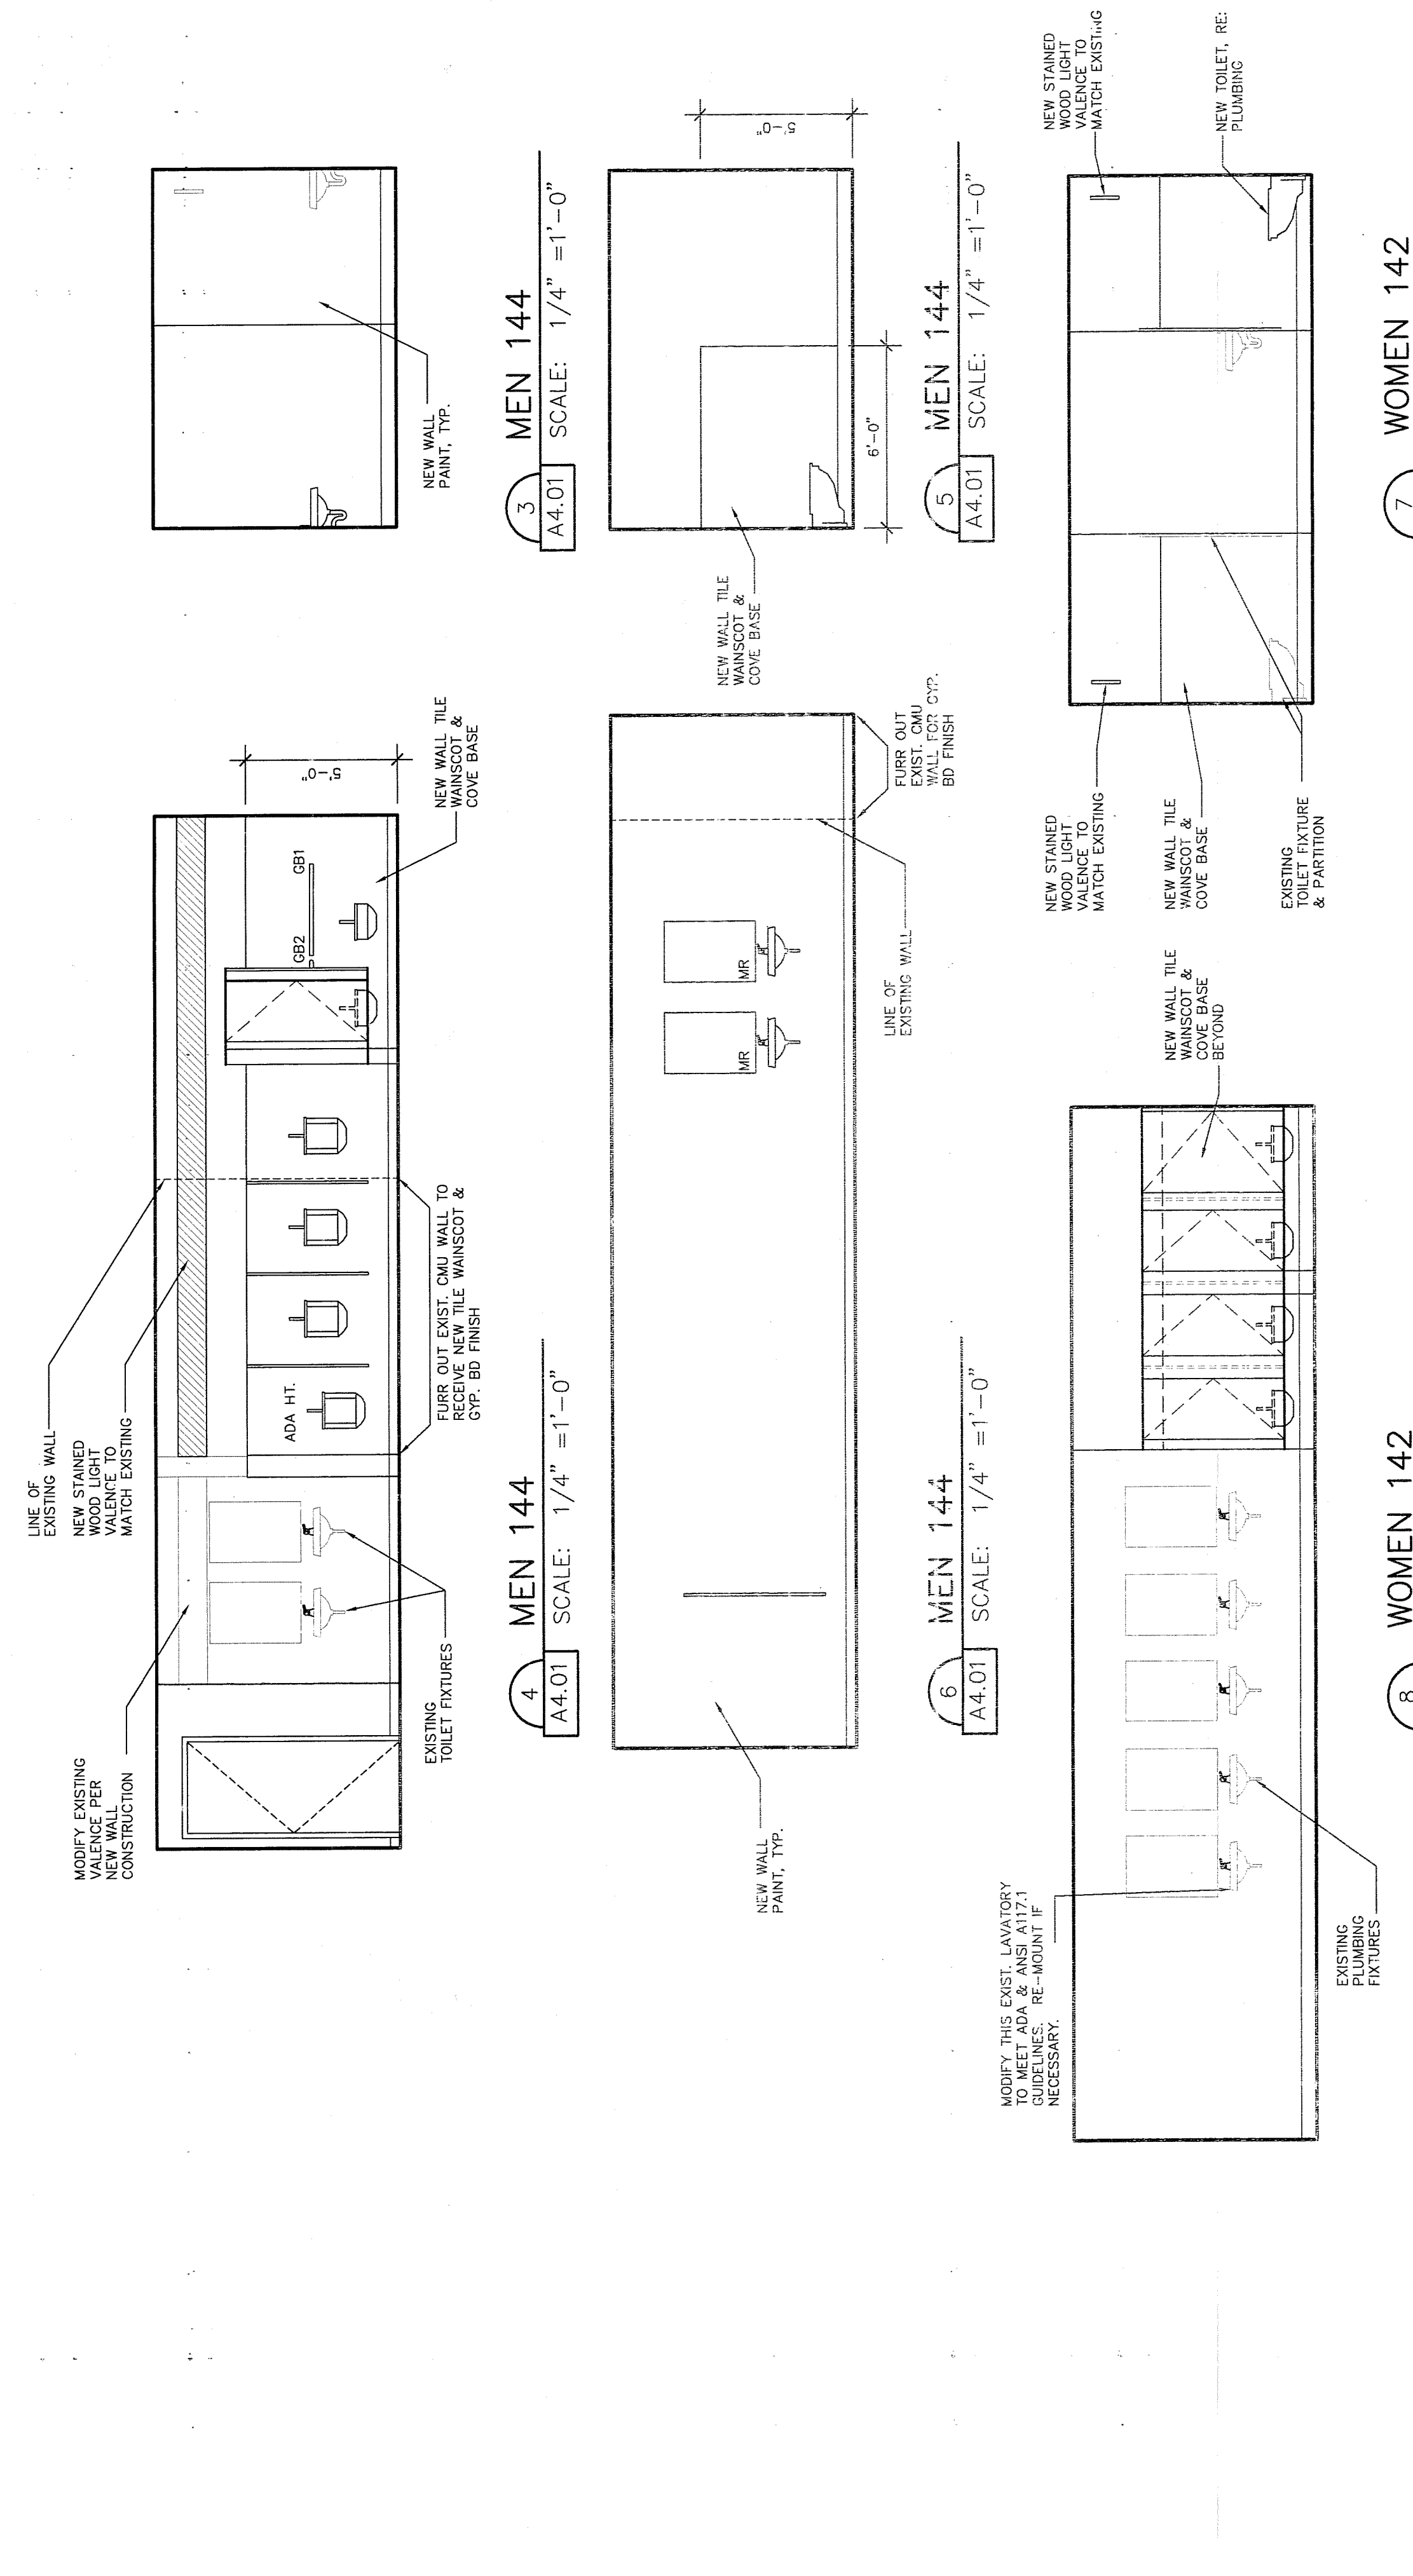




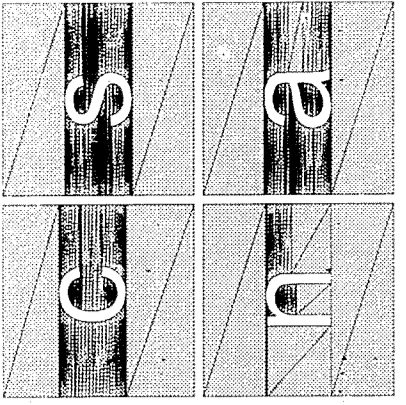

architects

532 n. tejon st. colorado springs, colorado 80903 p.719.473.7225 f.719.632.5164 w.csaarchitects.com

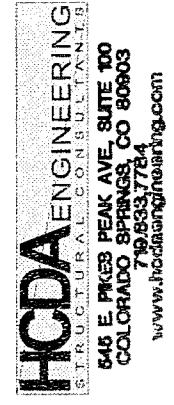

COLORADO SPRINGS EXPO CENTER 3650 NORTH NEVADA AVE. BUILDING RENOVATION COLORADO SPRINGS, COLORADO

PLANS AND DETAILS

JOB NO.: 1002210 DATE: 06/06/11 SCALE: AS NOTED DRAWN: DCL CHECKED: ABB SHEET S10

- GENERAL NOTES
1. Material and workmanship shall be in accordance with the requirements of the International Building Code, 2009 Edition.
2. Contractor shall check and verify all dimensions shown on structural drawings with those shown on architectural drawings.

- FOUNDATION - GENERAL NOTES
1. Recommendations for foundation type and design criteria were provided by the soils report completed for the 1981 building addition, written by Thomas Summerer Inc., number 2472, dated 12/18/07.
2. Maximum bearing pressure used in footing design: 3,000 psf

CONCRETE - GENERAL NOTES

- 1. Material and workmanship shall be in accordance with the requirements of the International Building Code, 2009 Edition.
2. Concrete shall conform to the following:
Mk. "A" - For Foundations and Exterior Site concrete


STRUCTURAL STEEL - GENERAL NOTES

- 1. All steel shall conform to the "Standard Specification for Structural Steel" ASTM Designation A36, Grade 50, or A992, latest edition, except where otherwise noted.
2. All steel connections shall be welded unless noted otherwise.


DESIGN LOADS

- Roof Loads
Dead (see notes) 82 psf
Existing roof OTS and roofing 70 psf
Existing DT wall panels 30 psf
Snow Load 20 psf


SPECIAL INSPECTION - GENERAL NOTES
1. A statement of special inspections for structural items has been prepared by HCDA Engineering, Inc. for the contractor's use.
2. The Structural Engineer will perform periodic observations of construction. These observations shall not replace required inspections by the Building Official.

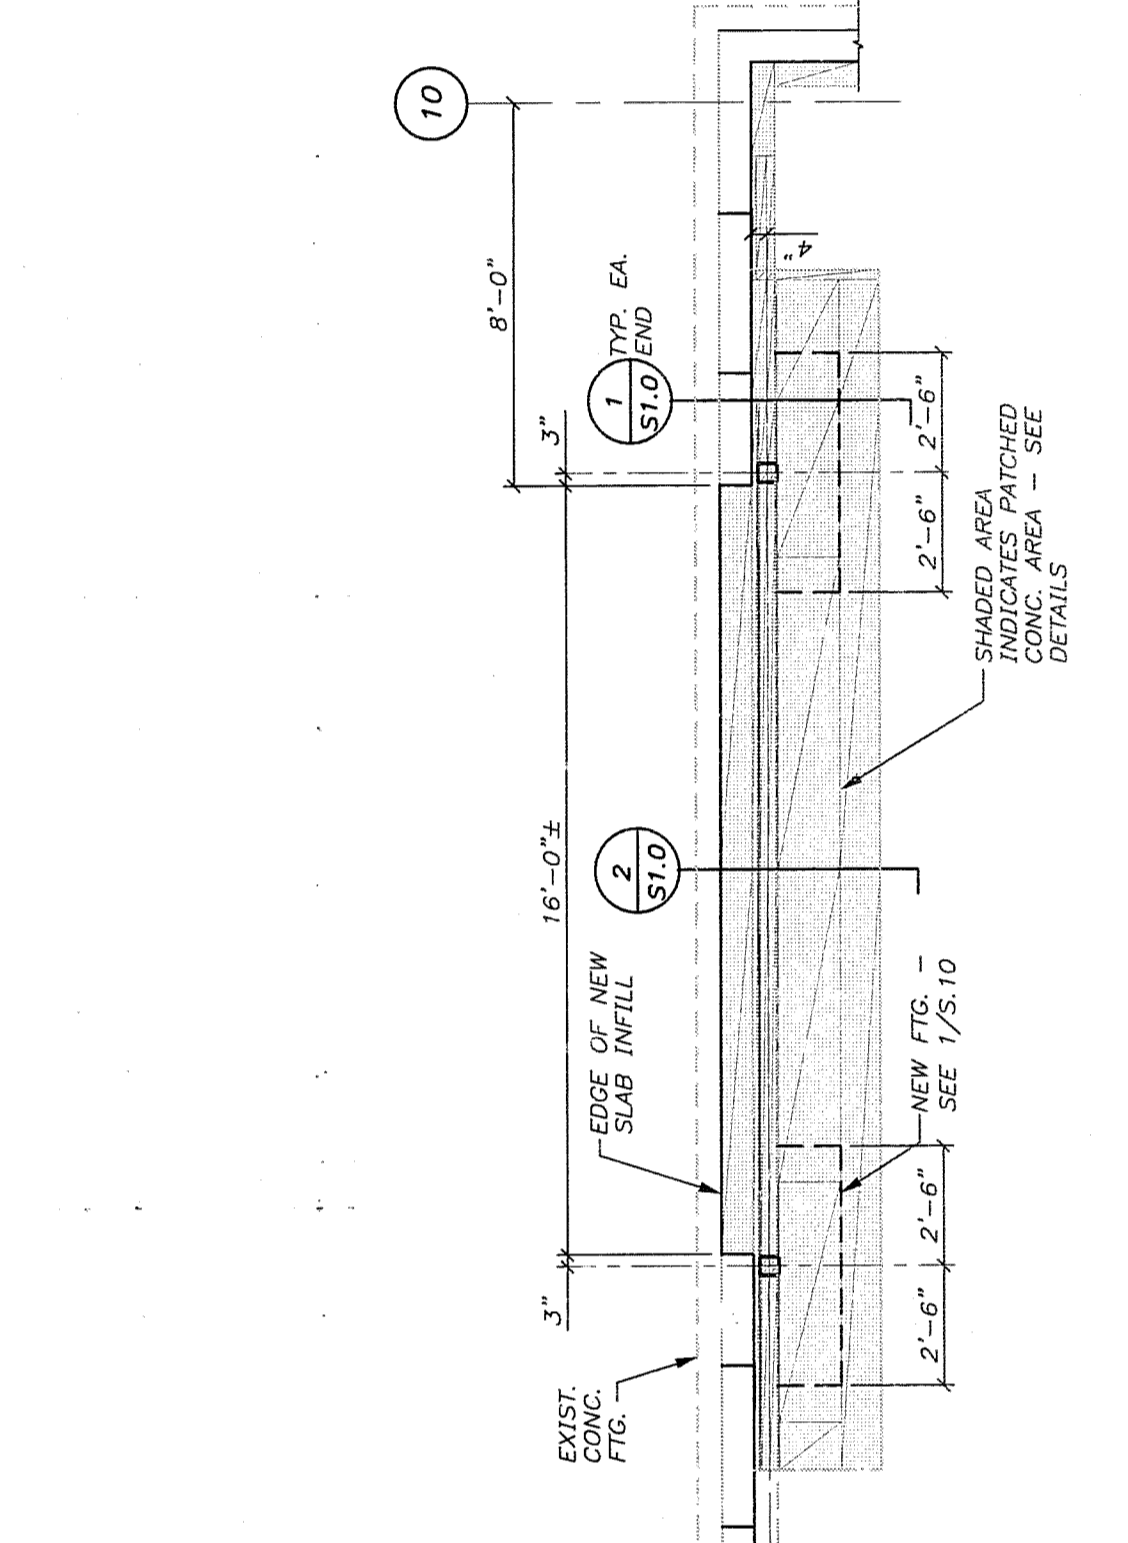


PARTIAL FOUNDATION PLAN AT OVERHEAD DOOR

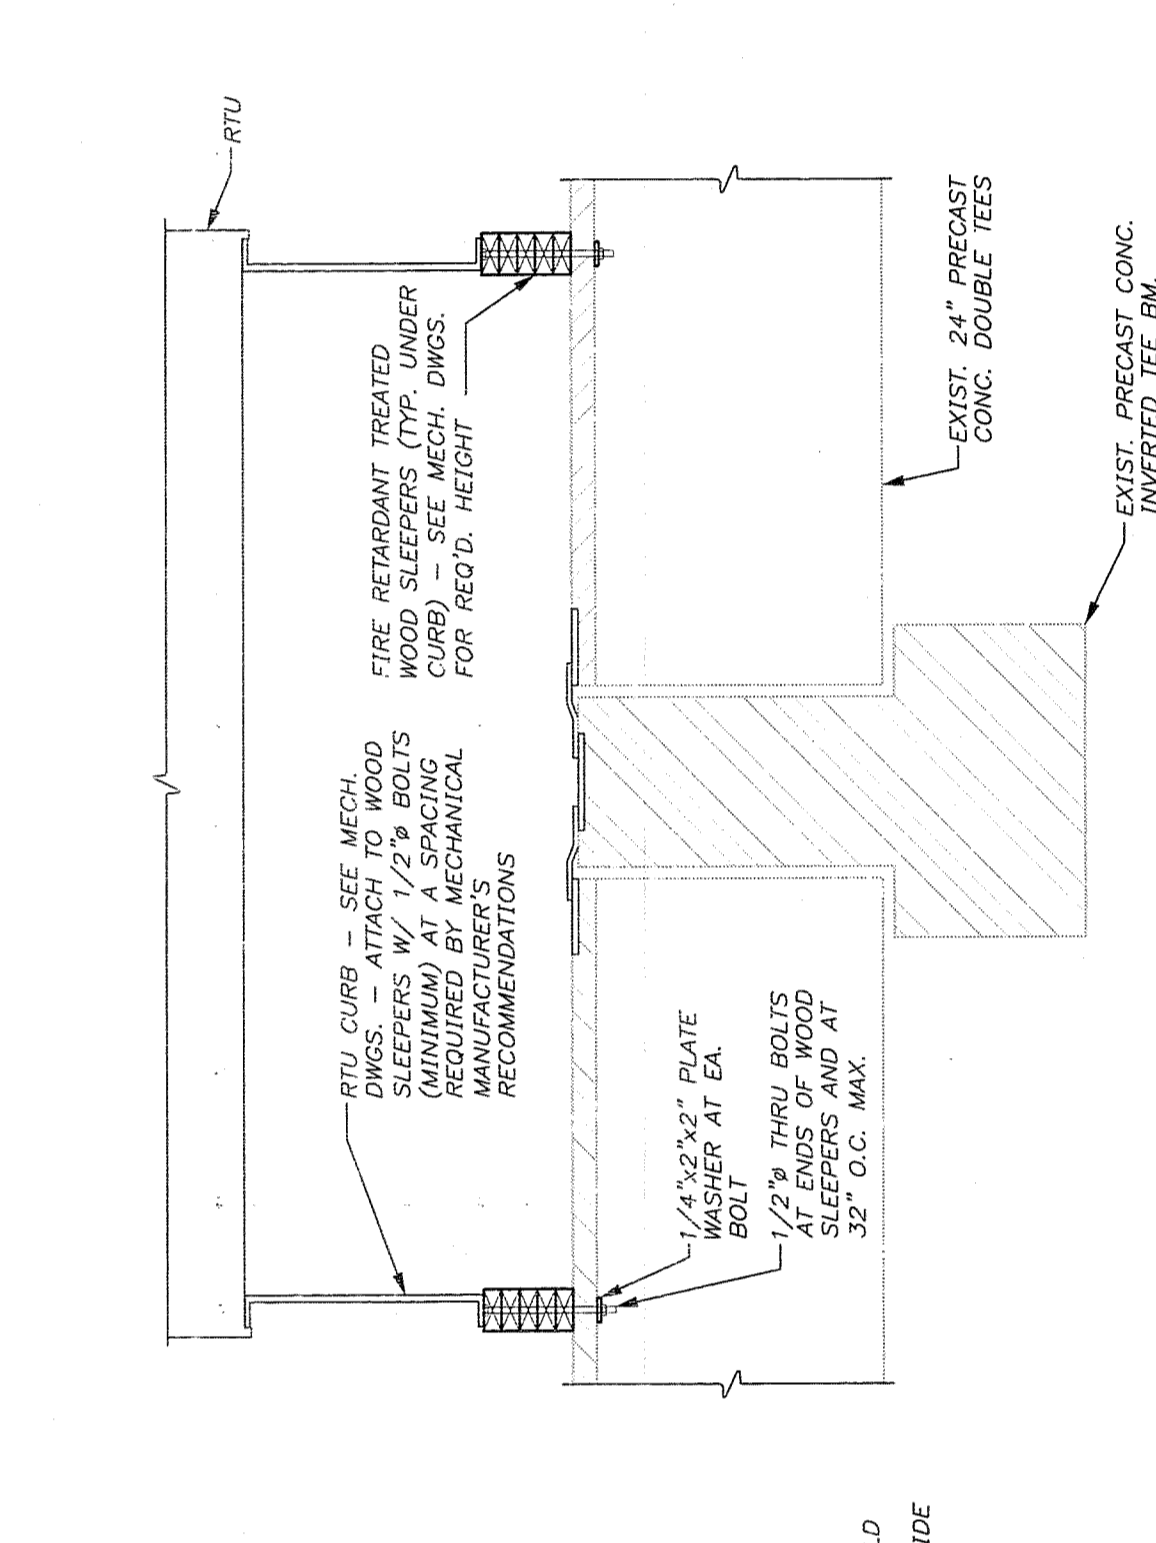


5

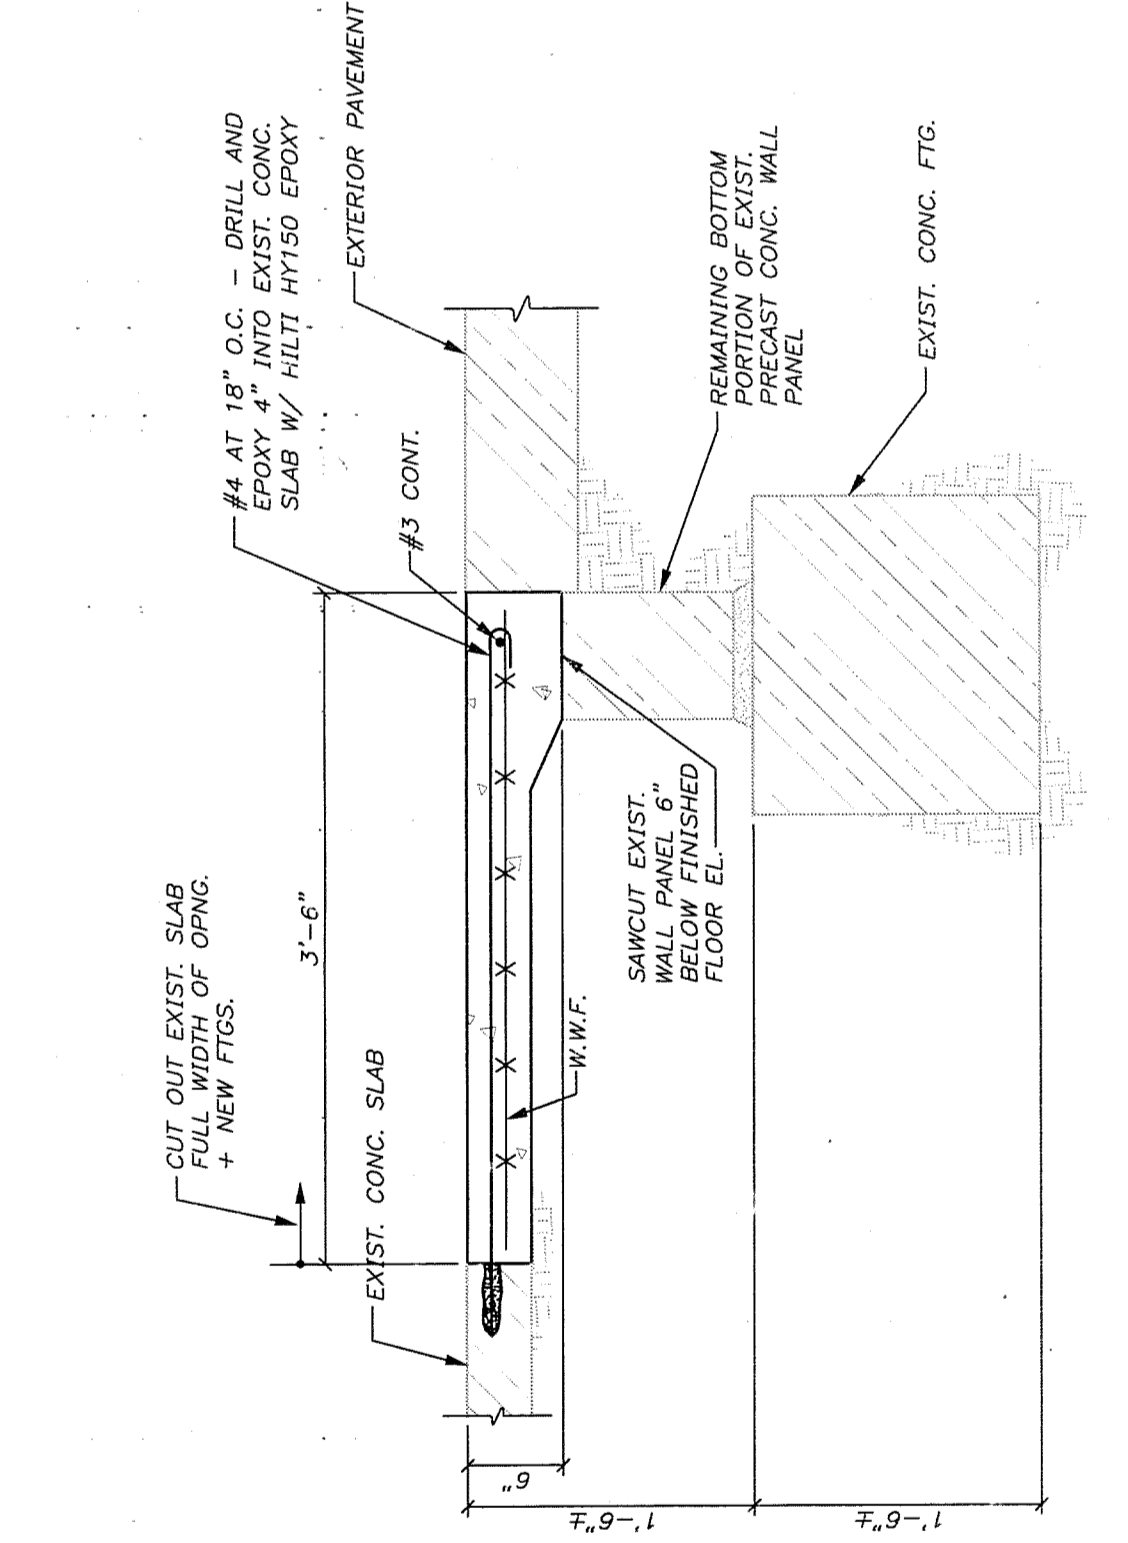


2

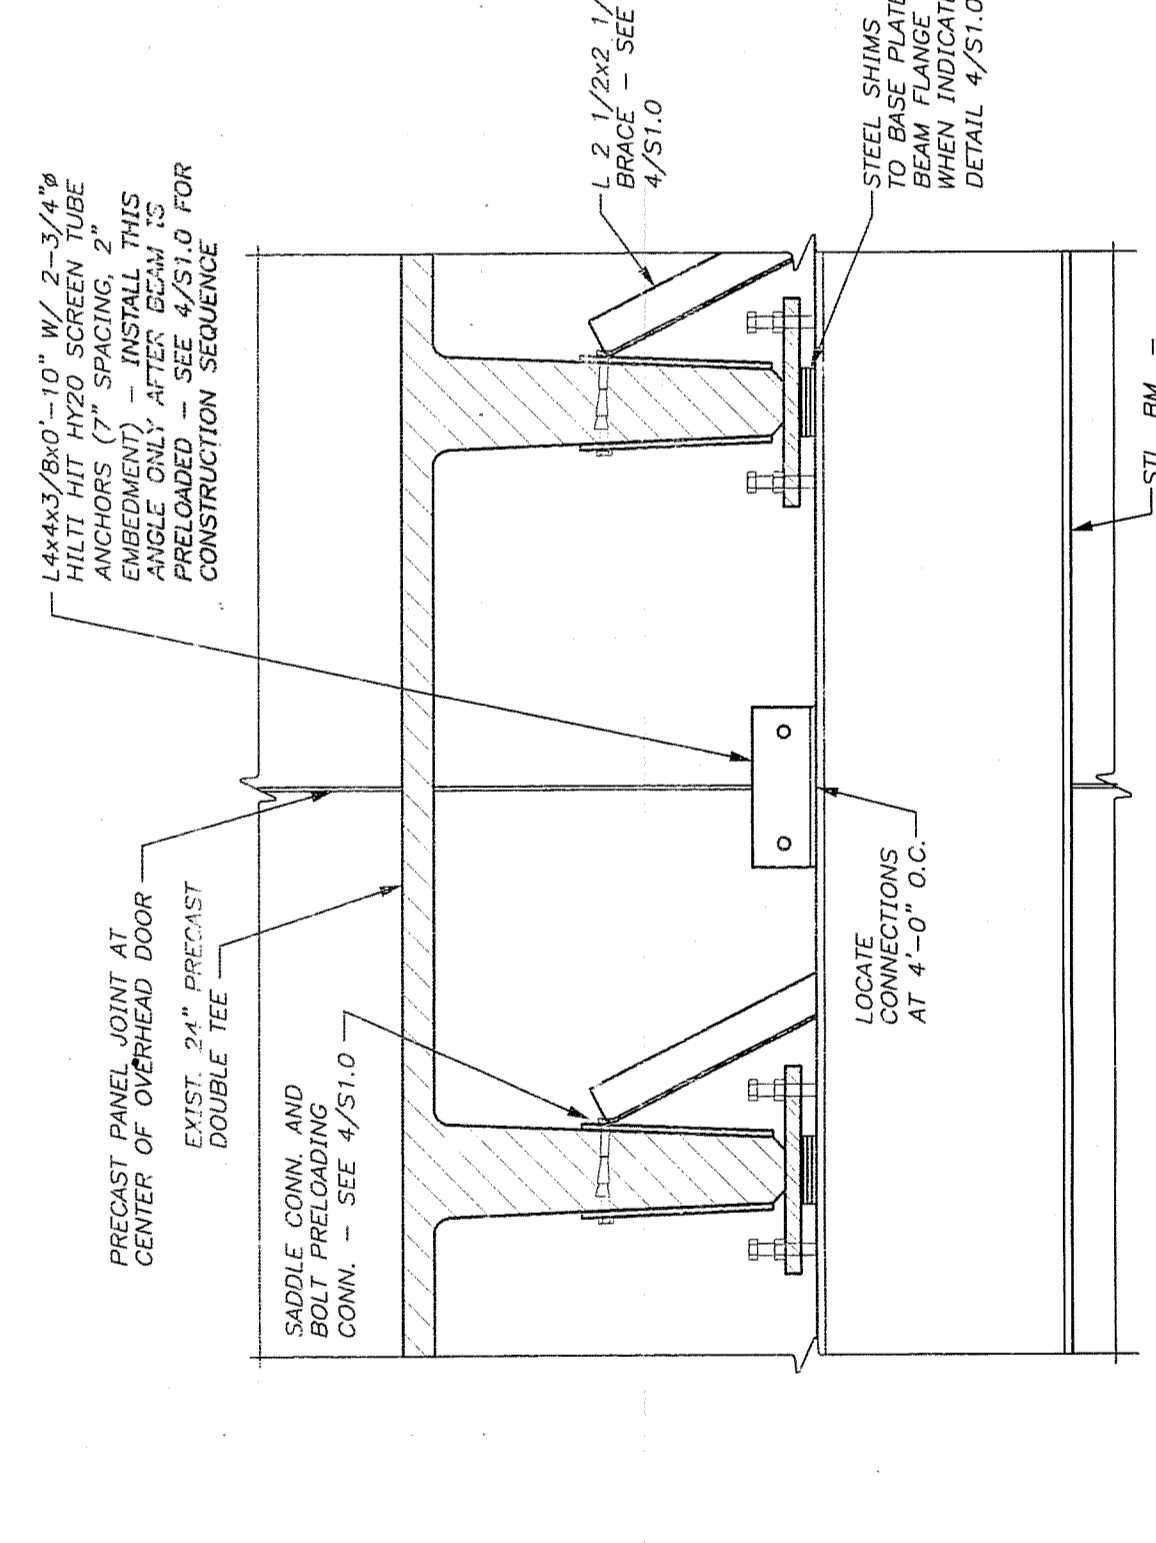

6

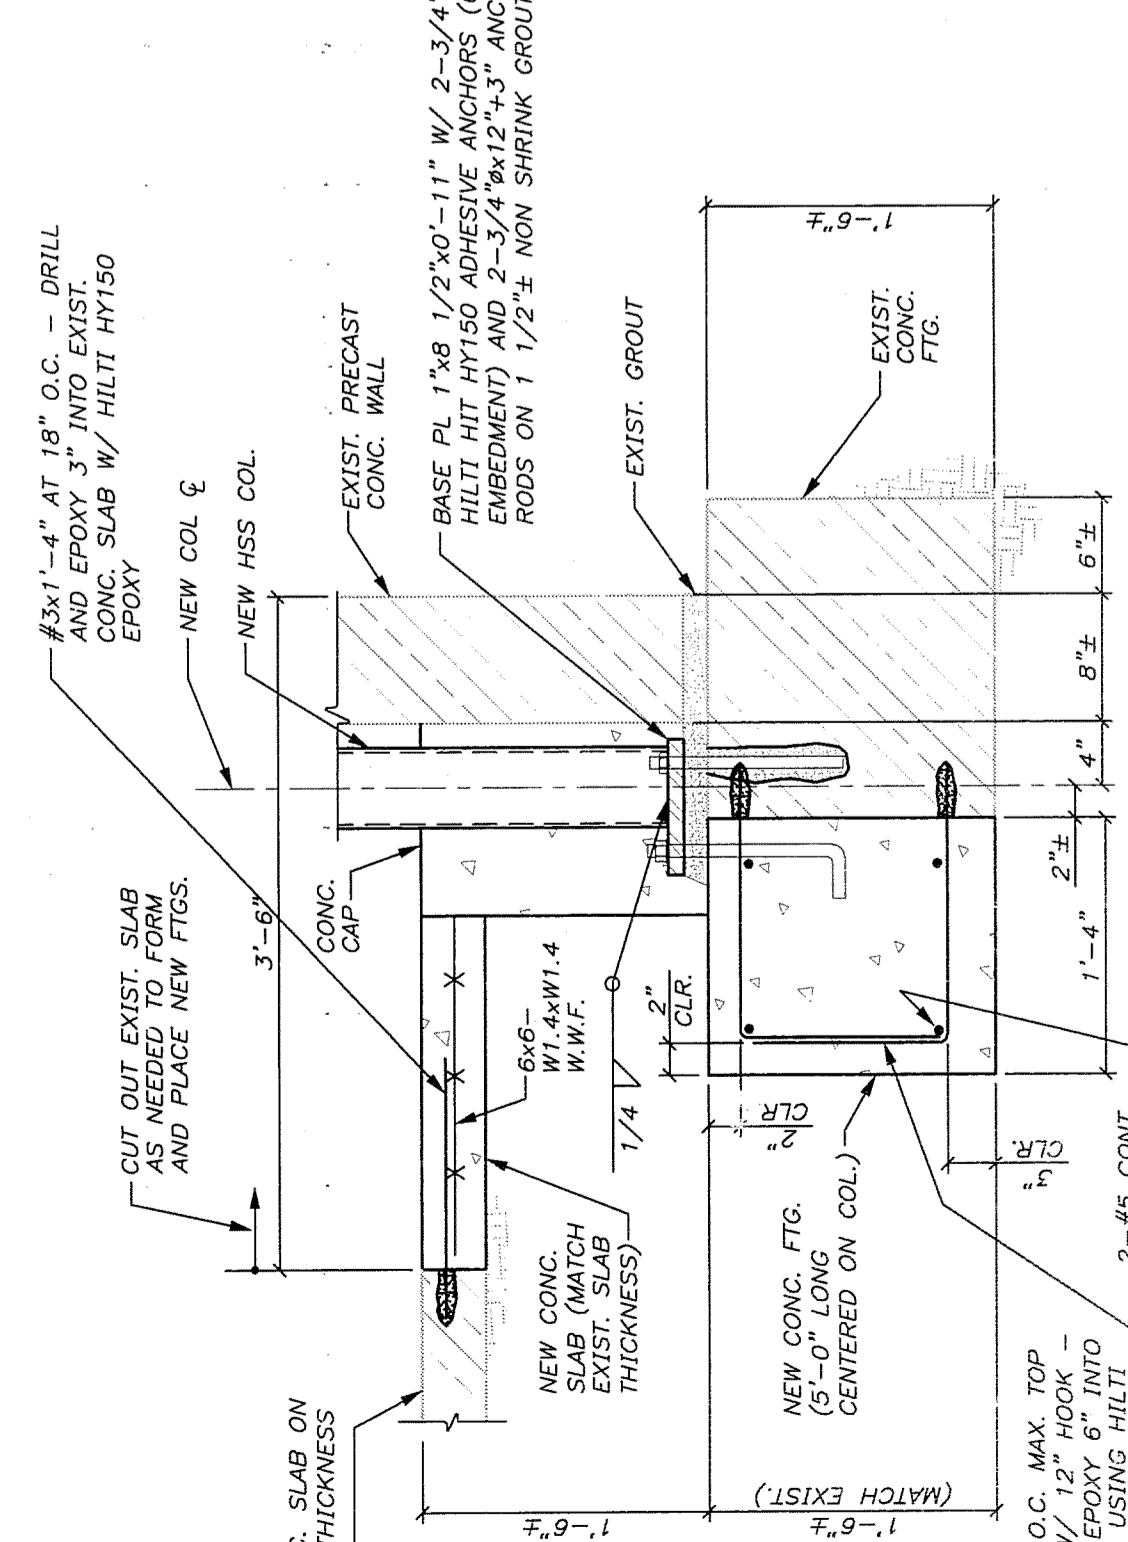


1

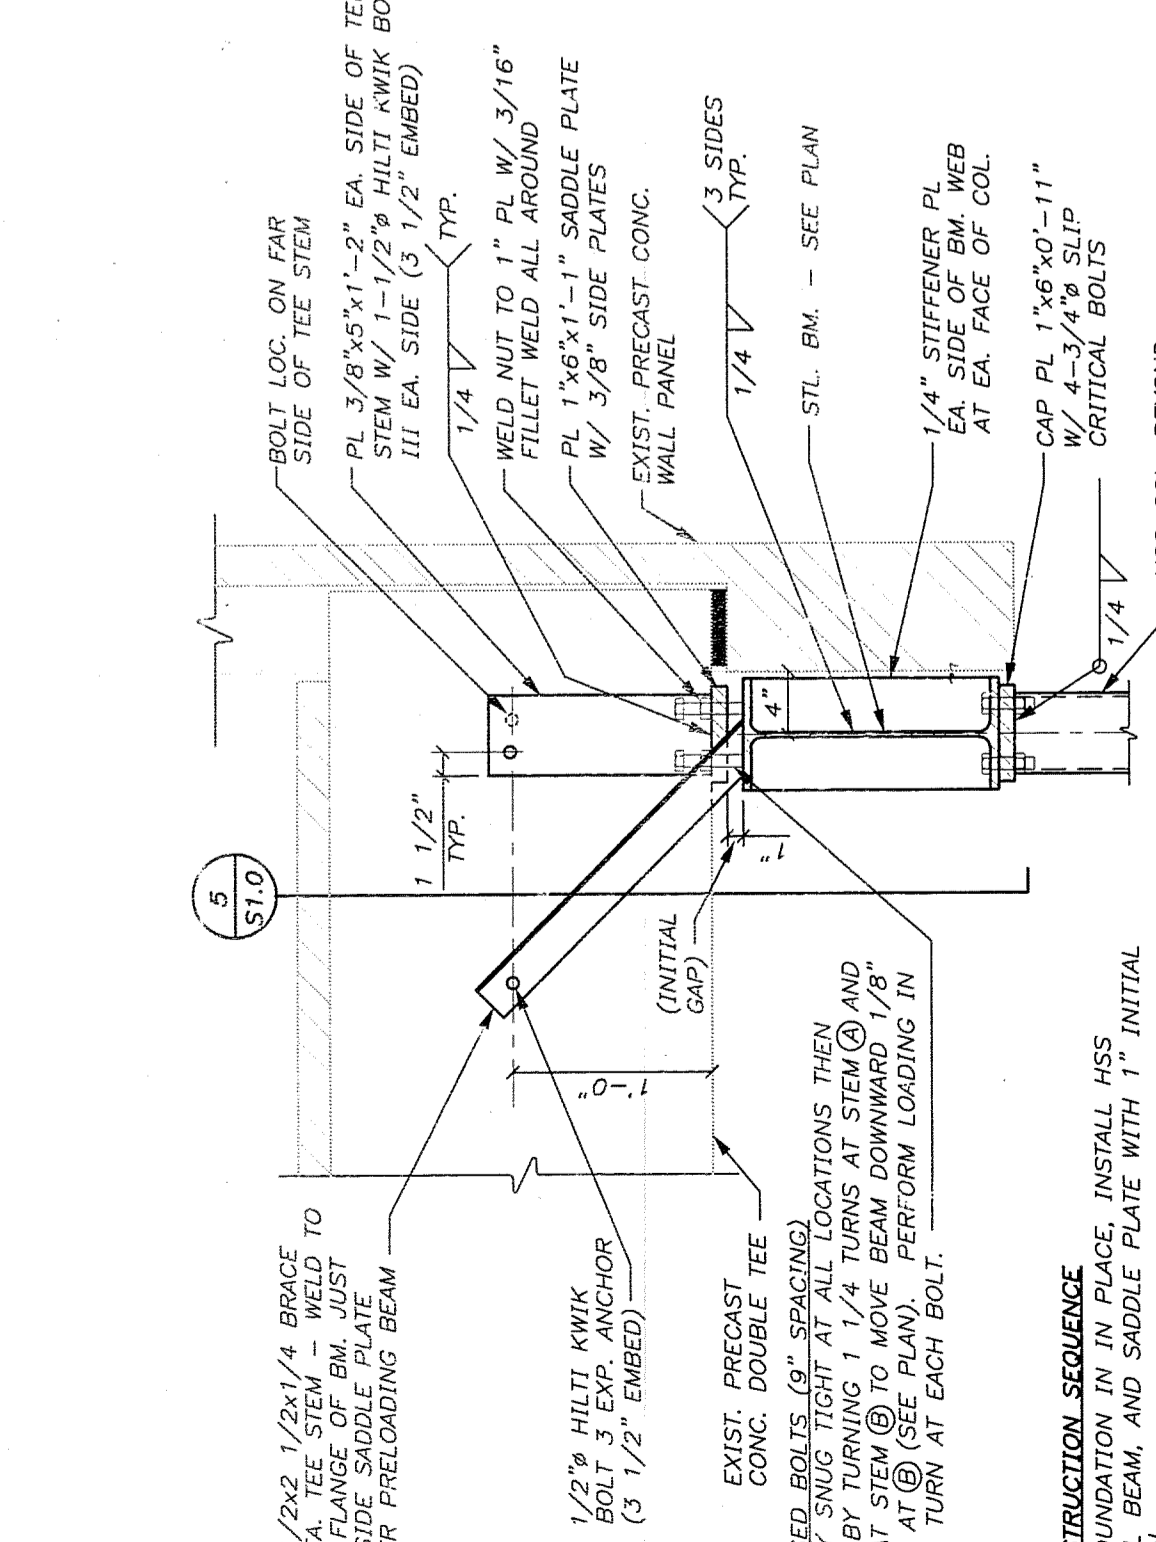

4

7

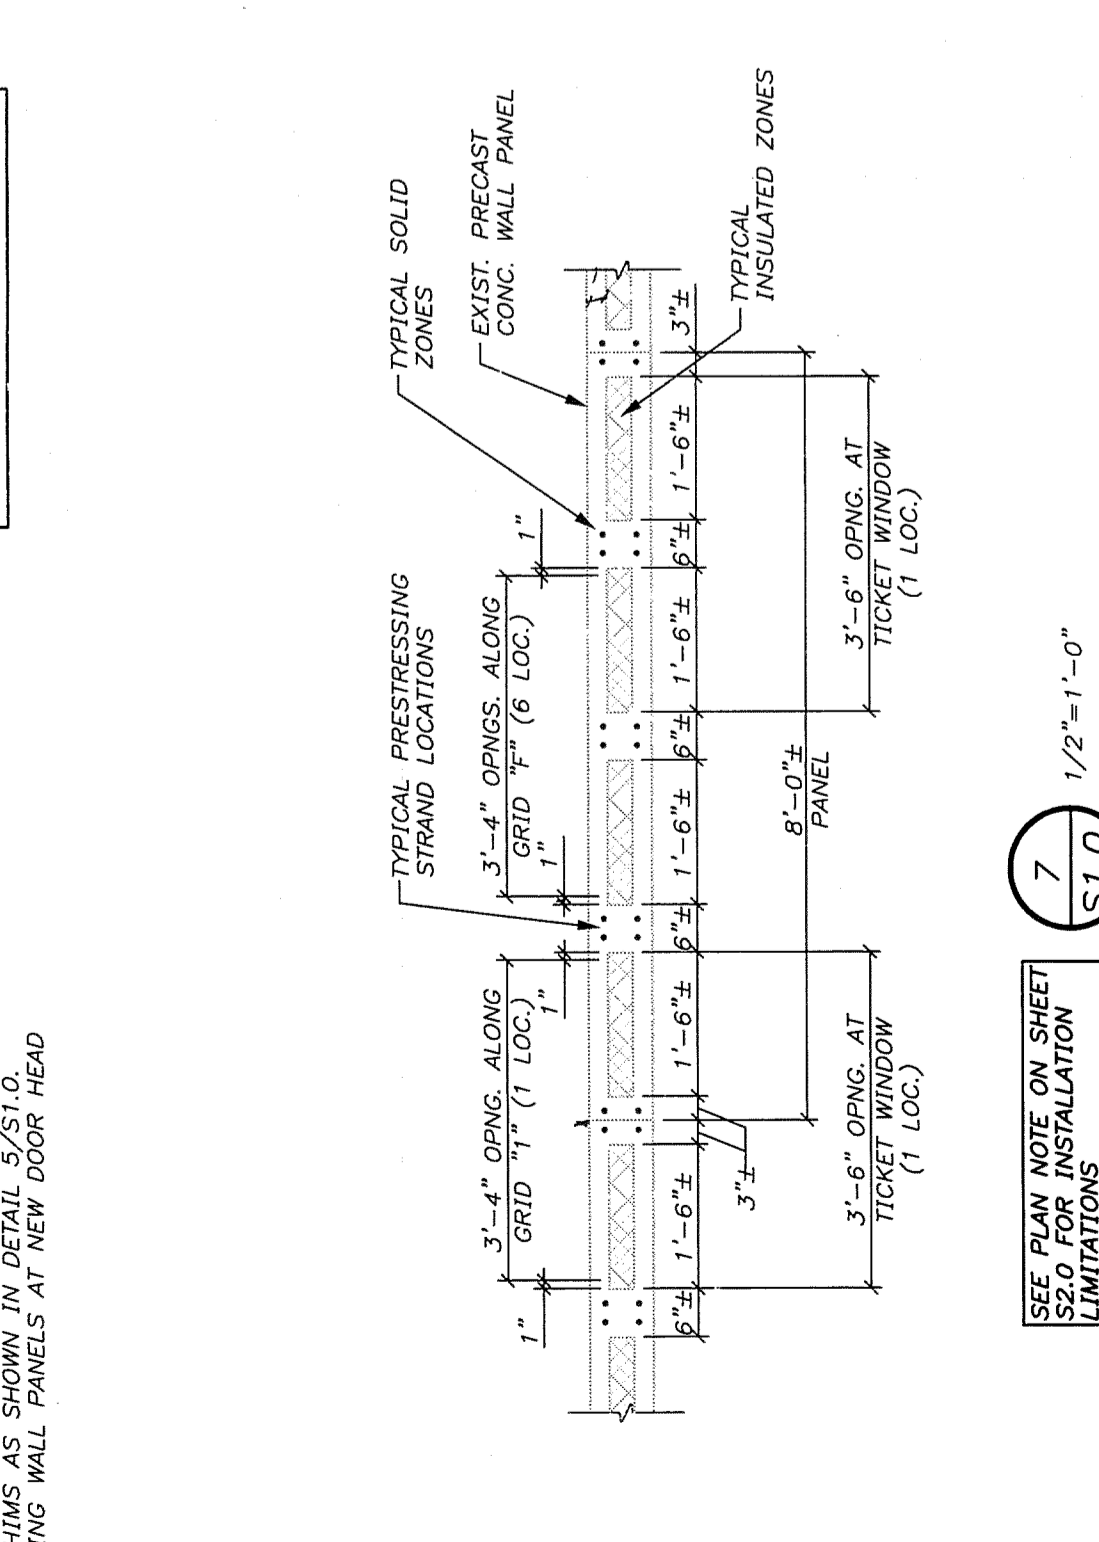


3


5

7


5

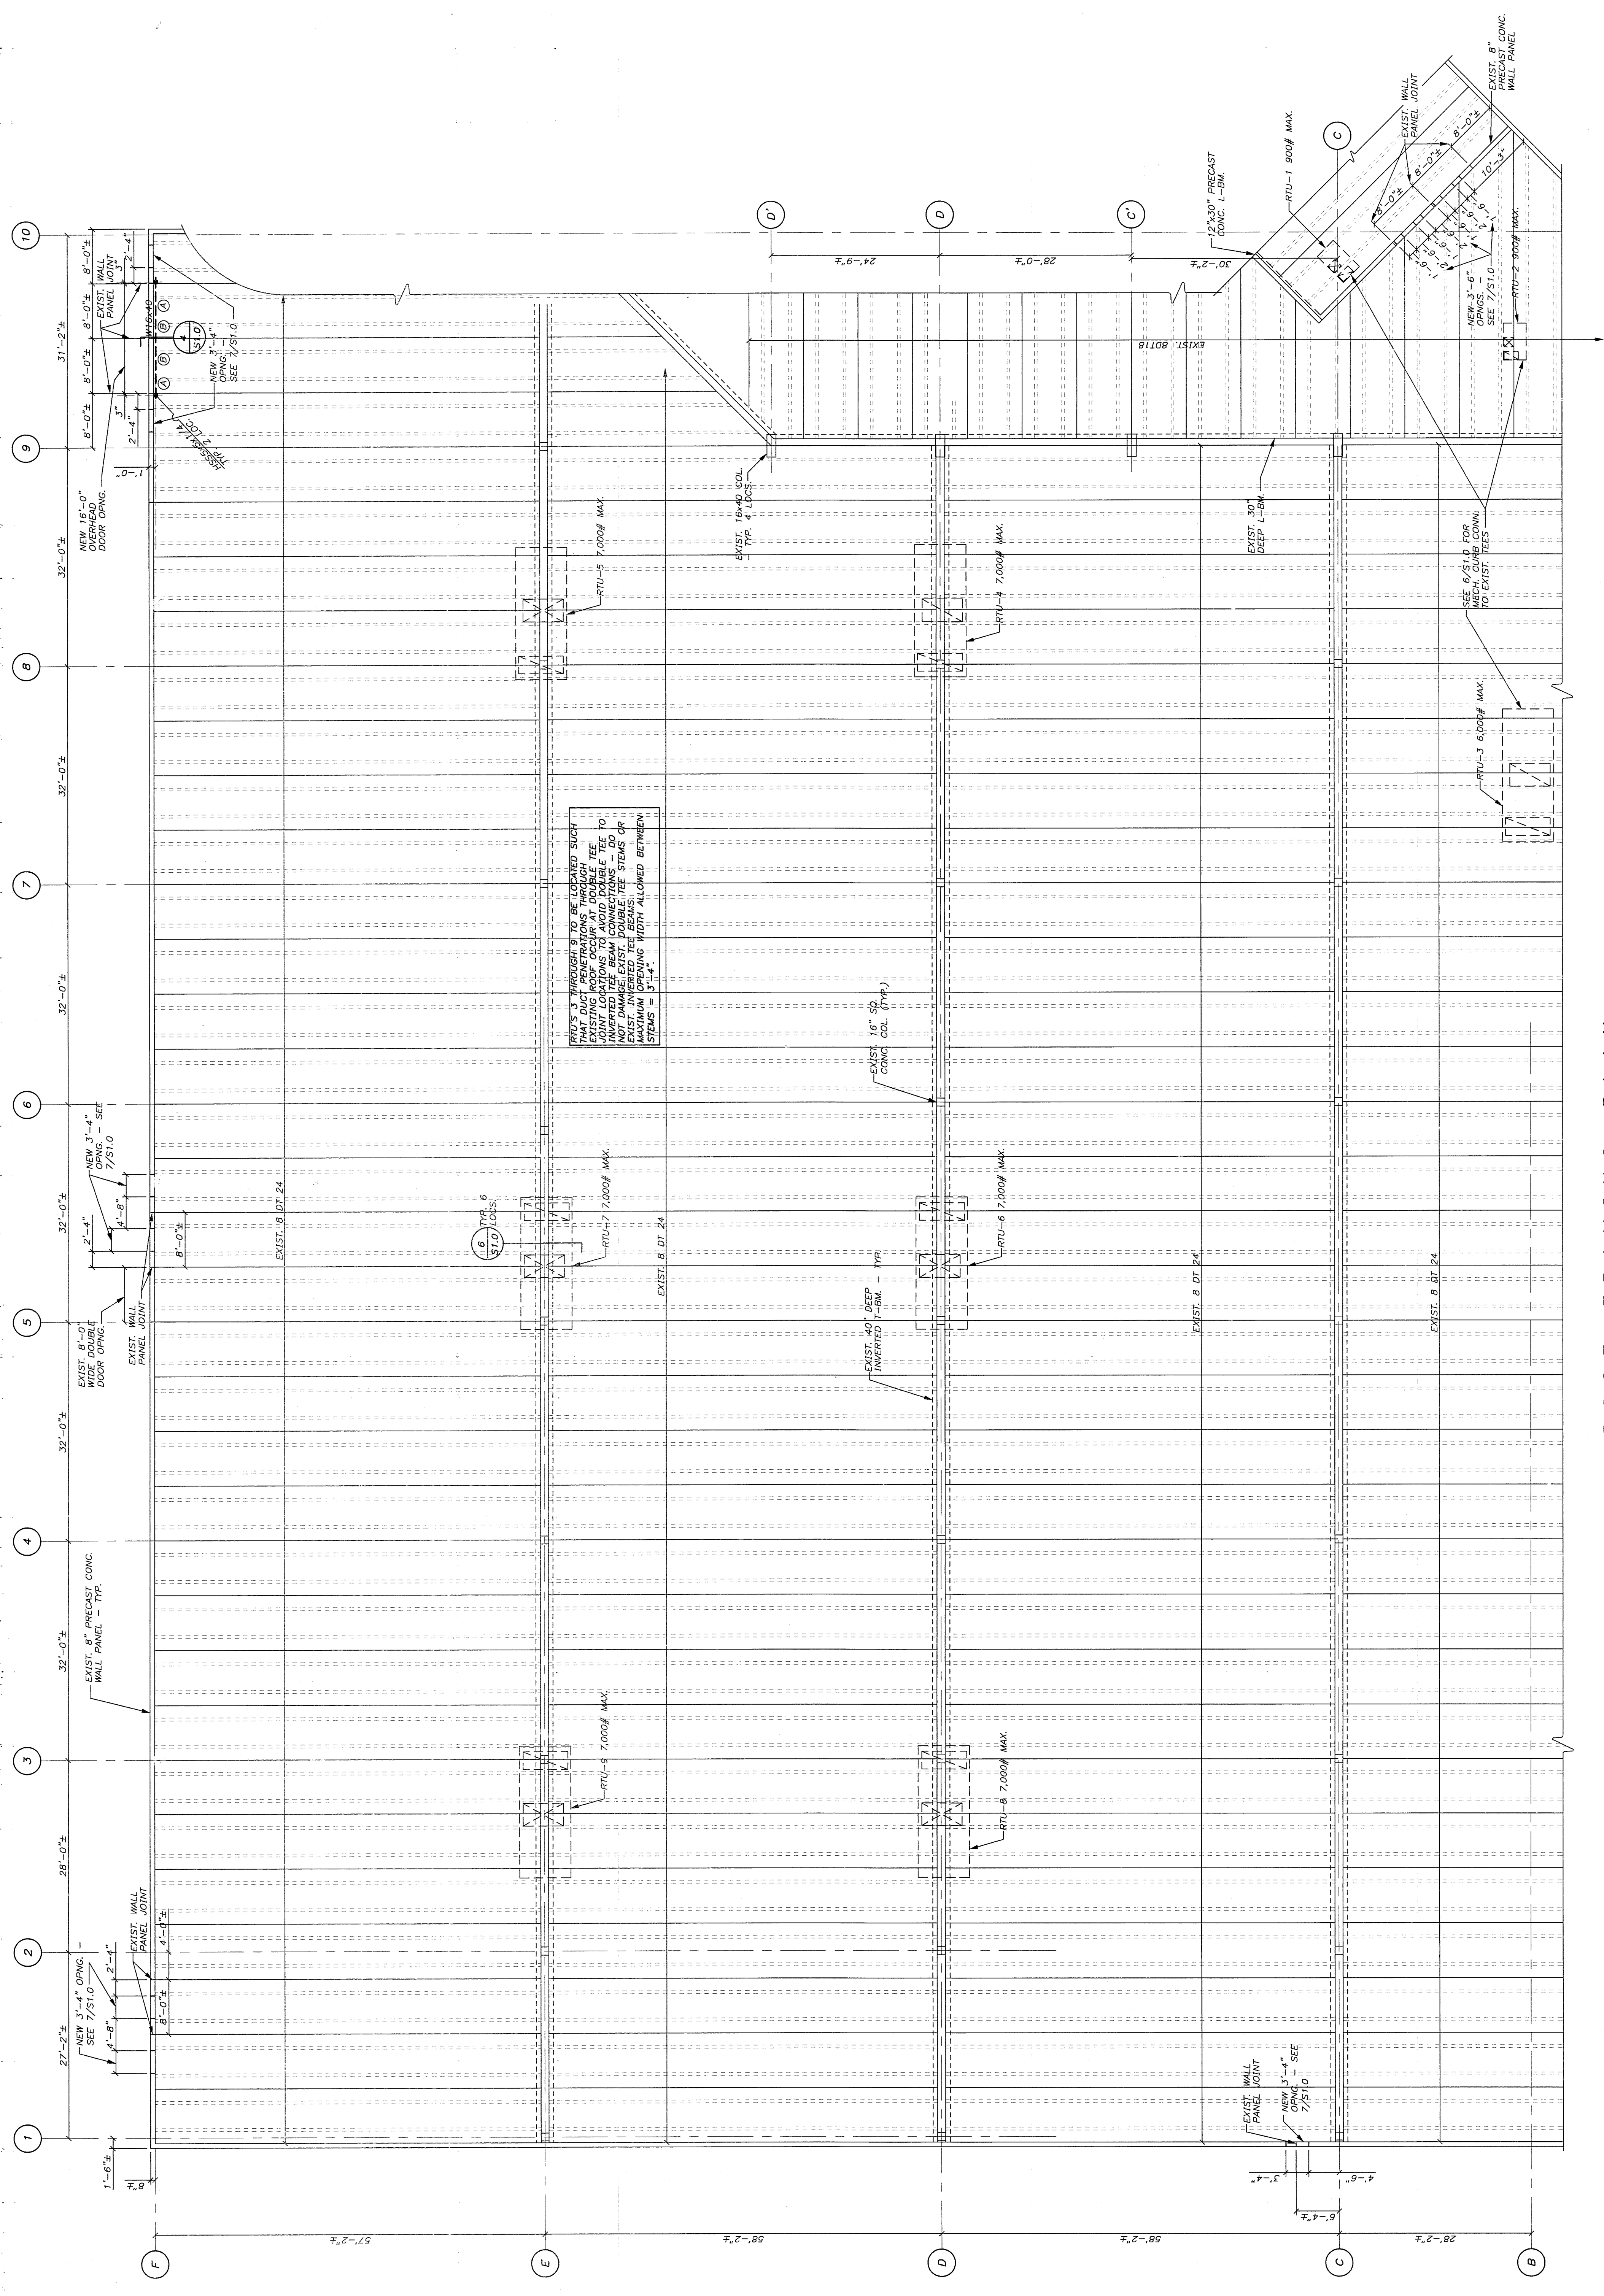

**ROOF FRAMING PLAN**  
 \*NEW OPENING LOCATIONS IN EXISTING PRECAST PANELS ARE BASED ON EXISTING PRECAST DRAWINGS. THE STRUCTURAL INTENT IS TO MAINTAIN THE 6" WIDE LOCATIONS. BEFORE CUTTING OPENINGS, CONTRACTOR SHALL DRILL 1/2" PILOT ARE BEING CUT AT INSULATED ZONES OF WALL PANELS. DO NOT OVERCUT CORNERS. SEE DETAIL 7/S1.0.

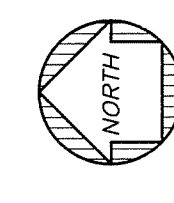

**DUCTWORK LEGEND - CONSTANT VOLUME SYSTEMS**

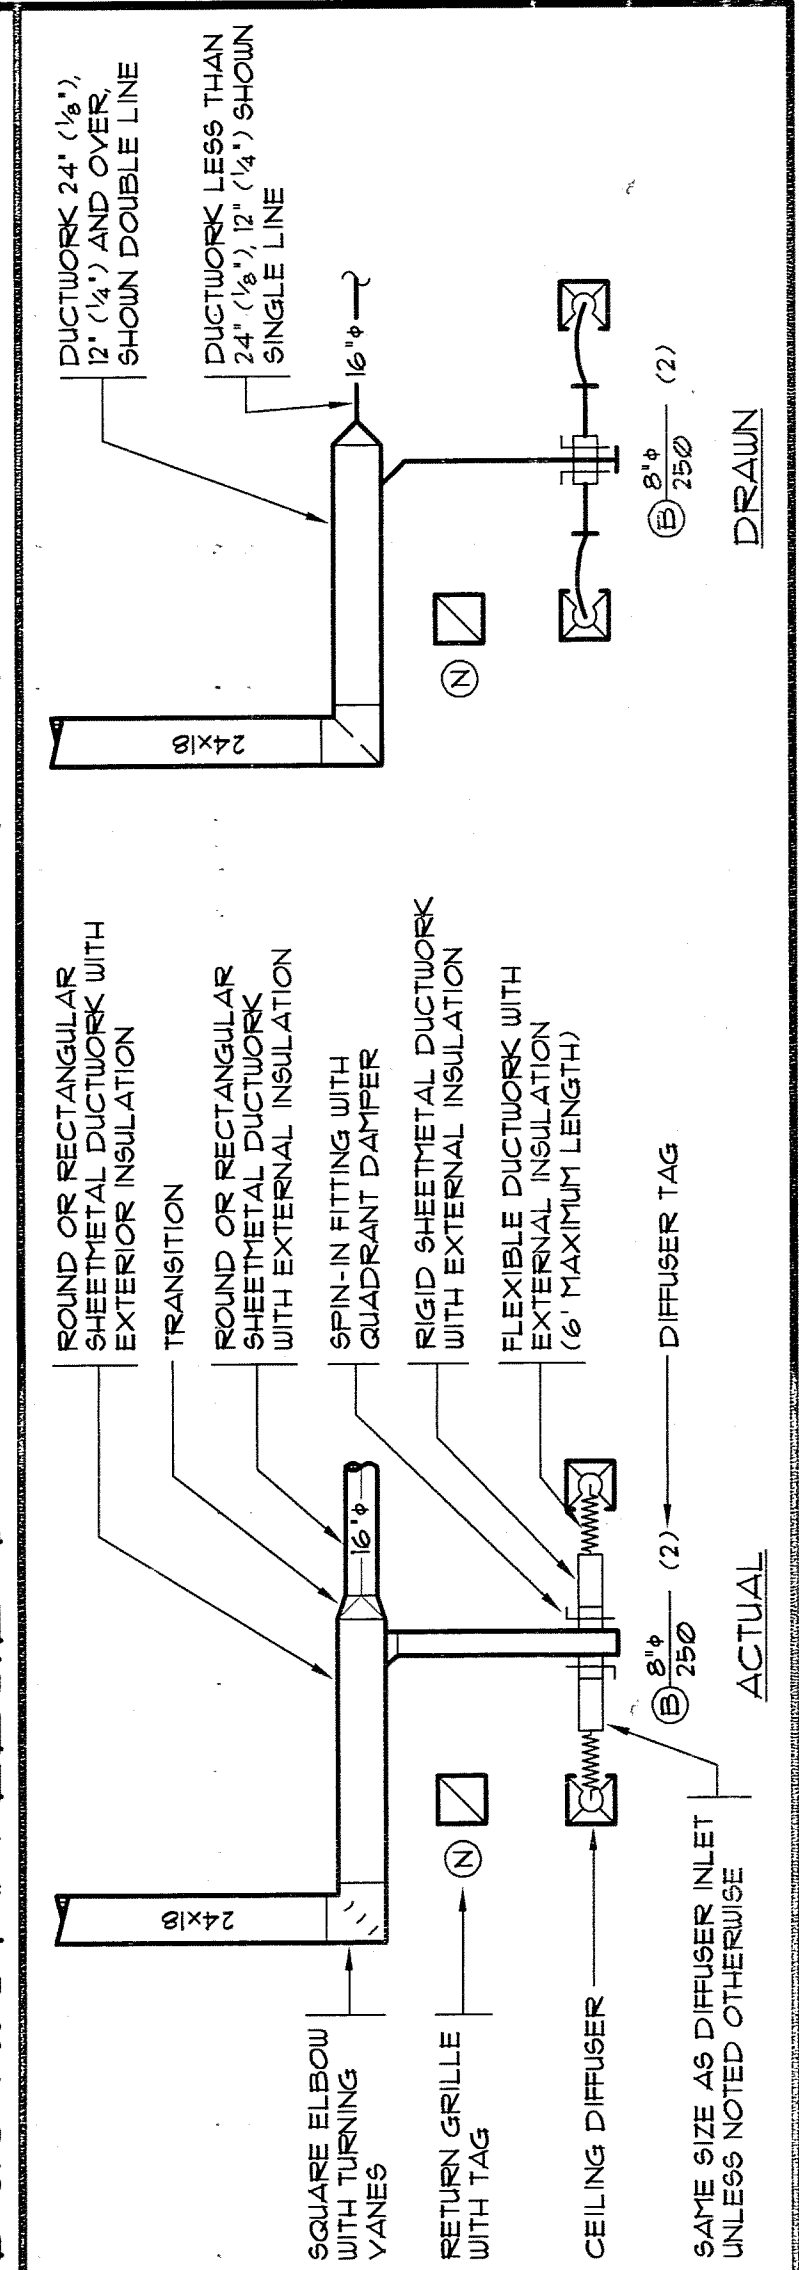

ABBR	SYMBOL	DESCRIPTION
HW, HUR	(Symbol: Two parallel lines with a wavy line between them)	HOT WATER SUPPLY AND RETURN PIPING
GP (S PRIG)	(Symbol: Dashed line with a wavy line)	PRESSURE GAS PIPING AND PRESSURE GAS PIPING ON ROOF (DASHED)
	(Symbol: Dashed line)	UNION FLANGE BLIND FLANGE
	(Symbol: Dashed line with a cross)	SOV GATE VALVE, BALL VALVE, GLOBE VALVE, BUTTERFLY VALVE
	(Symbol: Dashed line with a triangle)	CHECK VALVE, STRAINER
	(Symbol: Dashed line with a circle)	PLUG VALVE, CALIBRATED AND DYNAMIC BALANCING VALVES
	(Symbol: Dashed line with a diamond)	LIBRATED PLUG VALVE
	(Symbol: Dashed line with a square)	THREE-WAY CONTROL VALVE, SOLING
	(Symbol: Dashed line with a circle and a line)	ANGLE RELIEF VALVE, GAUGE AND COCK, THERMOMETER
AAV / TAV, HAV	(Symbol: Circle with a triangle pointing up)	HOLE END DRAIN VALVE, AUTOMATIC AIR / MANUAL AIR VENT
	(Symbol: Circle with a triangle pointing down)	PIPE ELBOW DOWN PIPE TEE DOWN PIPE TEE UP PIPE ELBOW UP
	(Symbol: Circle with a triangle pointing left)	PIPE ANCHOR, PIPE GUIDE, PIPE SLEEVE
	(Symbol: Two parallel lines with a wavy line between them)	FLEX CONNECTION, PIPE EXPANSION JOINT
	(Symbol: Square with a wavy line)	SQUARE DUCT ELBOW WITH TURNING VANES
	(Symbol: Dashed line with a wavy line)	DOWN AND BACK UP UNDER BEAM OR OBSTACLE
	(Symbol: Dashed line with a wavy line and a circle)	SUPPLY AIR RETURN/OUTSIDE AIR AND EXHAUST AIR
	(Symbol: Dashed line with a wavy line and a square)	DUCTWORK UNLINED AND DUCTWORK LINED
	(Symbol: Dashed line with a wavy line and a triangle)	FLEXIBLE AND RIGID ROUND DUCT
	(Symbol: Dashed line with a wavy line and a diamond)	FIRE, SMOKE, COMBINATION FIRE AND SMOKE, RADIATION SMOKE AND RADIATION DAMPERS
	(Symbol: Dashed line with a wavy line and a circle with a cross)	BARKOMETRIC, POTORIZED AND MANUAL DAMPERS, SMOKE DETECTOR
T, H, RD, TT, AG	(Symbol: Circle with a triangle pointing up)	TEMPERAT, HUMIDITAT SMOKE DETECTOR, TEMPERATURE TRANSMITTER, AIR QUALITY SENSOR
AP	(Symbol: Circle with a triangle pointing up)	ACCESS PANEL, ACCESS PANEL IN DUCT
SA, RA, EA, CA, CA, HA	(Symbol: Circle with a triangle pointing up)	SUPPLY, RETURN, EXHAUST, OUTSIDE COMBUSTION AIR AND MAKE-UP AIR
	(Symbol: Circle with a triangle pointing up)	WORK NOTE 1, REVISION NO. 1, DEPOSITION NOTE 1, POINT OF CONNECTION
	(Symbol: Circle with a triangle pointing up)	SUPPLY AIR, RETURN AIR, EXHAUST AIR, FLOW AIRWAYS
	(Symbol: Circle with a triangle pointing up)	SECTION A ON SHEET M-1 DIAGRAM 1 ON SHEET M-1 RISER R-1 ON SHEET M-1
	(Symbol: Circle with a triangle pointing up)	EQUIPMENT TYPE EQUIPMENT NUMBER

**DRAWING INDEX**

NUMBER	DRAWING TITLE	DATE
1001	DRAWING INDEX - GENERAL NOTES AND LEGENDS	05/26/11
1002	SCHEDULES	05/26/11
1003	DIAGRAMS	05/26/11
1004	PARTIAL FLOOR PLAN - HVAC	05/26/11
1005	PARTIAL FLOOR PLAN - HVAC	05/26/11
1006	ROOF PLAN - HVAC	05/26/11

**DUCT SYSTEM NOTES**


- ALL DUCTWORK UNLESS SPECIFICALLY INDICATED SHALL BE GALVANIZED SHEET METAL INSTALLED IN ACCORDANCE WITH THE SPACNA DUCT CONSTRUCTION STANDARDS.
- SYSTEMS DUCTWORK - PRESSURE CLASS '0', SEAL CLASS 'B'. DIMENSIONS SHOWN ARE NET CLEAR INSIDE DIMENSIONS. ALLOWANCES MUST BE MADE FOR DUCT LINER WHERE CALLED FOR.
- SOUND ATTENUATE ALL SUPPLY AND RETURN FLENTH DUCTWORK OF EACH AIR HANDLING UNIT WITH 1/2" DENSITY INTERNAL DUCT LINER.
- ALL SUPPLY DUCTWORK SHALL HAVE DUCTHATE OR ALL JOINTS SEALED WITH 'HARDCAST' OR EQUAL DUCT SEALER/MASTIC.
- ALL EXPOSED ROUND DUCTWORK SHALL BE GALVANIZED SHEET METAL 8" X 14" WITH PAINT GRIP COATING.
- ALL CONCEALED ROUND SUPPLY AIR DUCTS 7" AND SMALLER SHALL BE GALVANIZED SHEET METAL SNAP-LOCK ROUND SUPPLY DUCT GREATER THAN 7" SHALL BE GALVANIZED SHEET METAL SPIRAL, PROVIDE 1" FIBERGLASS INSULATION UNWAP. INSULATED FLEXIBLE DUCT MAY BE USED FOR THE CONNECTION TO THE AIR OUTLET PROVIDED THE LENGTH OF THE FLEXIBLE DUCT DOES NOT EXCEED 6' LINER FEET.
- FACTORY MADE AIR DUCTS SHALL CONFORM TO UL 181 AND INCLUDE APPROPRIATE LABEL. FLEXIBLE DUCTWORK SHALL BE APPROVED CLASS 0 OR CLASS 1. LENGTH NOT TO EXCEED 6'-0".
- ALL BRANCH DUCT CONNECTIONS TO AIR OUTLETS, AIR INLETS, VARIABLE VOLUME TERMINALS AND BOXES SHALL BE THE SAME SIZE AS THE DEVICE NECK UNLESS SHOWN OTHERWISE ON THE DRAWINGS.
- ALL ENVIRONMENTAL AIR EXHAUST DUCTS SHALL BE SEALED WITH 'HARDCAST' OR EQUAL WITH NO DUCT LINER EXCEPT WHERE INDICATED. WHEN THESE DUCTS ARE LOCATED IN A FLENTH, THEY MUST BE SLEEVED OR BE UNDER NEGATIVE PRESSURE.
- DUCT HANGERS SHALL BE A MINIMUM 1/2" X 1/2" GAUGE GALVANIZED STEEL.
- DUCT HANGER SINGLE THICKNESS TURNING VANES IN ALL SQUARE AND RECTANGULAR ELBOUS IN SUPPLY, RETURN AND GENERAL EXHAUST SYSTEMS.
- COMBINATION FIRE/SMOKE FIRE DAMPERS WITH ACCESS DOORS SHALL BE INSTALLED IN RATED CONSTRUCTION AS REQUIRED. MINIMUM REQUIREMENT FOR DAMPERS IS CLASS 2. ALL FIRE DAMPERS SHALL BE LABELED FOR USE IN DYNAMIC SYSTEMS UNLESS OTHERWISE SPECIFIED.

**GENERAL NOTES - HVAC**

- RESOLVE ALL QUESTIONS OR CONFLICTS WITH ENGINEER BEFORE ANY EQUIPMENT IS ORDERED, MATERIALS FABRICATED OR SYSTEMS INSTALLED.
- COORDINATE THE INSTALLATION OF MECHANICAL SYSTEMS WITH OTHER TRADES, ESPECIALLY STRUCTURAL, PLUMBING, ELECTRICAL AND ARCHITECTURAL CEILING HEIGHTS.
- COORDINATE ALL PENETRATIONS THROUGH STRUCTURAL MEMBERS WITH THE GENERAL CONTRACTOR.
- COORDINATE AND VERIFY THAT ALL OPENINGS IN WALLS ABOVE CEILING / DOOR LOWERS / DOOR UNDERCUTS ARE PROVIDED AS INDICATED ON THESE DRAWINGS.
- COORDINATE EXACT SIZE OF EQUIPMENT HOUSING PAD WITH EQUIPMENT SMALL FOOTPRINT DIMENSIONS. LEVEL ALL EQUIPMENT CURBS / BASES PRIOR TO INSTALLATION OF ANY EQUIPMENT. INSTALL FULL SIZE CONDENSATE DRAIN WITH TRAP SEAL DEPTH EQUAL TO 1/2" UNIT TOTAL STATIC PRESSURE FOR EACH COOLING COIL. ENSURE THAT THE TOP OF GROUND MOUNTED EQUIPMENT PADS ARE AT LEAST 3" ABOVE FINAL GRADE.
- PROVIDE OFFSETS AS NECESSARY TO ACCOMMODATE STRUCTURE AND OTHER TRADES.
- ALL BUILDING EXHAUSTS/VENTS TO BE MINIMUM 1/2" FROM BUILDING VENTILATION INTAKES.
- SEAL ALL ROOF PENETRATIONS WITH SEALANT/CALKING OR SYSTEM COMPATIBLE WITH ROOFING.
- ALL PIPING PENETRATIONS THROUGH FLOORS SHALL BE SEALED WATER/TIGHT BY GROUTING PERIMETER GAP BETWEEN PIPE AND FLOOR STRUCTURE OR BY USING UL APPROVED SLEEVE AND SEALER SYSTEM. PENETRATIONS OF RATED WALLS SHALL USE SLEEVE WITH UL APPROVED SEALANT.
- ELECTRICAL TO PROVIDE SERVICE OUTLETS WITHIN 25 FEET OF ALL ROOF MOUNTED EQUIPMENT. REFER TO ELECTRICAL DRAWINGS FOR LOCATIONS.
- AIR HANDLING UNITS SHALL BE LABELED AS TO THE AREAS(S) SERVED.
- MATERIALS EXPOSED IN FLENTHS SHALL HAVE A FLAME SPREAD INDEX OF NOT MORE THAN 75 AND A SMOKE DEVELOPED RATINGS OF NOT MORE THAN 50.
- BIND SCREEN UNLESS OTHERWISE SPECIFIED. SHALL BE 1/2" STEEL MESH.
- INSTALLATION SHALL CONFORM TO THE REQUIREMENTS OF THE 2009 INTERNATIONAL MECHANICAL CODE, APPLICABLE SECTIONS OF THE INTERNATIONAL BUILDING CODE.
- OWNER WILL SUPPLY ASBESTOS MATERIALS TESTING AND CLEARANCE REPORTS. ANY MATERIAL SUSPECTED TO CONTAIN ASBESTOS SHALL BE IMMEDIATELY BROUGHT TO THE ATTENTION OF THE OWNER AND A CIRCLED SUSPECTED MATERIALS ENCOUNTERED WILL BE ANALYZED BY OWNER. OWNER WILL PROVIDE NECESSARY DIRECTION IF MATERIAL IS IDENTIFIED AS ASBESTOS.

**GENERAL NOTES - PIPING**

- 1/4" AND SMALLER HEATING AND CHILLED WATER PIPING SHALL BE SCHEDULE 40 STEEL PIPE USING VITCOLOC FITTINGS OR TYPE 1' COPPER PIPING UTILIZING MECHANICAL JOINTS (VETCO) 3/4" AND LARGER PIPE SHALL BE WELDED STEEL PIPE. VALVES 2 1/2" AND SMALLER SHALL BE BALL VALVES, 3" AND LARGER SHALL BE WAFER TYPE BUTTERFLY VALVES. NO DI-ELECTRIC UNIONS PER UCCS STANDARD.
- ALL PIPING SYSTEMS SHALL BE FLUSHED AND PRESSURE TESTED USING INDUSTRY STANDARDS BEFORE INSULATING AND FINAL FILL.
- INSULATE ALL PIPING AS REQUIRED BY 'ECC'. 1" THICK FOR PIPING 1/2" OR SMALLER, 1 1/2" THICK FOR 3/4" AND LARGER HEATING WATER PIPING.

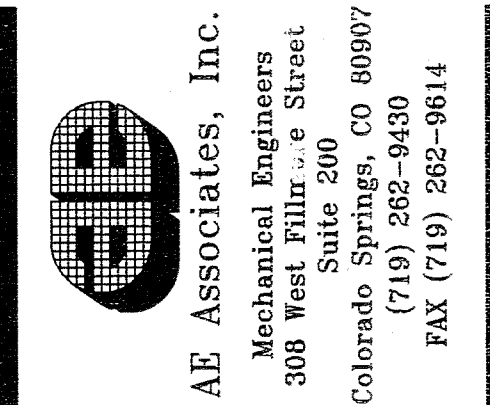

REVISIONS

## PACKAGED ROOF TOP UNIT SCHEDULE

NOTES: 1) 6700 FT. ALTITUDE. 2) DX COOLING 60% REFRIGERANT. 3) HOT GAS BYPASS ON 50% STAGE. 4) FAN MOTOR 115V/1.5/1.5. 5) UNIT EFFICIENCY 80% (20% BURNER EFFICIENCY). 6) MOTOR RUNNING 60% POWER EXHAUST. 7) TRANE TRIGGER CONTROL. 8) 50% PRE-FILTER. 9) SINGLE POINT POWER CONNECTION. 10) DISCONNECT SWITCH. 11) CONVENIENCE CABLE. 12) HIGH EFFICIENCY BLOWER MOTORS. 13) UNIT CBI SENSORS FOR CO-CONTROL.

TAG	DESCRIPTION	MANUF.	MODEL	SEER	EER	CAPACITY		GAS HEATING SECTION		DX COOLING COILS				ELECTRICAL				NOTES				
						CFM	TONS	INBT	OUTBT	EA	EB	EA	EB	EA	EB	EA	EB		EA	EB		
RTU-01	OFFICE	TRANE	TSC-048	13.0	-	1600	4	10/10/0	100	90/8	80/63	50/54	33.1	44.8	10	33	12.5	15	46/0/3	1.1	1.2, 3, 4, 5, 6, 7, 8, 9, 10, 11, 12, 13, 14, 15	
RTU-02	ENTRY	TRANE	TSC-040	13.0	-	2000	5	10/11/0	120	91	80/63	50/54	43.0	56.7	10	33	15.5	25	46/0/3	1.1	1.2, 3, 4, 5, 6, 7, 8, 9, 10, 11, 12, 13, 14, 15	
RTU-03	SUNGS	TRANE	TCD-350	-	10.3	11000	215	10/11/0	456	363	80/63	50/54	273	716	10	15	16.4	50	46/0/3	5.4/6.0	1.2, 3, 4, 5, 6, 7, 8, 9, 10, 11, 12, 13, 14, 15	
RTU-04	EXPO	TRANE	TCD-600	-	10.3	19000	50	10/10/0	510	461	80/63	50/54	394	492	10	20	15	12.2	50	46/0/3	6.9/5	1.2, 3, 4, 5, 6, 7, 8, 9, 10, 11, 12, 13, 14, 15
RTU-05	EXPO	TRANE	TCD-600	-	10.3	19000	50	10/10/0	510	461	80/63	50/54	394	492	10	20	15	12.2	50	46/0/3	6.9/5	1.2, 3, 4, 5, 6, 7, 8, 9, 10, 11, 12, 13, 14, 15
RTU-06	EXPO	TRANE	TCD-600	-	10.3	19000	50	10/10/0	510	461	80/63	50/54	394	492	10	20	15	12.2	50	46/0/3	6.9/5	1.2, 3, 4, 5, 6, 7, 8, 9, 10, 11, 12, 13, 14, 15
RTU-07	EXPO	TRANE	TCD-600	-	10.3	19000	50	10/10/0	510	461	80/63	50/54	394	492	10	20	15	12.2	50	46/0/3	6.9/5	1.2, 3, 4, 5, 6, 7, 8, 9, 10, 11, 12, 13, 14, 15
RTU-08	EXPO	TRANE	TCD-600	-	10.3	19000	50	10/10/0	510	461	80/63	50/54	394	492	10	20	15	12.2	50	46/0/3	6.9/5	1.2, 3, 4, 5, 6, 7, 8, 9, 10, 11, 12, 13, 14, 15
RTU-09	EXPO	TRANE	TCD-600	-	10.3	19000	50	10/10/0	510	461	80/63	50/54	394	492	10	20	15	12.2	50	46/0/3	6.9/5	1.2, 3, 4, 5, 6, 7, 8, 9, 10, 11, 12, 13, 14, 15

## EXHAUST FAN SCHEDULE

NOTES: 1) 3/4" WALL EXHAUST FAN. 2) BACK DRIFT DAMPER. 3) DISCONNECT SWITCH. 4) ALUMINUM BIRDSCREEN. 5) EXISTING AT CURRENT LOCATION. 6) RELOCATED EXHAUST FAN.

TAG	MANUFACTURER	MODEL	AIR QTY CFM	ESP INCH	TYPE	MOUNT	MOTOR HP	VOLTS	NOTES
EF-06	ACHIE	-	1600	0.5	DOWNBLAST	ROOF	1/4	208/1	5
EF-07	ACHIE	-	3600	0.5	DOWNBLAST	ROOF	1/6	208/1	1.2, 3, 6
EF-1A	ACHIE	-	2450	0.5	DOWNBLAST	ROOF	1/2	208/1	2, 5

## PUMP SCHEDULE

NOTES: 1) SUCTON DIFFUSER WITH STRAINER. 2) BASE MOUNTED PUMP. 3) PRIMARY PUMP. 4) EXISTING TO REMAIN. 5) STAND-BY PUMP.

TAG	SERVICE	MANUF.	MODEL	RPPI	FLOU/GPH	HEAD-FT	MOTOR-HP	VOLTS	NOTES
P-01	HEATING WATER	-	-	1760	130	55	5	480/3	4, 5
P-02	HEATING WATER	BAG	B100-15/BC	1760	75	55	3	480/3	1.2, 3

## HYDRONIC BASE BOARD

BASEBOARD IS A COMMERCIAL PRODUCT AND IS EXISTING OR IS TO BE RELOCATED AS NOTED ON DRAWINGS. NEW SELF REGULATING CONTROL VALVE SHALL BE INSTALLED FOR SECTIONS OF BASEBOARD AS INDICATED ON DRAWINGS. VALVES SHALL BE BRACH-PAN OR DANFOSS.

## UNIT HEATER SCHEDULE (HYDRONIC)

NOTES: 1) HOT WATER HORIZONTAL UNIT HEATER. 2) SUSPEND FROM STRUCTURE. 3) OUTPUT SHOWN AT ALTITUDE. 4) INTEGRAL THERMOSTAT.

TAG	MANUF.	MODEL	TYPE	CFM	EUT	LUT	NETUH CAPACITY	FLOU GPH	FLA	WEIGHT	NOTES
UH-01	TRANE	UH-01	HORIZ.	180	180	180	6.0	6.0	51	118	1.1
UH-02	TRANE	UH-02	HORIZ.	180	180	180	6.0	6.0	51	118	1.1

## UNIT HEATER SCHEDULE (GAS FIRED)

NOTES: 1) SEALED COMBUSTION. 2) OPTION REMOVE THERMOSTAT. 3) SUSPEND FROM STRUCTURE WITH ISOLATORS.

TAG	MANUF.	MODEL	INBT	HP	CFM	VOLTS	FLA	WEIGHT	NOTES
UH-03	REZNOR	UDAS 125	125	1/4	DIRECT	116V/1	5.1	180	1.2, 3
UH-04	REZNOR	UDAS 125	125	1/4	DIRECT	116V/1	5.1	180	1.2, 3

## CABINET UNIT HEATER SCHEDULE

NOTES: 1) BOTTOM INLET AND OUTLET. 2) 1/2" FILTER. 3) REMOVE THERMOSTAT. 4) STANDARD 3 ROW COIL. 5) DISCONNECT SWITCH.

TAG	MANUF.	MODEL	SIZE	CFM	EUT	LUT	HIH CAPACITY	FLOU GPH	LAP FT/100	MOTOR HP	ANFS	VOLTS	NOTES
CH-01	TRANE	MODEL "E"	06	600	180	180	20.6	4.5	1.2	1/8	U	118/1	1.2, 3, 4, 5
CH-02	TRANE	MODEL "E"	04	375	180	180	12.2	3.3	10.3	1/2	08	118/1	1.2, 3, 4, 5
CH-03	TRANE	MODEL "E"	04	375	180	180	12.2	3.3	10.3	1/2	08	118/1	1.2, 3, 4, 5
CH-04	TRANE	MODEL "E"	04	375	180	180	12.2	3.3	10.3	1/2	08	118/1	1.2, 3, 4, 5

## GRILLE, REGISTER, AND DIFFUSER SCHEDULE

NOTES: 1) SEE DRAWINGS FOR NECK SIZE AND AIR QUANTITY. 2) WHITE FINISH. 3) SEE DRAWINGS FOR MOUNTING INFORMATION. 4) STEEL OFFSETTED BLADE. 5) T-BAR LAY-IN FOR GRID CEILINGS. 6) PRICE - ACCEPTABLE MANUFACTURER.

TAG	MANUF.	MODEL	DESCRIPTION	NOTES
(A) TT105	THS	TT105	SUPPLY DIFFUSER. 24X24 LOUVERED FACE. STEEL CONSTRUCTION. CEILING MOUNT.	1.2, 3, 5
(B) TT105	DL	DL	SUPPLY DIFFUSER. DRUM LOUVER. STEEL CONSTRUCTION. DUCT MOUNT.	1.2, 3, 4
(C) TT105	50F	50F	RETURN GRILLE. 24X24 EGGRATE ALUMINUM CONSTRUCTION. CEILING MOUNT.	1.2, 3
(D) TT105	50F	50F	RETURN GRILLE. 24X24 EGGRATE ALUMINUM CONSTRUCTION. CEILING MOUNT.	1.2, 3
(E) TT105	350RL	350RL	EXHAUST GRILLE. FIXED BLADE. 3/4" SPACING. STEEL CONSTRUCTION. SURFACE MOUNT.	1.2, 3
(F) TT105	T-1000	T-1000	DOOR TRANSFER GRILLE. 24X24	


## REFRIGERANT COMPLIANCE

PROJECT NAME:	COLO SPRGS EXPO CENTER	
PROJECT NUMBER:	2011202	
DATE:	5/17/2011	
REFRIGERANT:	R410A	
REFRIGERANT QUANTITY ALLOWED (1000-cu-ft):	25 lb	
OCCUPANCY REDUCTION FACTOR:	1 Multiplier	
SPECIFIC OCCUPANCY ALLOWANCE:	25 lb	
REFRIG. SYSTEM	AREA	AREA VOL
RTU-01	OFFICE AREA	16853
RTU-01	OFFICE AREA	1774
RTU-02	MAIN ENTRY	1929
RTU-04	EXPO AREA	82862
RTU-04	EXPO AREA	839854
RTU-01	VOLUME SERVED:	16853 cu-ft
	MAX ALLOWABLE REFRIGERANT:	421 lb
	LARGEST REFRIGERANT CIRCUIT:	7.4 lb
	SYSTEM COMPLIES:	YES
RTU-02	MAIN ENTRY	1929 cu-ft
	VOLUME SERVED:	1929 cu-ft
	MAX ALLOWABLE REFRIGERANT:	332 lb
	LARGEST REFRIGERANT CIRCUIT:	9.3 lb
	SYSTEM COMPLIES:	YES
RTU-04	EXPO AREA	839854 cu-ft
	VOLUME SERVED:	839854 cu-ft
	MAX ALLOWABLE REFRIGERANT:	22466 lb
	LARGEST REFRIGERANT CIRCUIT:	38.2 lb
	SYSTEM COMPLIES:	YES

REVISIONS

SCHEDULES AND DIAGRAMS  
 JOB NO: 1002210  
 DATE: 06/06/11  
 SCALE: AS NOTED  
 DRAWN: CAD  
 CHECKED: RLM

**C S**  
**n a**  
**architects**  
 532 n. tejon st.  
 colorado springs  
 CO 80903  
 P: 719.473.7225  
 F: 719.632.5164  
 W: csnaarchitects.com

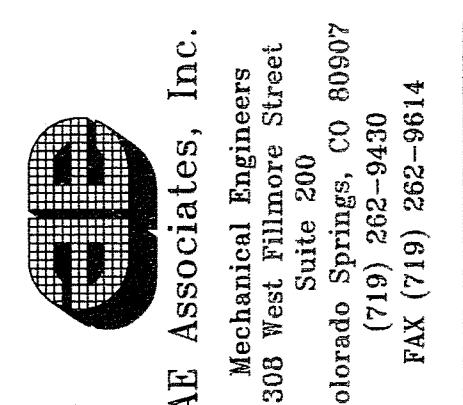


**COLORADO SPRINGS EXPO CENTER**  
 3650 NORTH NEVADA AVE. BUILDING RENOVATION  
 COLORADO SPRINGS, CO


SHEET **MO.2**

DRAWING LIMITS: 42, 30  
 PLOT SCALE: 1/8" = 1'-0"  
 DRAWING NUMBER: 2011202 M02


NO.	DATE	DESCRIPTION

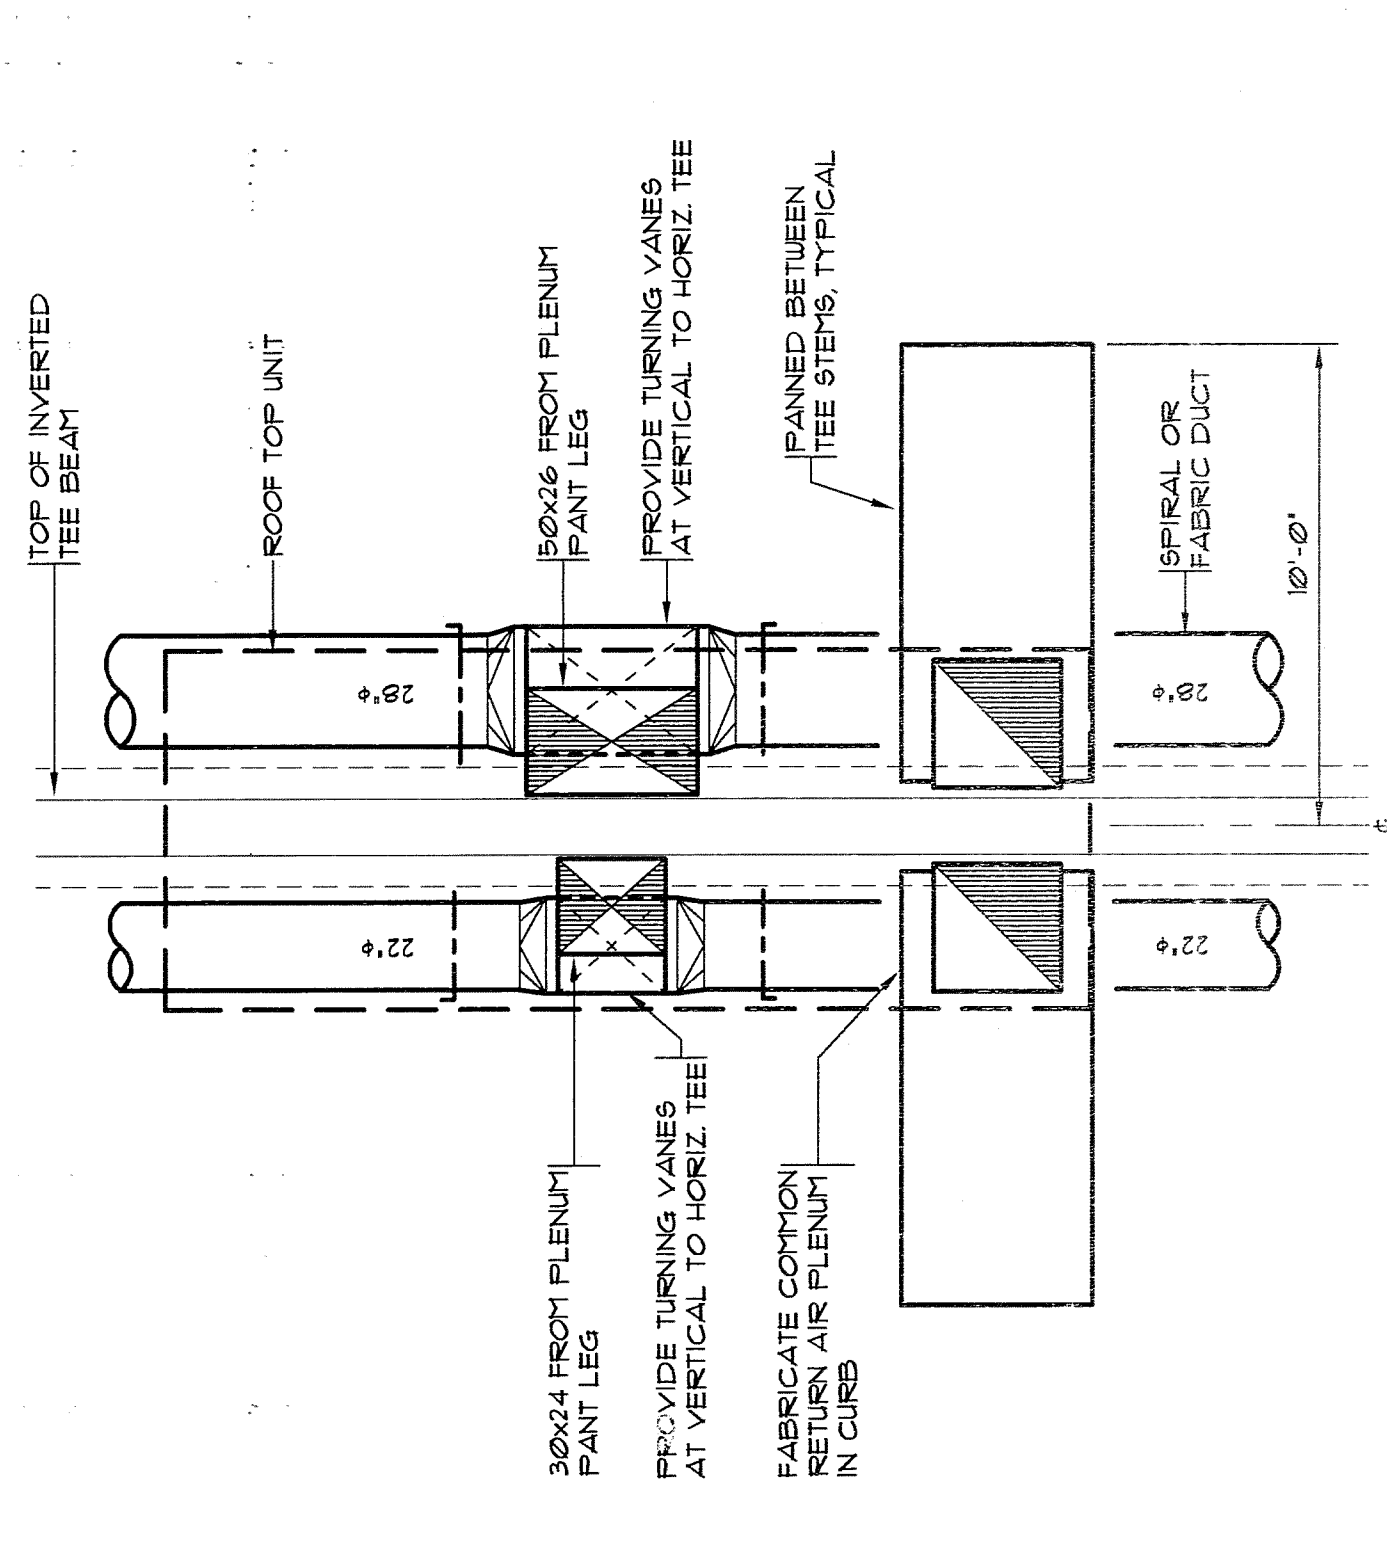


**ENLARGED RTU DUCT CALL OUT**  
SCALE: NONE  
A 10/3

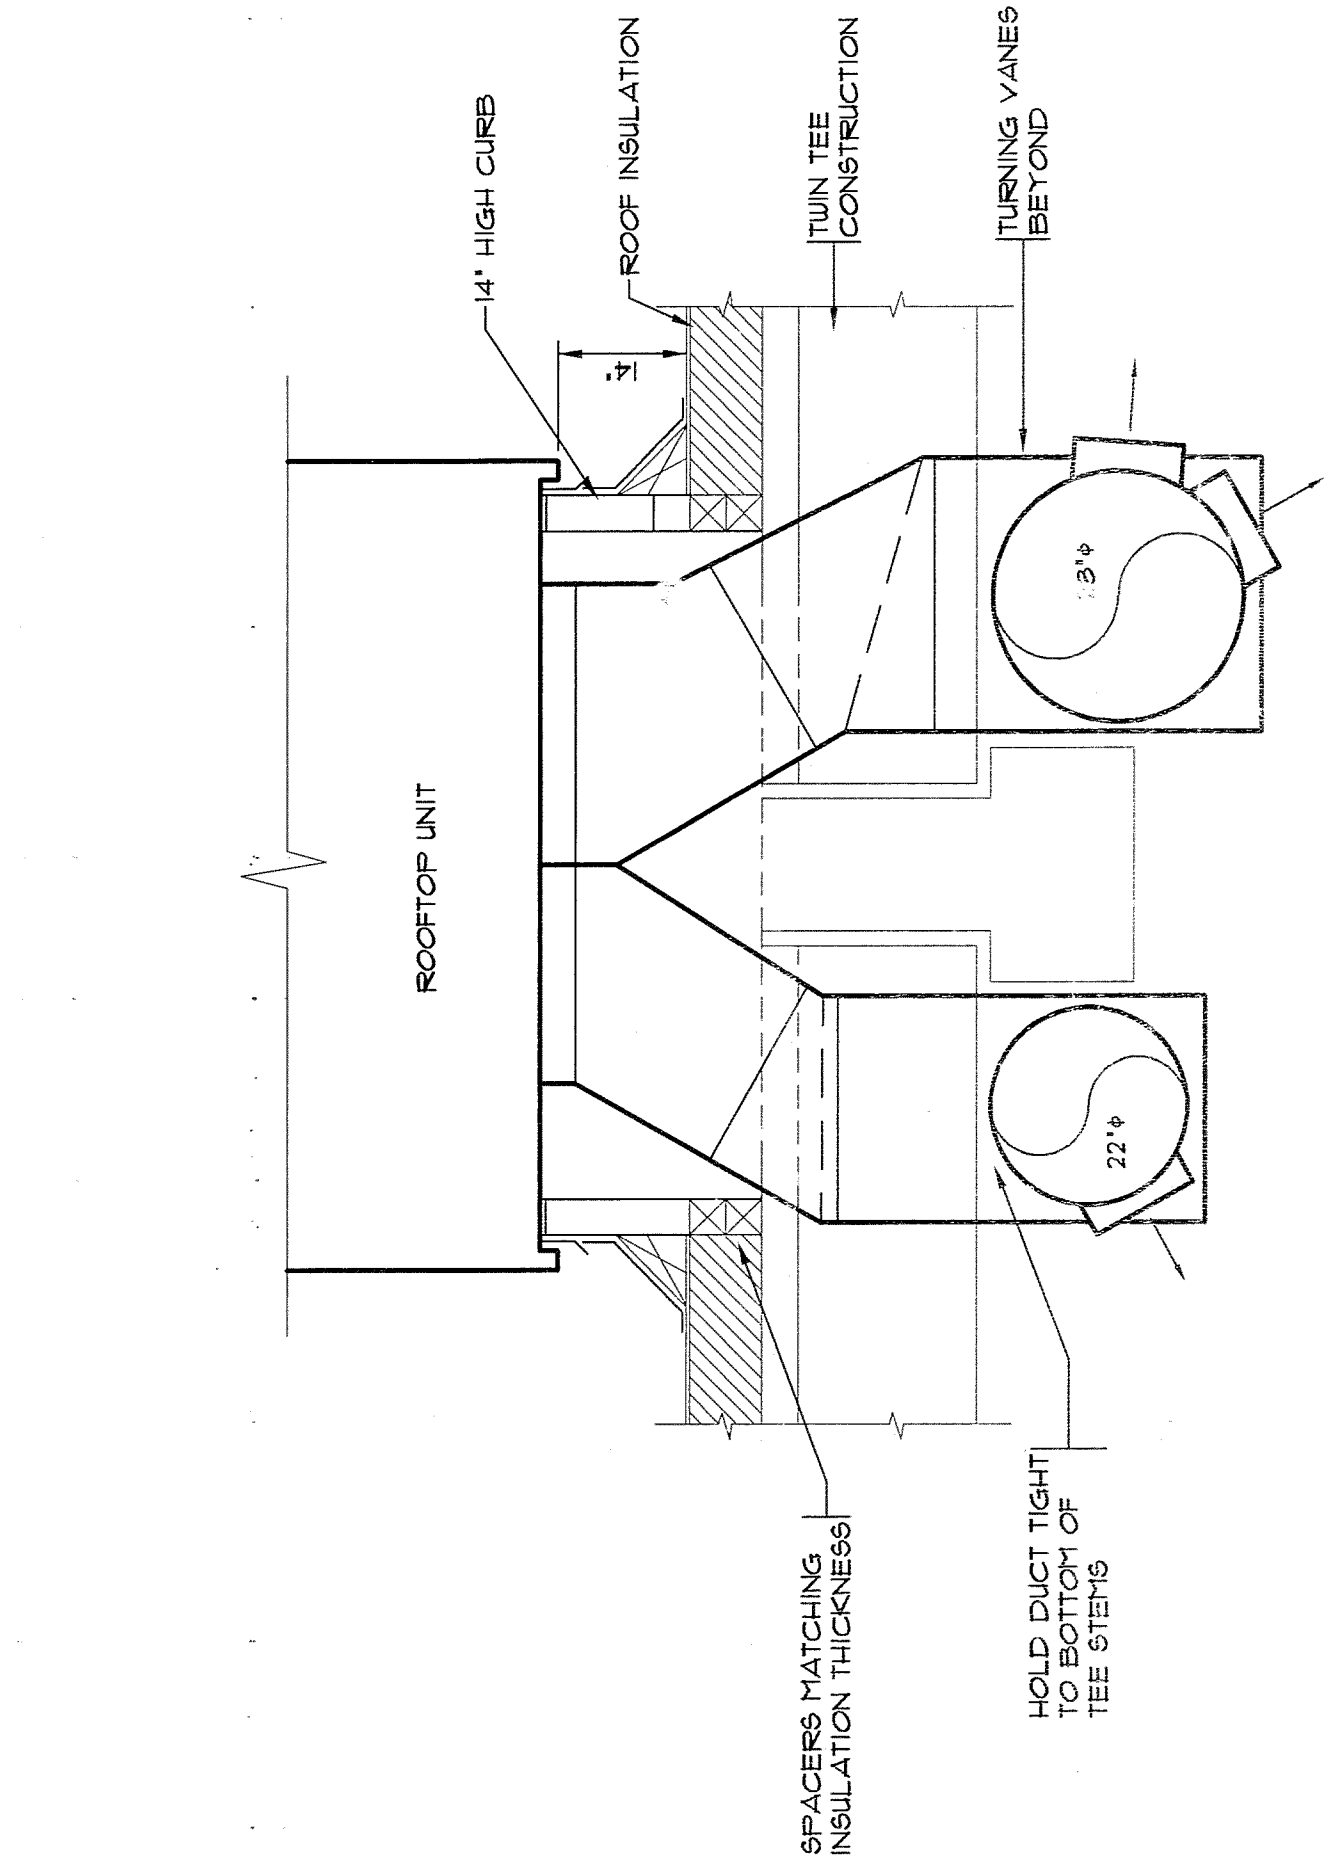


**RETURN DUCTWORK FROM RTU-03 - 09**  
SCALE: NONE  
B 10/3

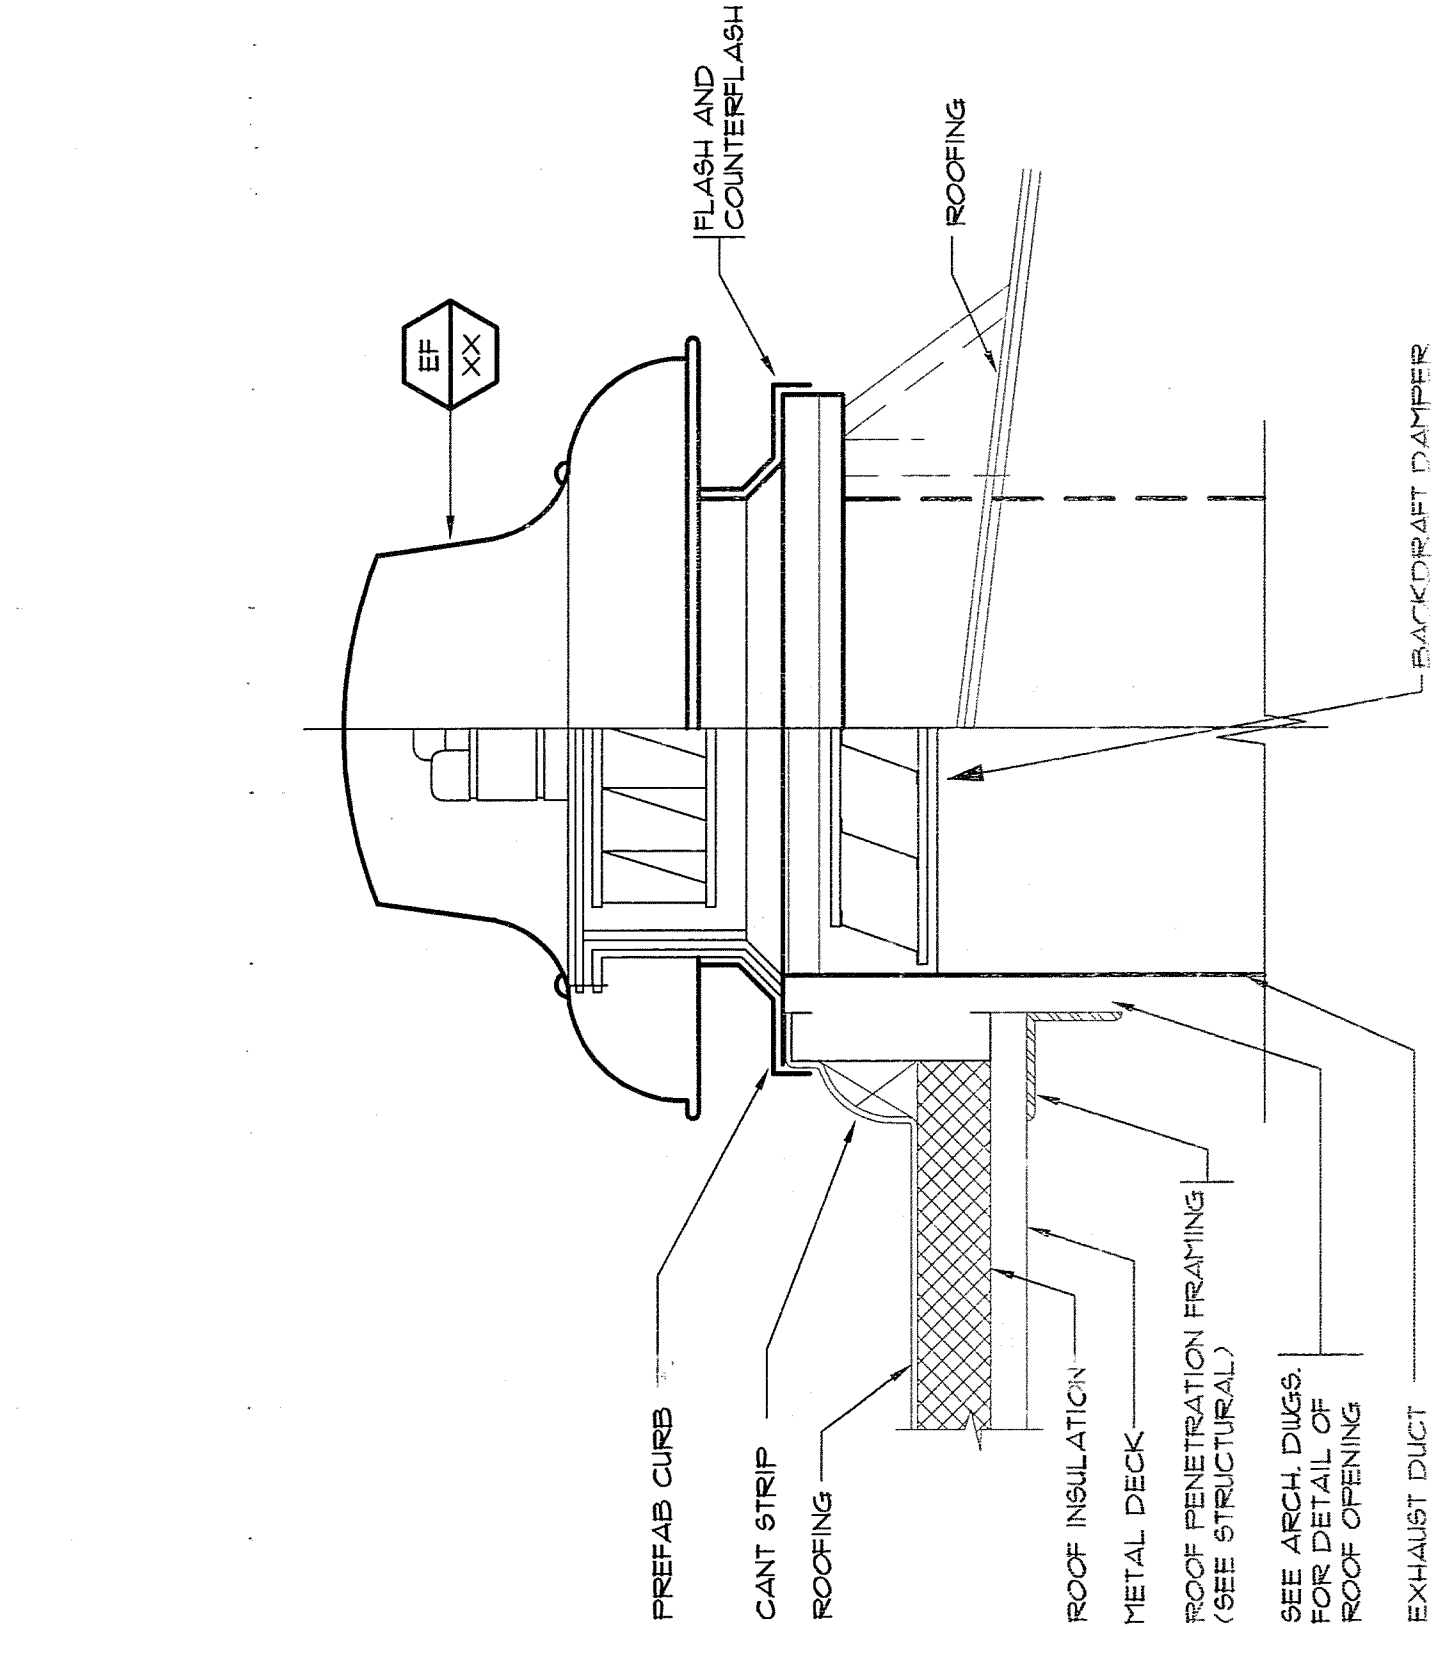


**EXHAUST FAN CURB DIAGRAM**  
SCALE: NONE  
D 10/3

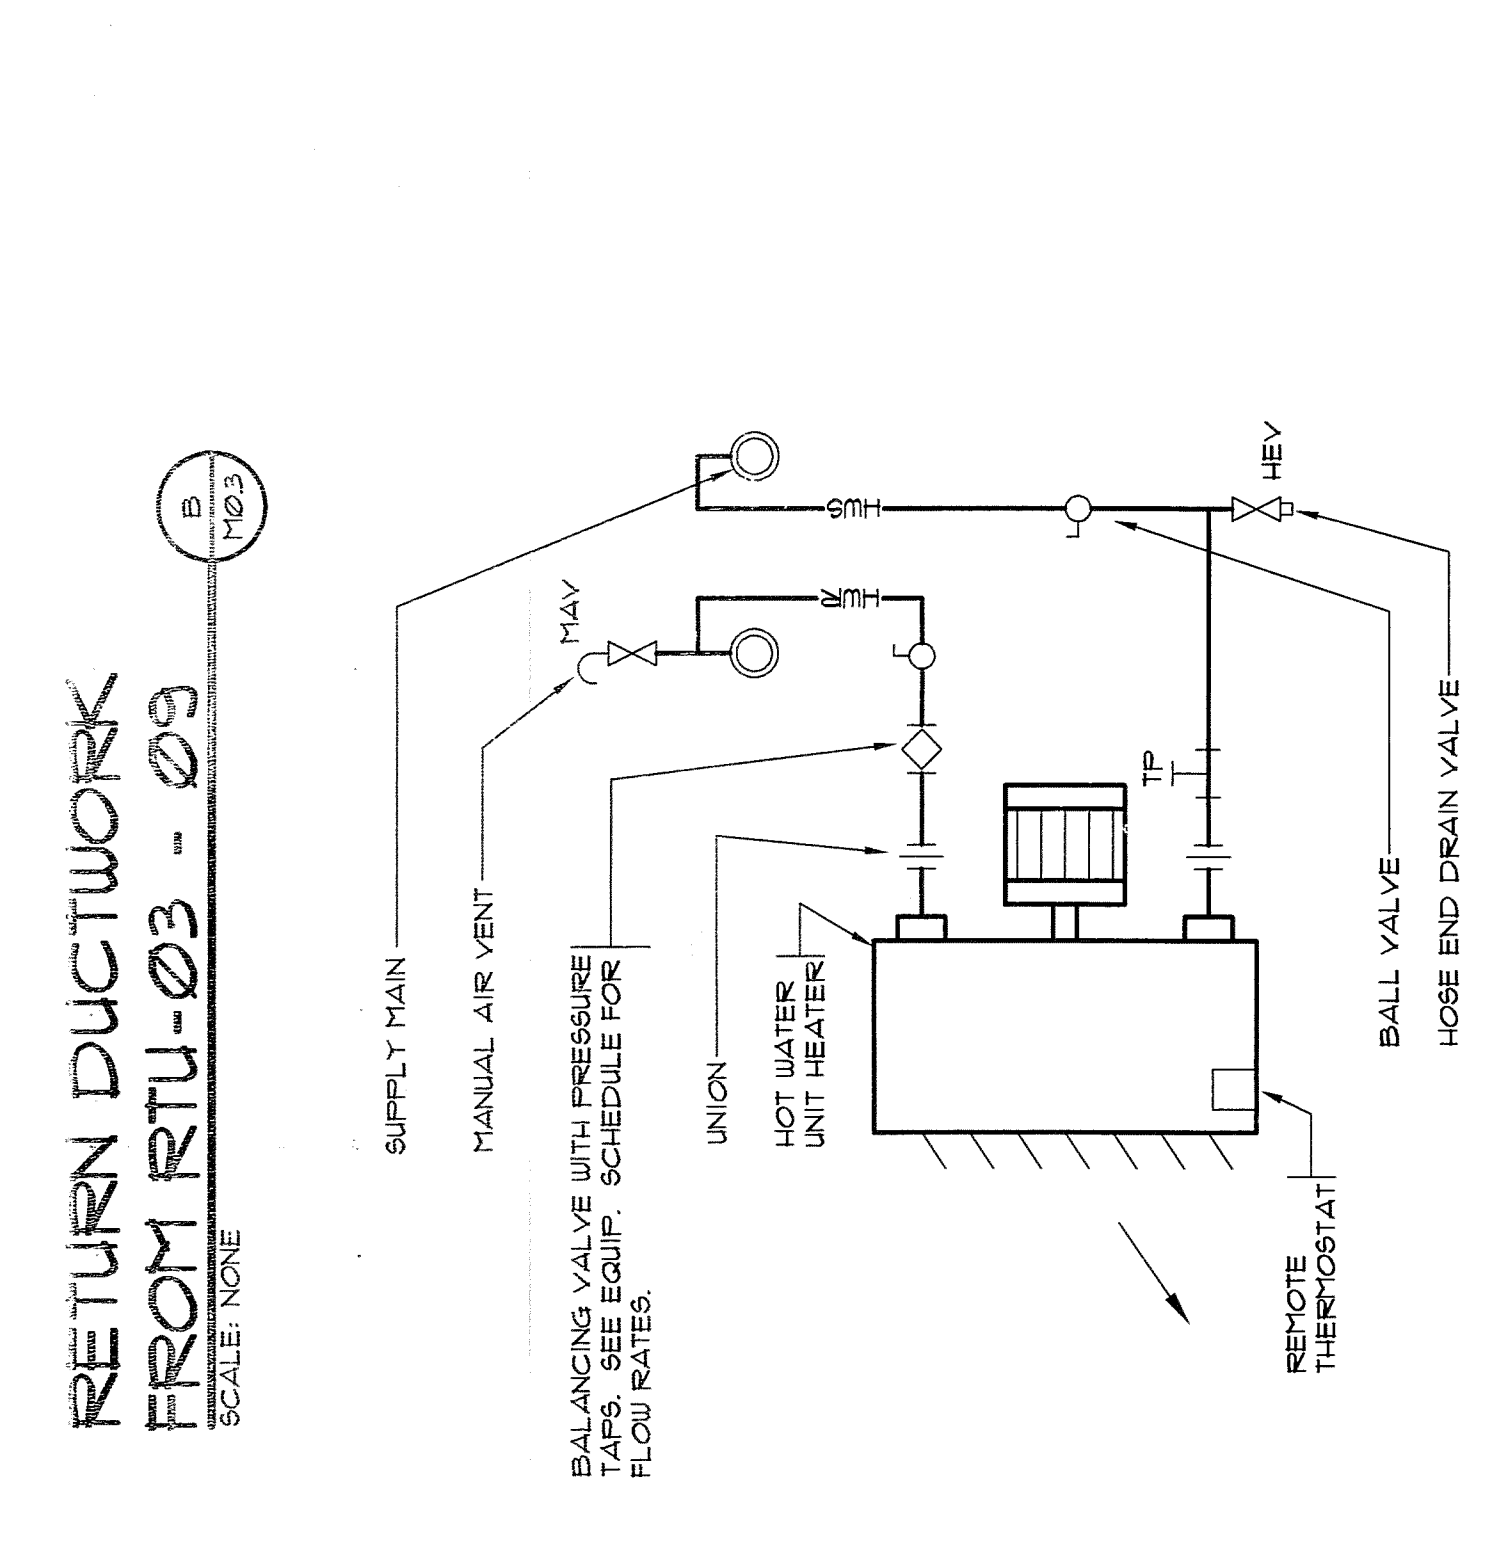


**SUPPLY DUCTWORK FROM RTU-04 - 09**  
SCALE: NONE  
A 10/3

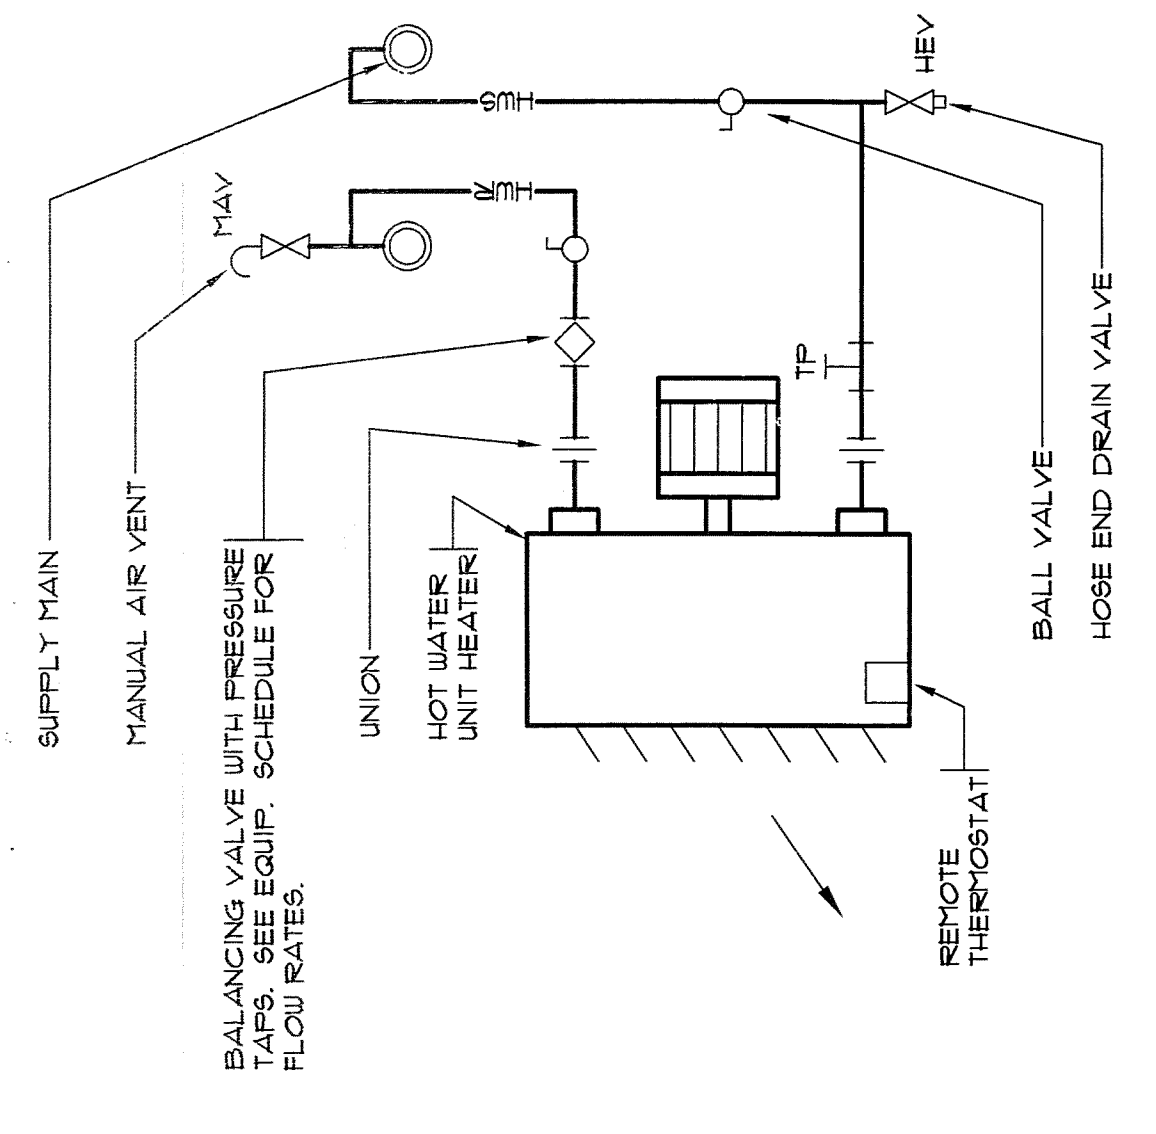


**UNIT HEATER**  
SCALE: NONE  
E 10/3

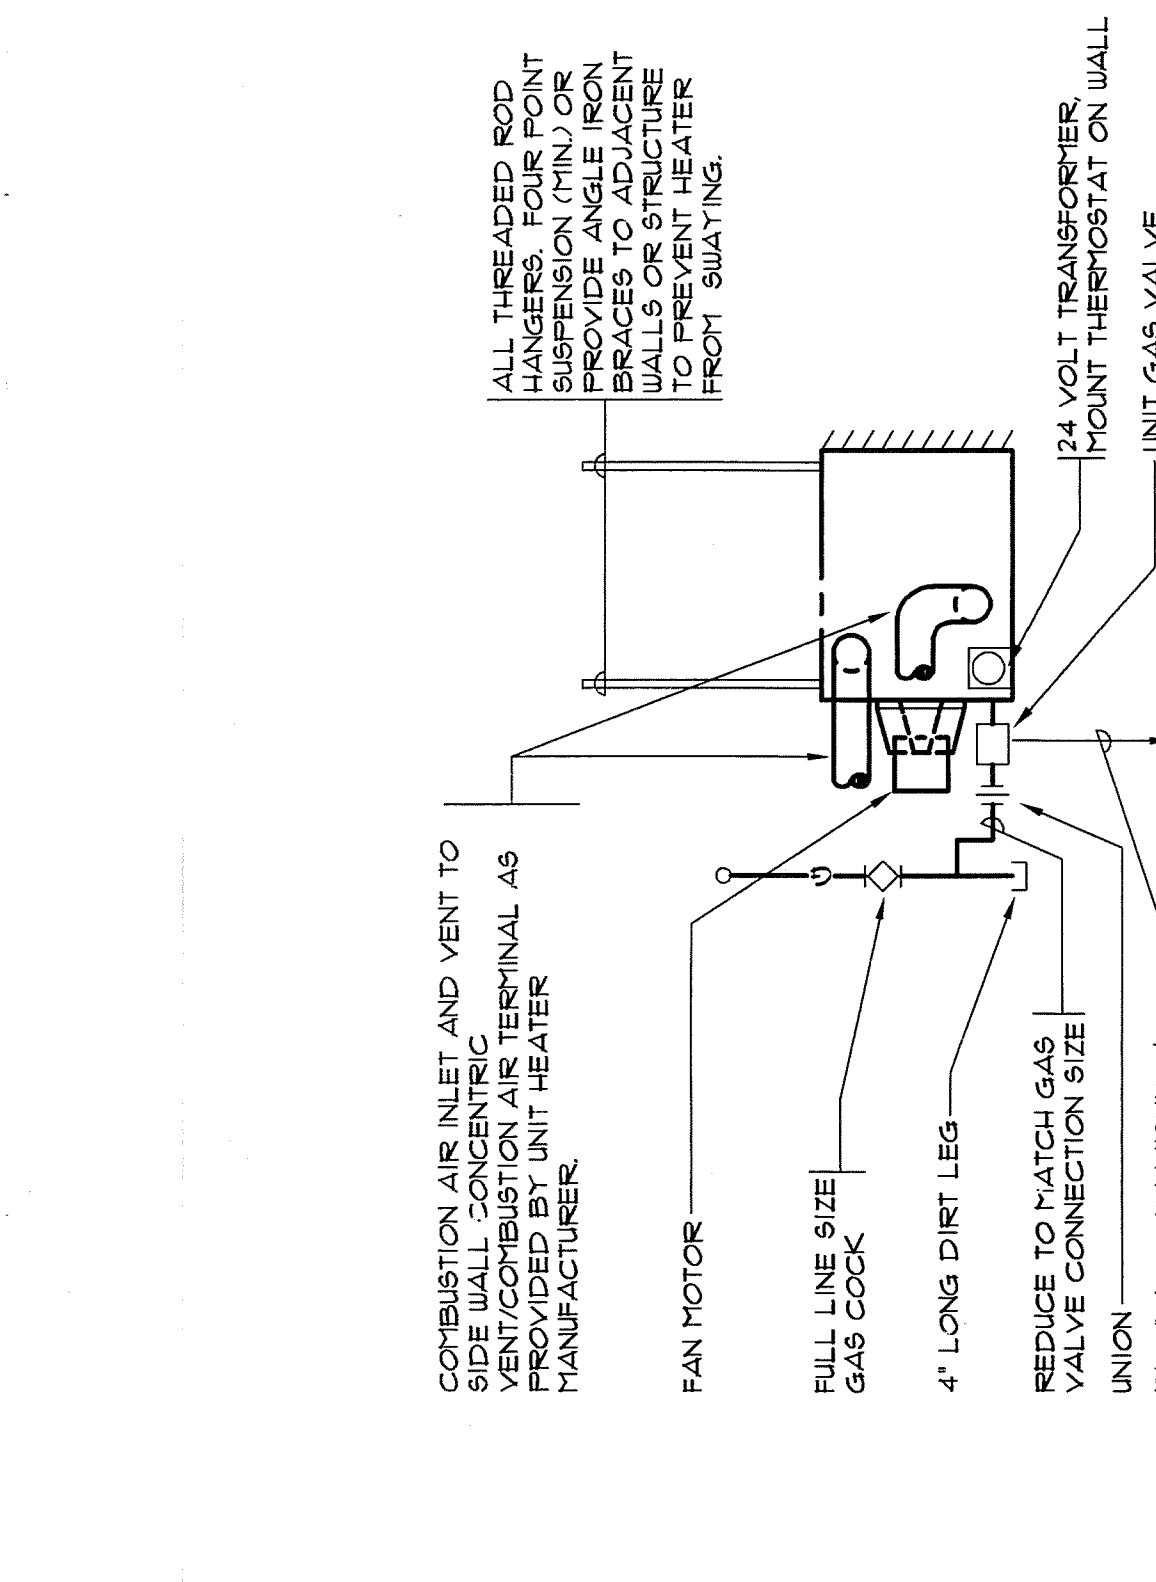


**UNIT HEATER DIAGRAM**  
SCALE: NONE  
G 10/3

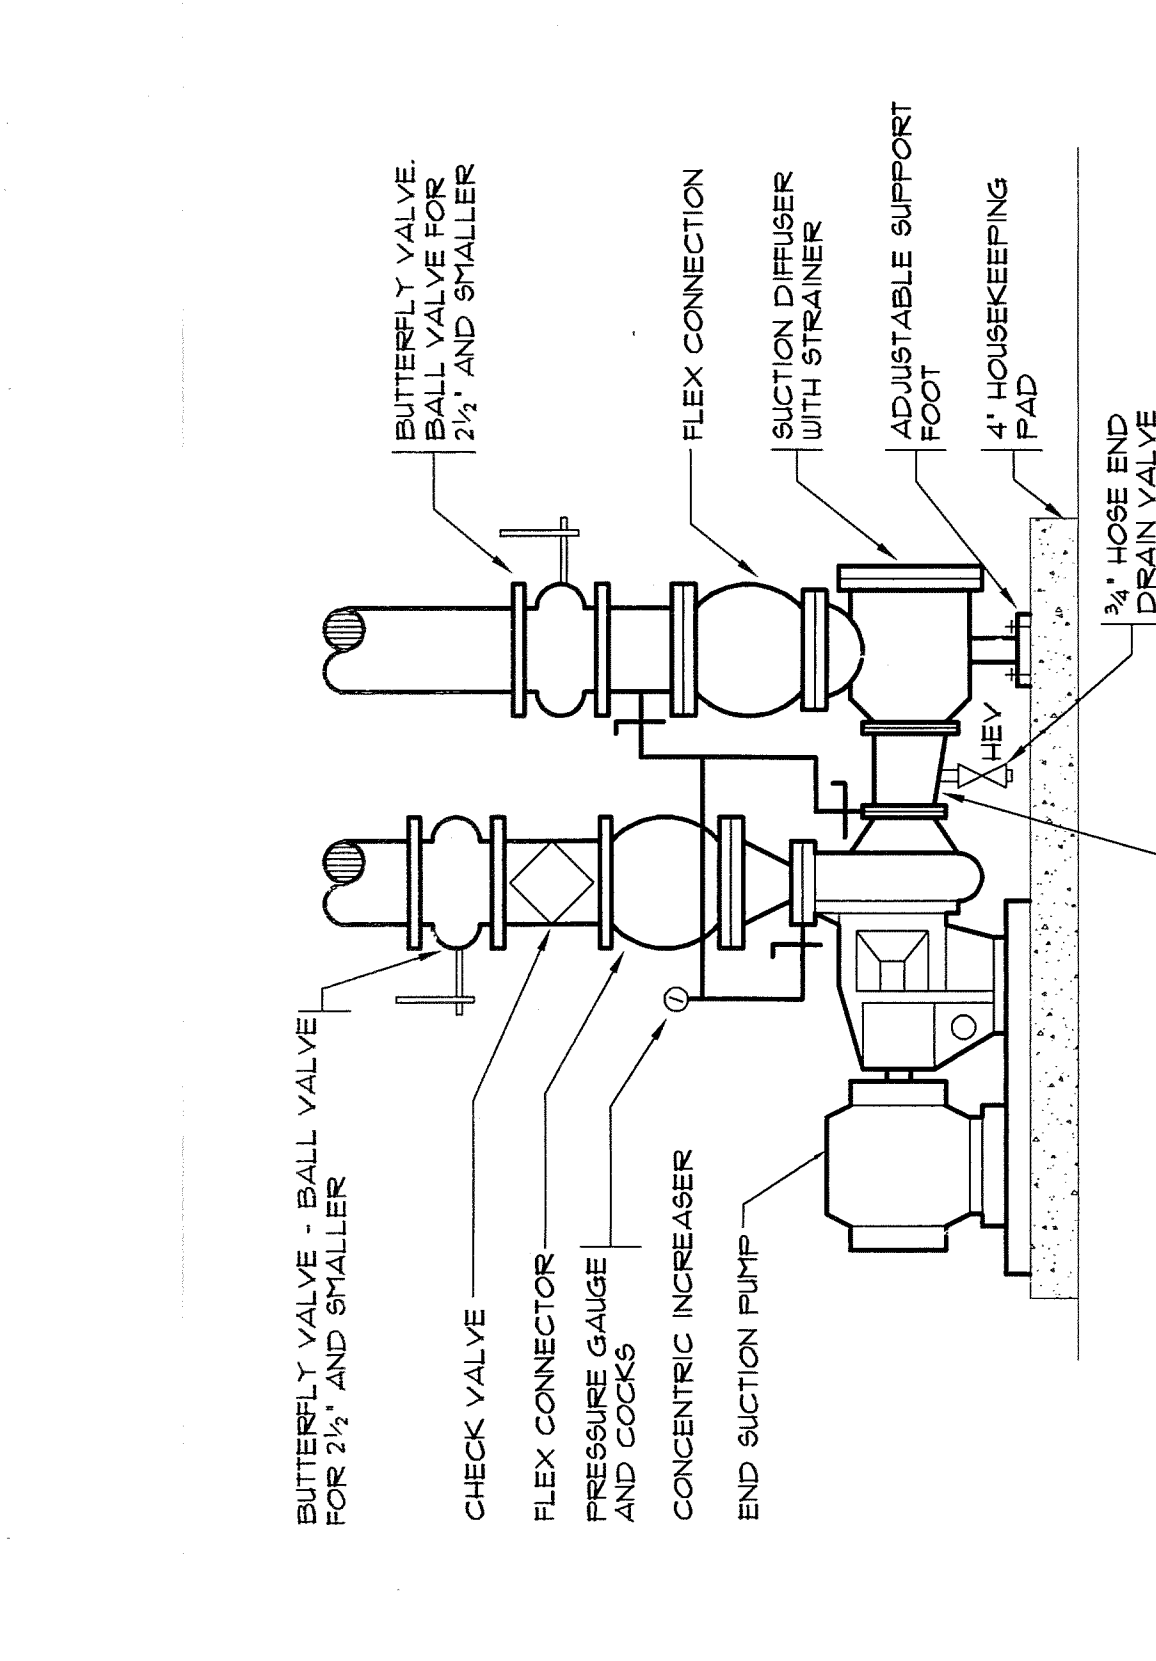

**END SUCTION PUMP**  
SCALE: NONE  
H 10/3

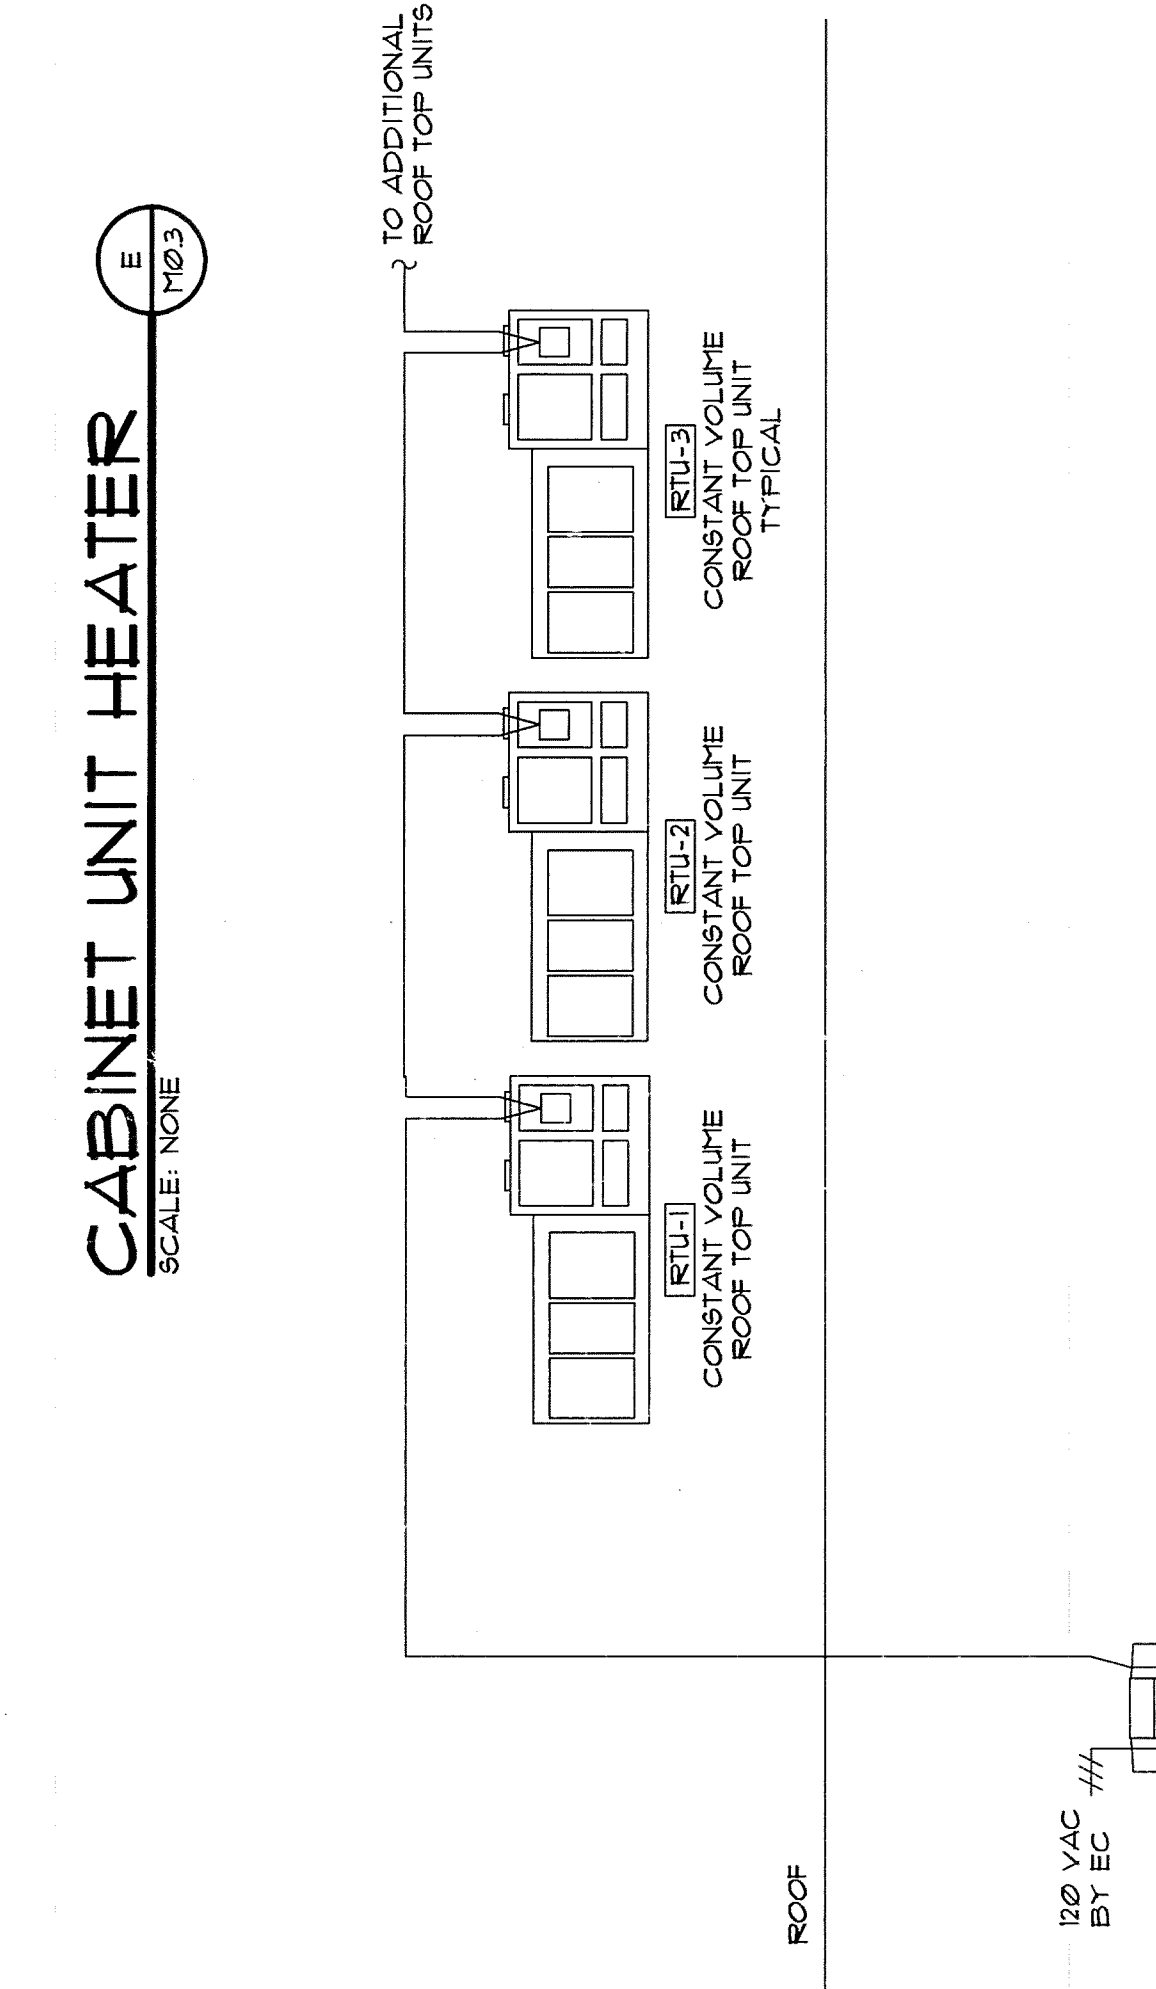


**CABINET UNIT HEATER**  
SCALE: NONE  
I 10/3

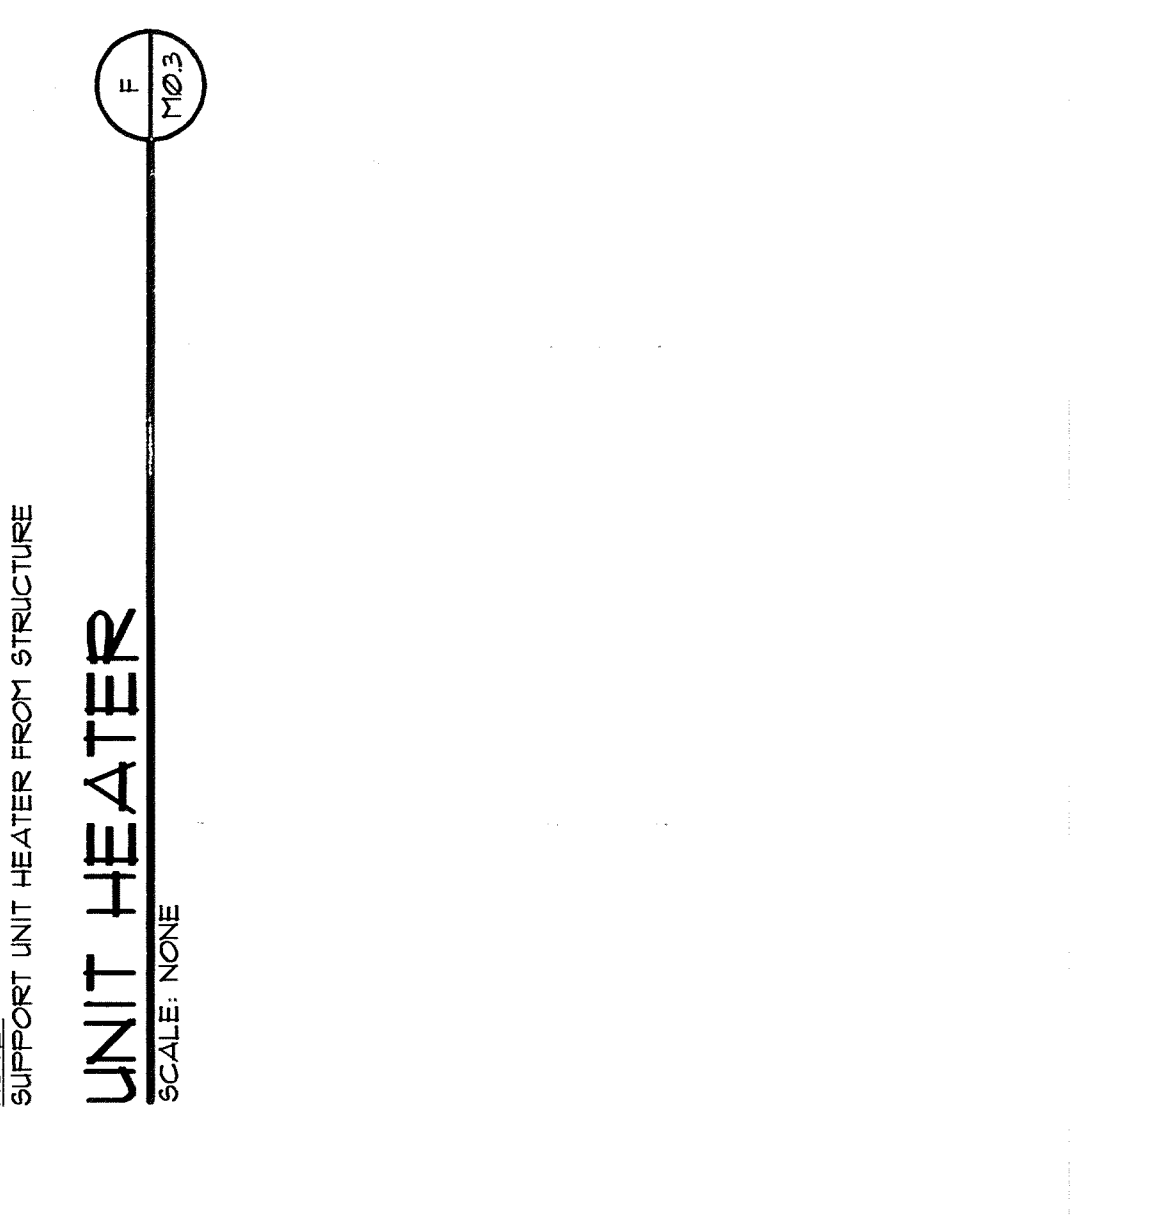

**CONTROLS DIAGRAM**  
SCALE: NONE  
J 10/3



NOTE: INSTALL A TRANE TRACER SC PANEL FOR LOCAL AND REMOTE CONTROL OF THE UNIT HEATER. THE TRANE TRACER SHALL ALLOW FOR COMMUNICATION INTERFACE TO THE PACKAGED ROOF TOP UNITS. THE SYSTEM SHALL BE CAPABLE FOR FUTURE CONNECTION TO THE BUILDING BMS VIA A BACNET INTERFACE AT A MINIMUM. THE TRANE TRACER SHALL ALLOW FOR WEB-BASED SCHEDULE AND SETPOINT ADJUSTMENT AS WELL AS SHALL FULL UNIT DIAGNOSTICS AND REMOTE ALARMS.

- WORK NOTES (THIS SHEET ONLY)**
- REPLACE EXISTING HEATING WATER PUMP P-62 AND ALL VALVES.
  - CONNECT TO EXISTING HWSR PIPING FROM MECHANICAL ROOM. INSTALL UP AGAINST STRUCTURAL.
  - RECONNECT TO EXISTING 2" HWSR PIPING SERVING SOUTH CORRIDOR OF BUILDING.
  - COORDINATE TO INSTALL NEW HWSR PIPING ON GATE VALVES AS THE DOMESTIC WATER (SEE PIPING SHEETS).
  - REPLACE EXISTING PUMP FEEDERS WITH NEW 1/2" GALV. CAPACIT. FEEDERS AND REPLACE ISOLATION VALVES ON PUMP SUPPLY/RETURN.
  - RELOCATE EXISTING UNIT HEATER AWAY FROM WALL. EXTEND HWSR PIPING TO NEW LOCATION.
  - RELOCATE SECTION OF EXISTING BASEBOARD AND COVER TO TICKET BOOTH. INSTALL NEW BRACHMAN OR DANFOSS CONTROL VALVE.
  - UNIT RETURN FLEATH FORRED USING SPACE BETWEEN TEE STEPS. LINED TO PROVIDE NOISE ABATEMENT OF RETURN AIR. RETURN AIR FILTERS TO BE INSTALLED IN RETURN FLEATH. DETECTORS FURNISHED AND WIRED BY ELECTRICAL.
  - FOR RTU-03 THRU RTU-04, SPIRAL DUCT IS INDICATED FOR SUPPLY DISTRIBUTION. ALTERNATE USING FABRIC DUCT SYSTEM WITH 18" DIA. DUCT. FABRIC DUCT SYSTEM MUST BE KEPT TIGHT TO BOTTOM OF STRUCTURE. DUCT DESIGN SHALL BE PROVIDED BY VENDORS AND CONTRACTORS. COLOR SELECTION BY ARCHITECT AND OWNER.
  - PROVIDE RULL CO DETECTION COVERAGE FOR EXISTING UNIT UNDER DETECTOR COVERAGE SHALL BE 50' RADIUS.
  - REMOVE EXISTING TRANSITION TO EXISTING FAN TO MAKE ROOM FOR NEW DUCTWORK.
  - BE-44 IS AN EXISTING FAN REMOVE NOTORIZED DAMPER. INSTALL NEW GRAVITY BACKDRIFT DAMPER. REUSE FOR BATHROOM. VERIFY PROPER FAN OPERATION AND ADJUST FOR 2000 CFM.
  - BE-97 FAN IS RELOCATED. SEE NOTE M2.2. PROVIDE CEILING FAN FOR PROPER OPERATION. ADJUST FAN FOR 300 CFM.
  - CONNECT TO EXISTING GAS SERVICE TO PROVIDE NEW SERVICE UP TO ROCKS FOR NEW NGC50TOP UNITS.
  - OLD KITCHEN SERVICE. CAPPED AND NOT USED.
  - OLD WATER HEATER SERVICE. CAPPED AND NOT USED.
  - UNDER GUT DOORS 1:
  - HVAC MAIN CONTROL PANEL AND CARBON MONOXIDE CONTROL PANEL.
  - BE-18 IS AN EXISTING FAN. CHECK FAN FOR PROPER OPERATION AND ADJUST FOR 6000 CFM.
  - PROVIDE CEILING TRANSFER GRILLE WITH FULL 24"X22" SOUND ATTENUATION. PROVIDE GRILLE WITH FLANGE FOR HARD CEILING INSTALLATION.

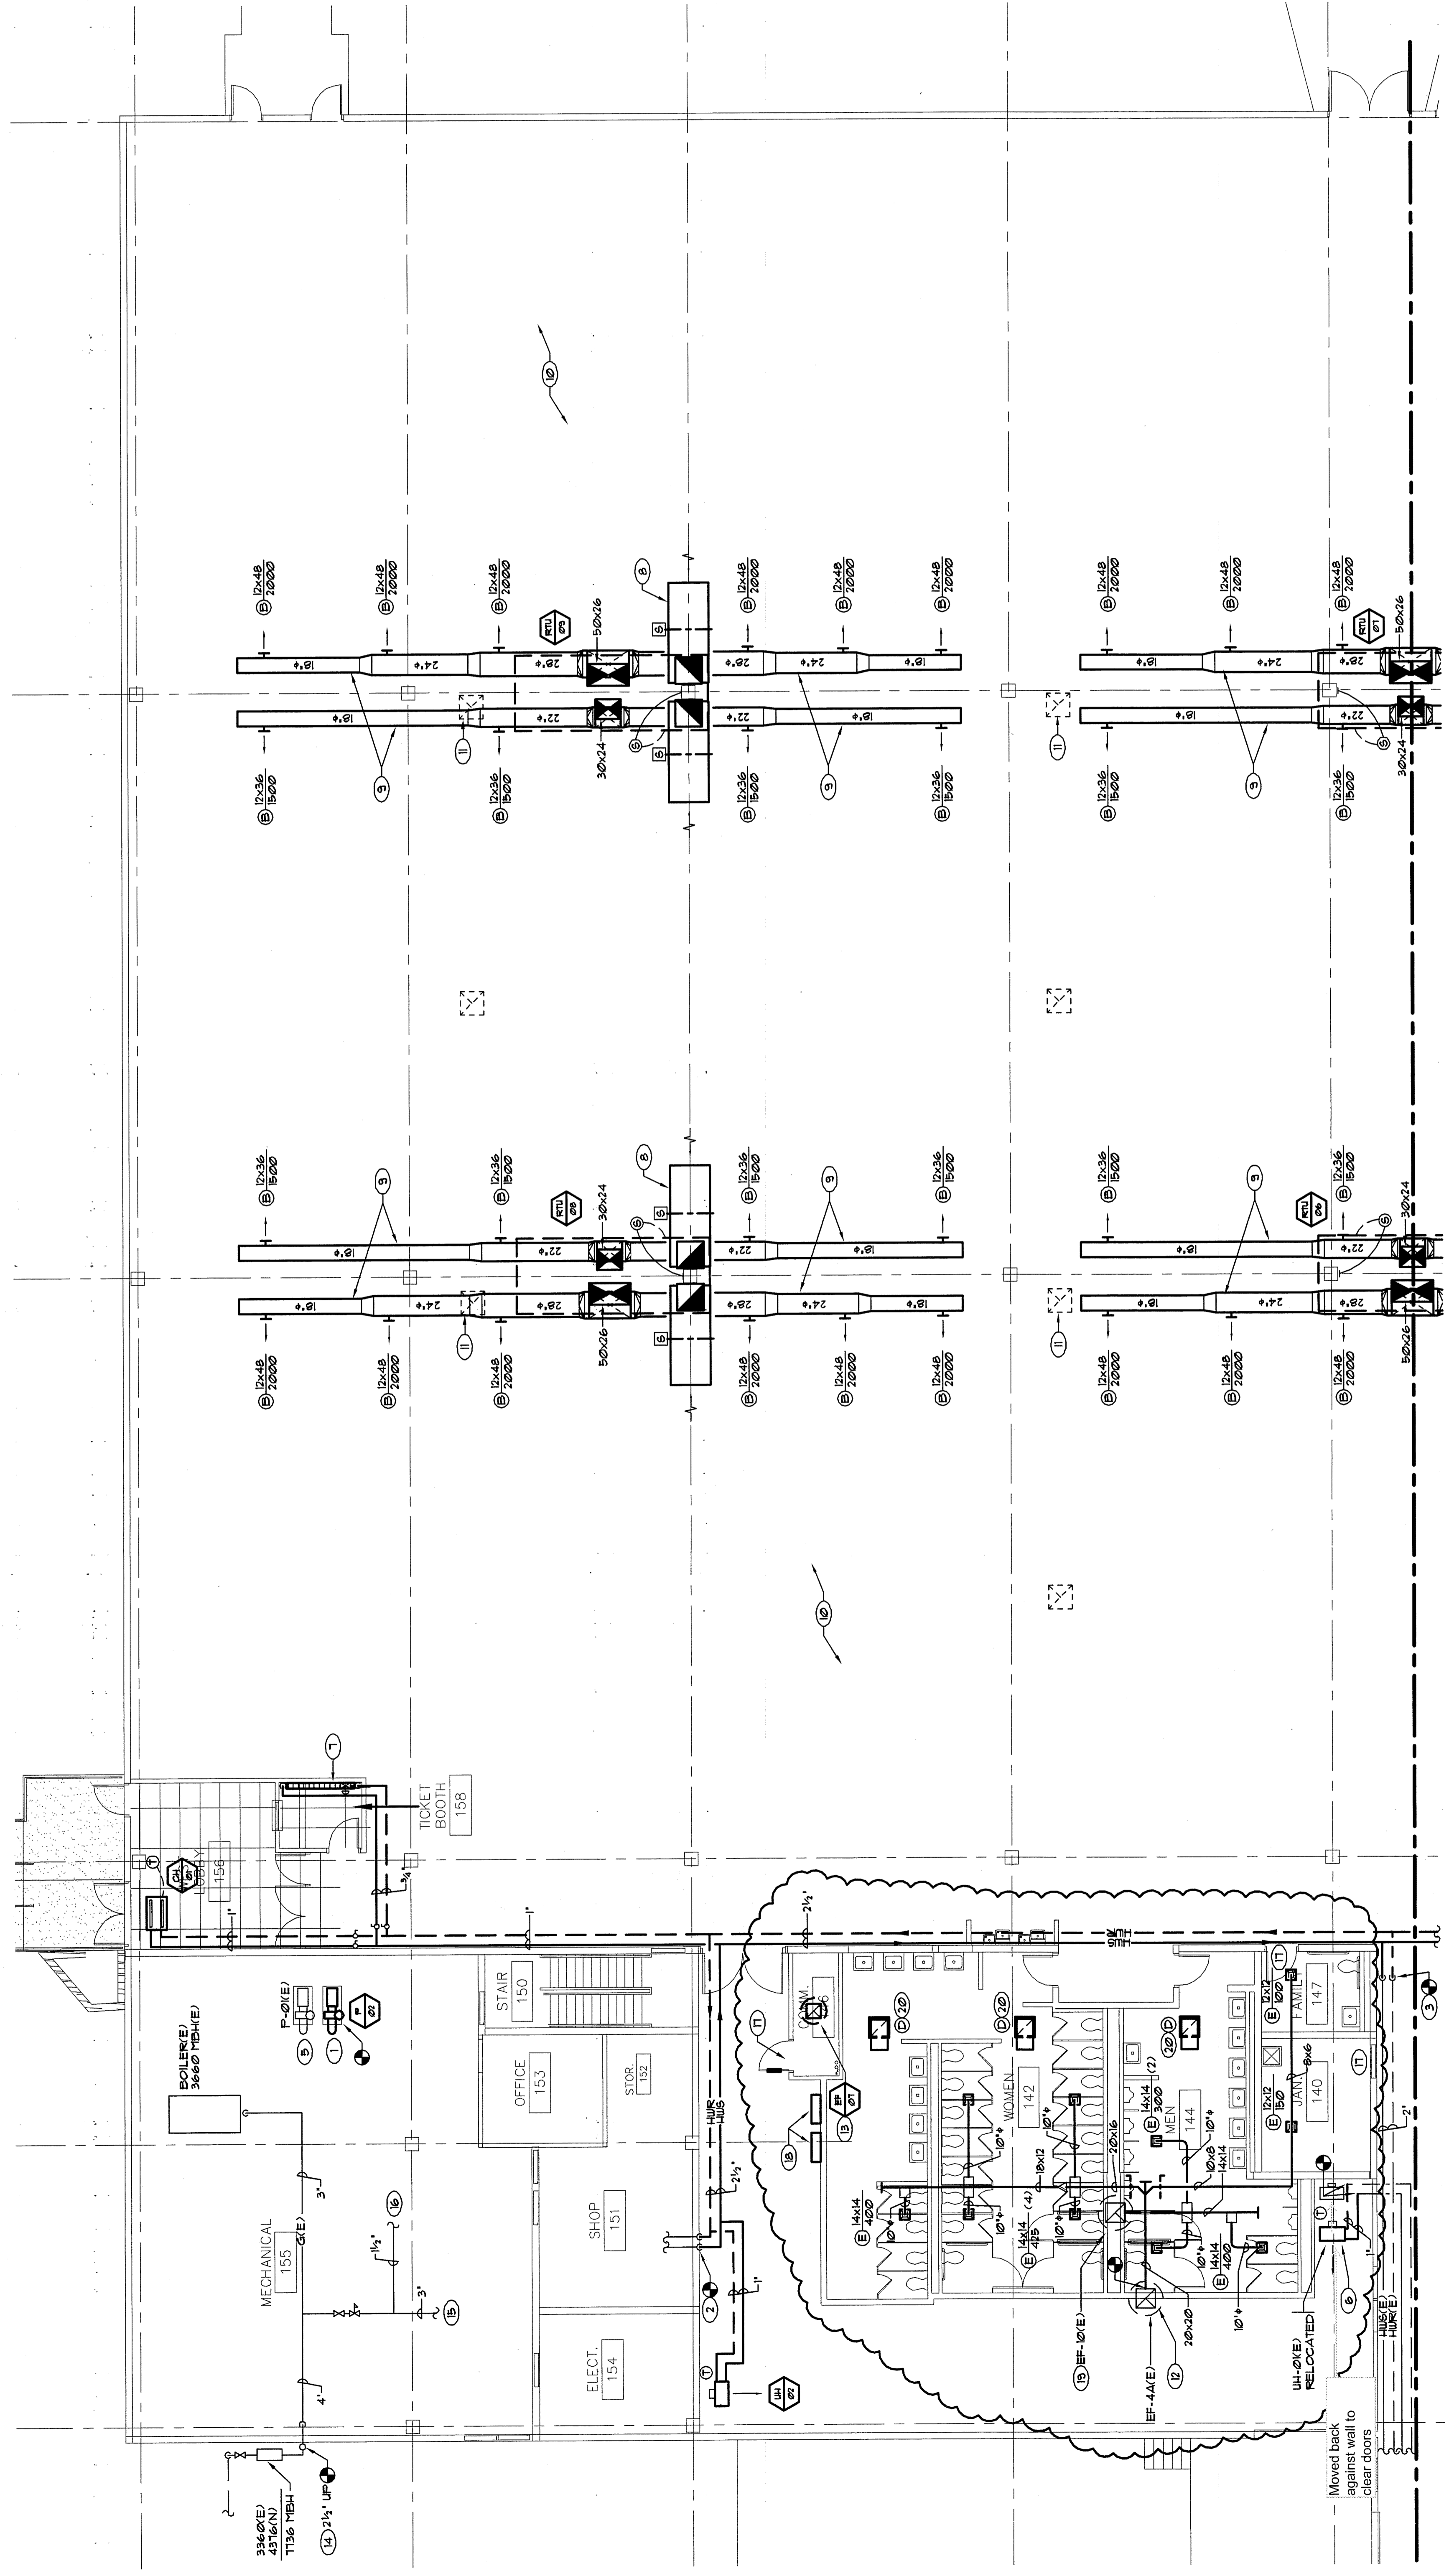


PARTIAL FLOOR PLAN - HVAC  
 SCALE: 1/8" = 1'-0"


AS BUILT DRAWINGS BY:  
 HARMON-BONDED PLUMBING &  
 HEATING, INC.

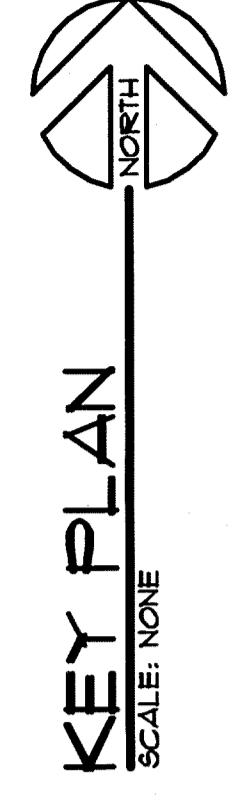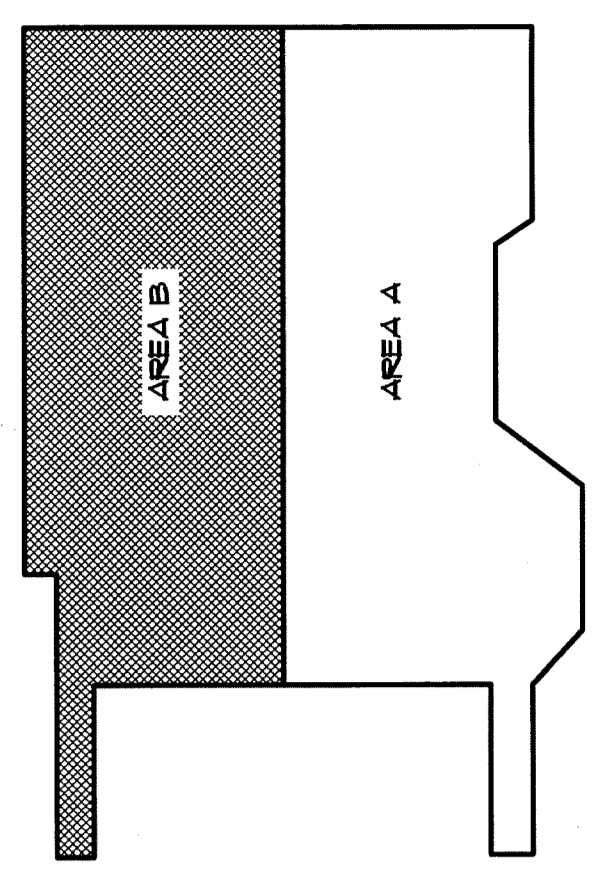

- WORK NOTES (THIS SHEET ONLY)**
- 1 RECONNECT NEW HWRS TO EXISTING PIPING IN CORRIDOR. SEE SHEET M2.1.
  - 2 RECONNECT NEW HWRS TO BASE BOARD SERVING EXISTING CORRIDOR. IF SUPPLY/RETURN.
  - 3 COORDINATE PIPING TO INSTALL AS HIGH AS POSSIBLE.
  - 4 GAS PIPING FROM ROOF.
  - 5 UNIT HEATER VENT UP THRU ROOF CONCENTRIC VENT/COMBUSTION AIR.
  - 6 SUPPLY DUCT TO DROP APPROXIMATELY 6" AND BE HELD TIGHT TO LOWER STRUCTURE.
  - 7 UNIT RETURN PLEATH FORMED USING SPACE BETWEEN TIE STEPS. LINED TO PROVIDE NOISE ABATEMENT OF RETURN AIR. RETURN PLEATHS TO BE DESIGNED AND INSTALLED BY ELECTRICAL.
  - 8 FOR RTU-023 THRU RTU-025 SPIRAL DUCT IS INDICATED FOR SUPPLY DISTRIBUTION. ALTERNATE USING FABRIC DUCT DISTRIBUTION MAY BE UTILIZED. FABRIC DUCT HANGER AND SUPPORTS TO BE PROVIDED BY VENDOR. FABRIC DUCT DESIGN SHALL BE PROVIDED BY VENDOR'S FACTORY ENGINEER. COLOR SELECTION BY ARCHITECT AND OWNER.
  - 9 PROVIDE FULL CO DETECTION COVERAGE FOR EXPO. PROVIDE FULL SINGLE DETECTOR COVERAGE SHALL BE 50' RADIUS.
  - 10 REMOVE BE-01 (EXISTING) AND CAP CURB (IF APPLICABLE). FAN TO BE RELOCATED TO VENTILATE COR ROOT. SEE M2.1.
  - 11 REMOVE REMAINING TRANSITION TO EXISTING FAN INLET TO MAKE ROOM FOR NEW DUCTWORK.
  - 12 REMOVE FAN AND CURB IF NECESSARY TO INSTALL RTU FIELD VERIFY.
  - 13 CONNECT EXISTING AND NEW BATHROOM EXHAUST DUCT TO EXISTING EF-026. ADJUST FAN FOR 10000 CFM.
  - 14 REMOVE ABANDONED SECTIONS OF BASEBOARD.
  - 15 FLUSH AND REINSTALL EXISTING BASEBOARD. INSTALL NEW BRIGHMAN OR DANFOS CONTROL VALVE.
  - 16 FLUSH EXISTING BASEBOARD AND INSTALL NEW BRIGHMAN OR DANFOS CONTROL VALVE.


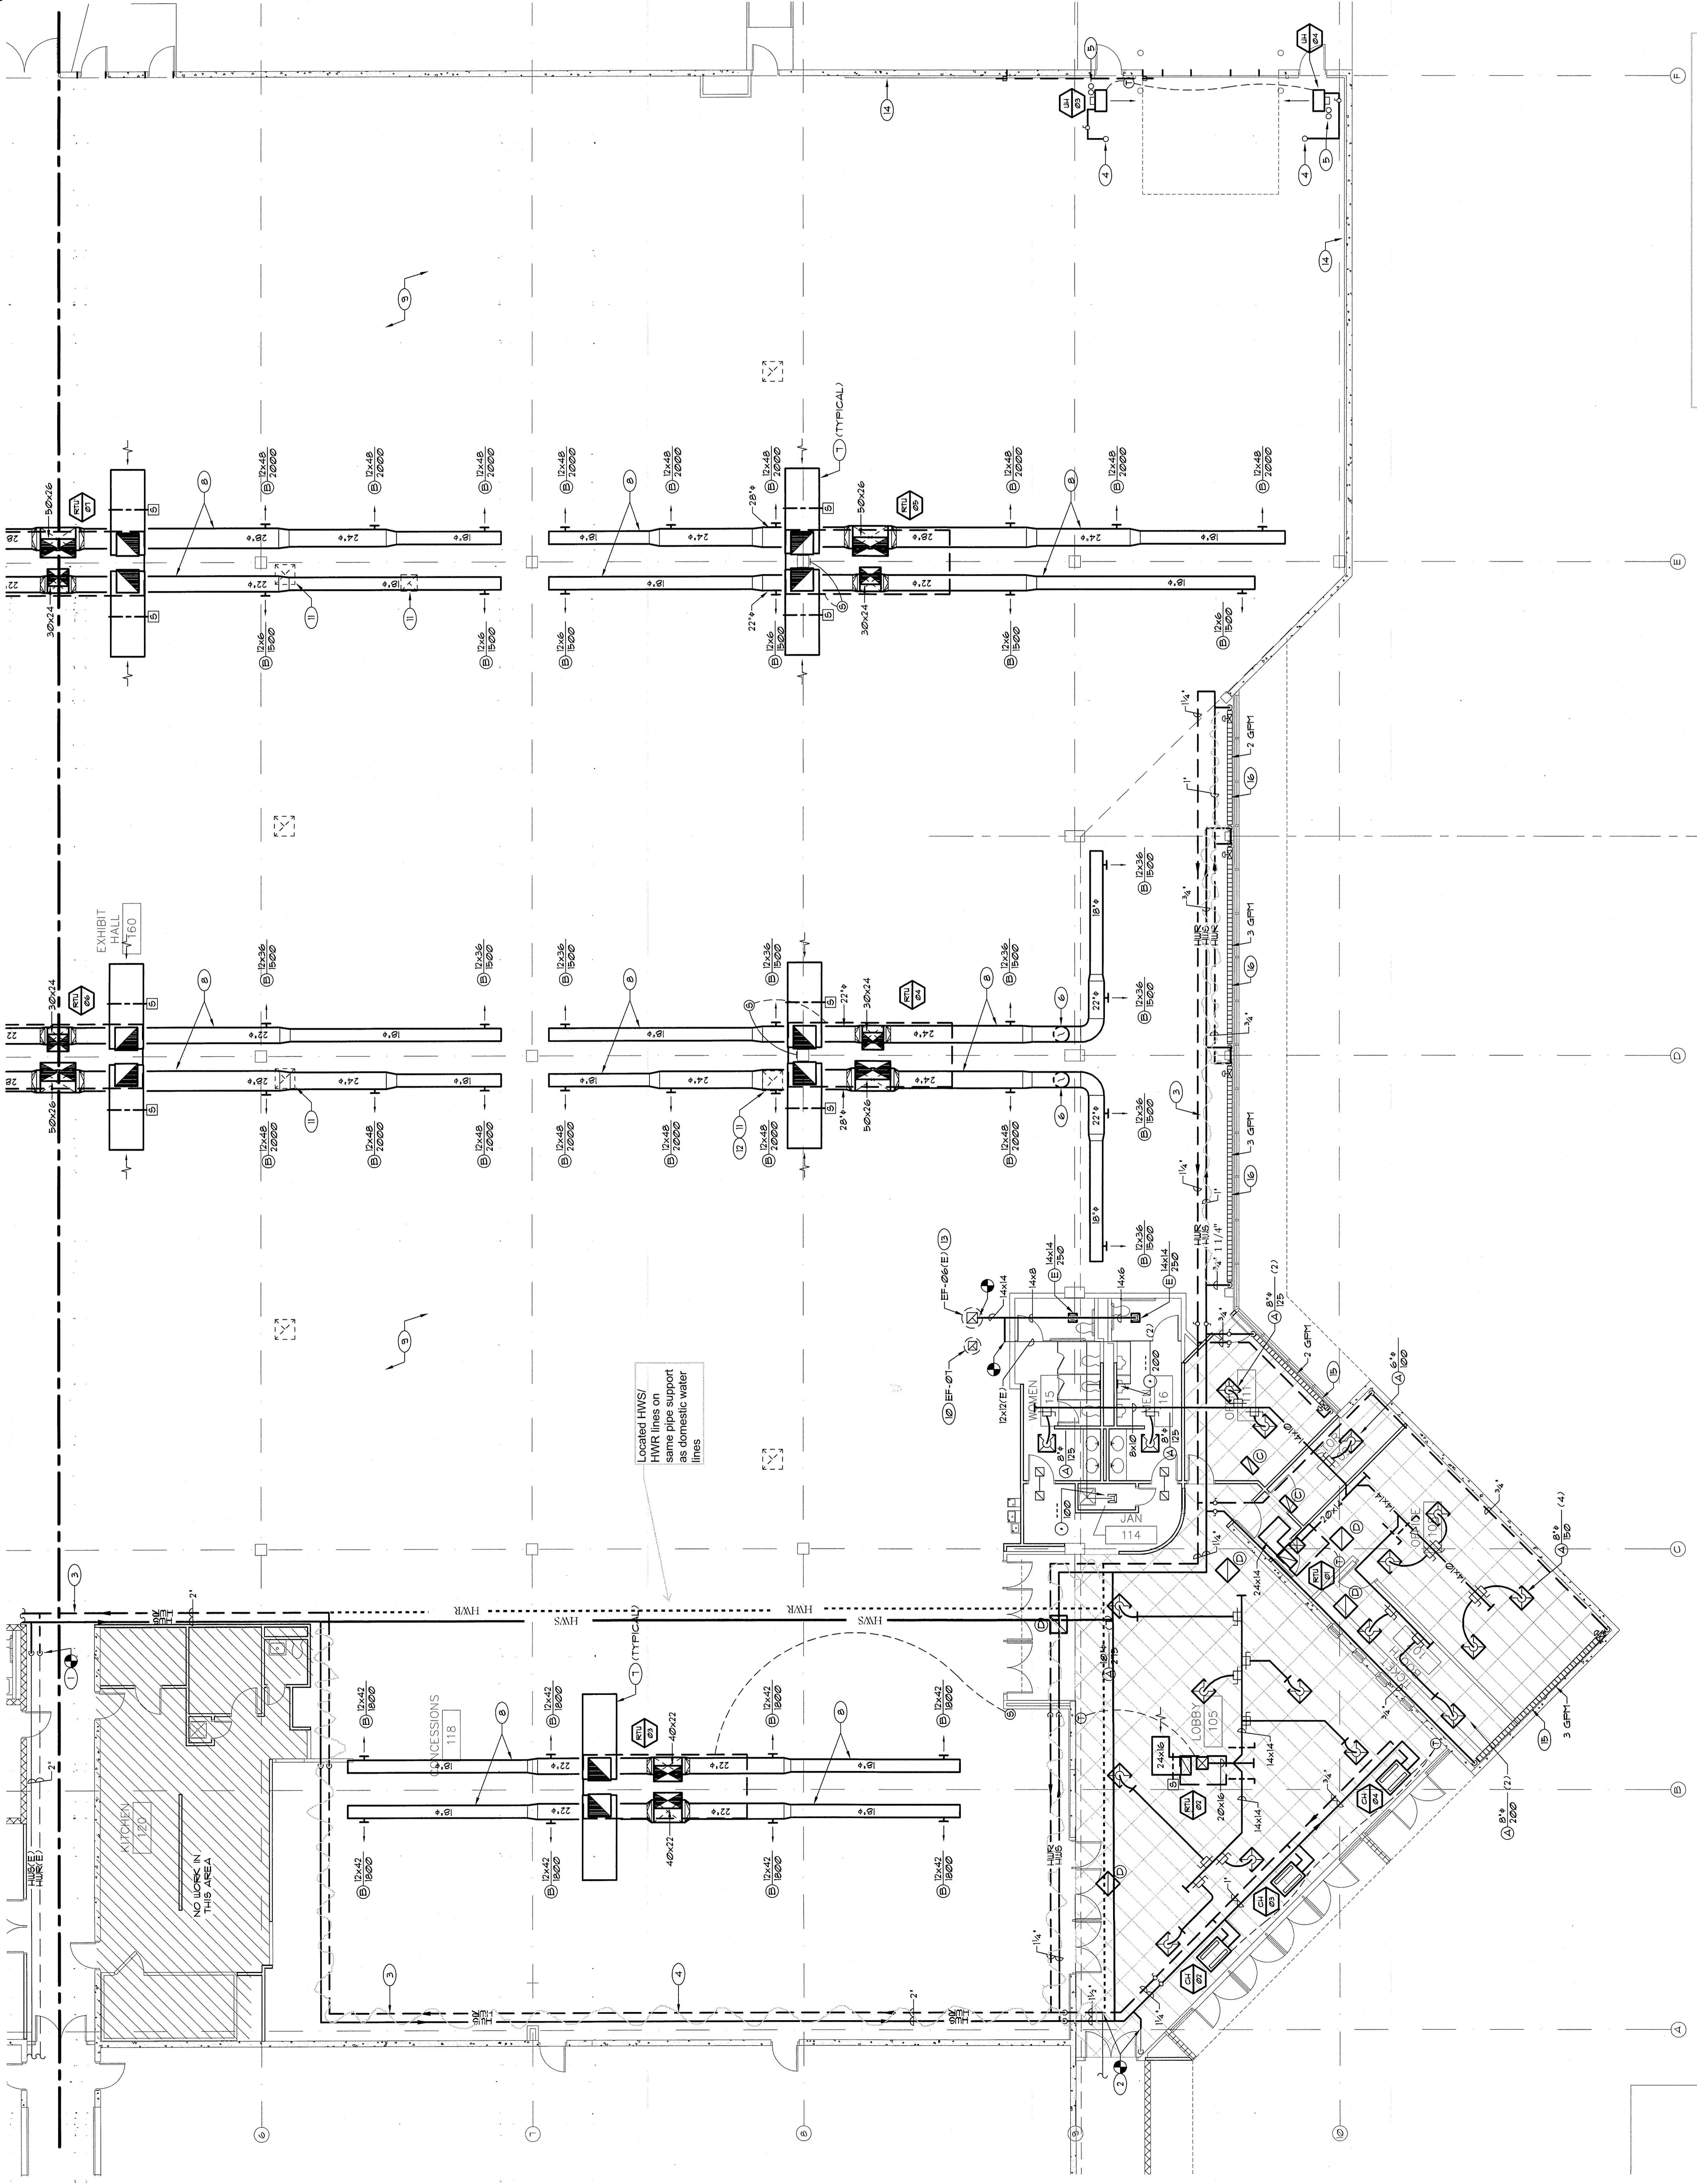


AS BUILT DRAWINGS BY:  
HARMON-BONDED PLUMBING &  
HEATING INC.

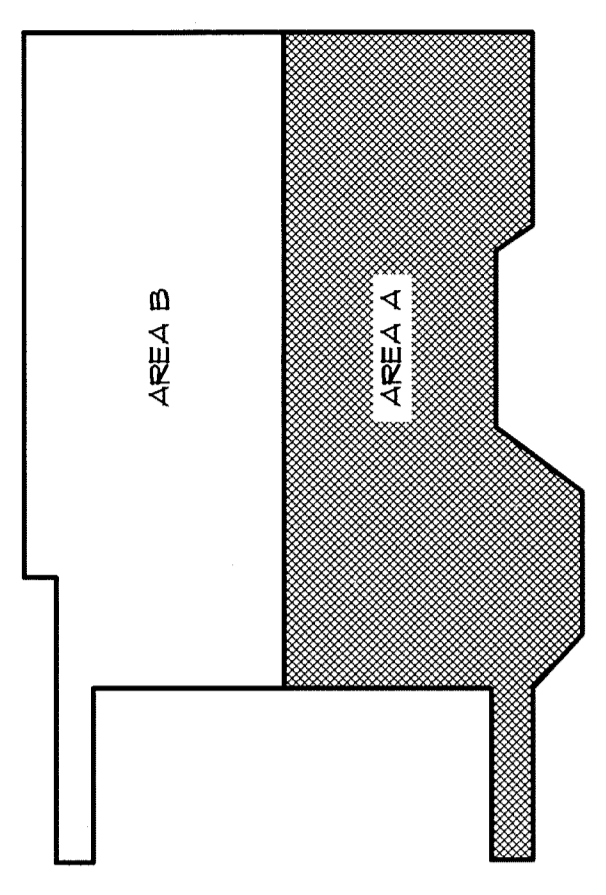

REVISIONS

- WORK NOTES (THIS SHEET ONLY)**
1. NEW 1/2" GAS SERVICE UP FROM EXISTING GAS METER
  2. 1" GAS DELIVERY PRESSURE.
  3. PRESSURE REGULATOR
  4. PROVIDE DIRT LEG, ISOLATION VALVE AND UNION AT EACH RTU GAS CONNECTION.
  5. PROVIDE GAS PIPE SUPPORT FOR ALL ROOF GAS PIPING AND AT UNIT ISOLATION VALVE.
  6. GAS DOWN TO UNIT HEATERS.
  7. REMOVE EXISTING EQUIPMENT AS NEEDED FOR PIPING/VENTS FOR UNIT HEATERS.
  8. NEW UNIT HEATER VENTS. TERMINATION TO BE MINIMUM 7' HIGHER THAN PARAPET.
  9. REMOVE OUTSIDE AIR INTAKE AS NEEDED TO INSTALL RTU AND GAS PIPING. CAP CURB WEATHER TIGHT.
  10. REMOVE EXISTING FAN/CURB AS NEEDED TO INSTALL RTU.

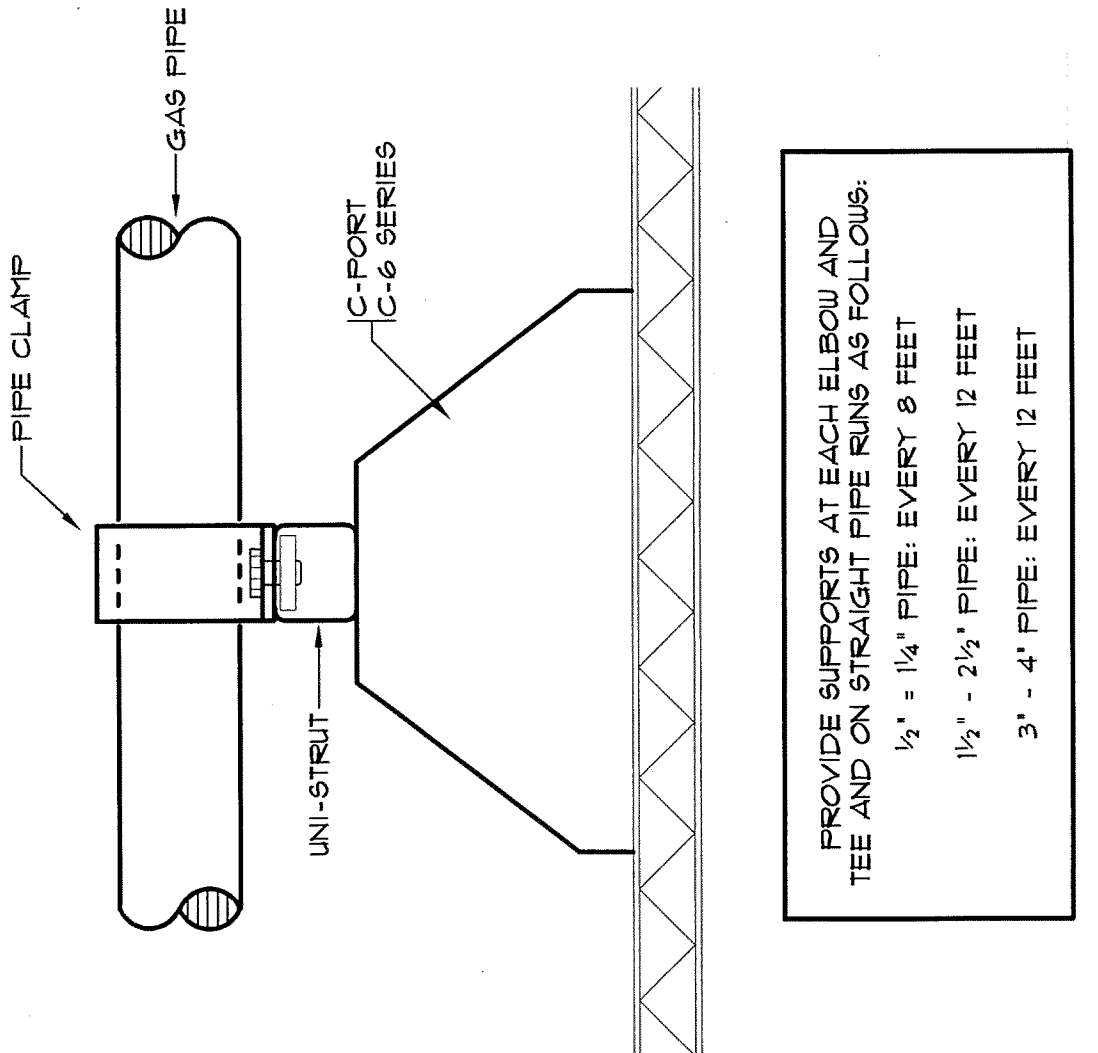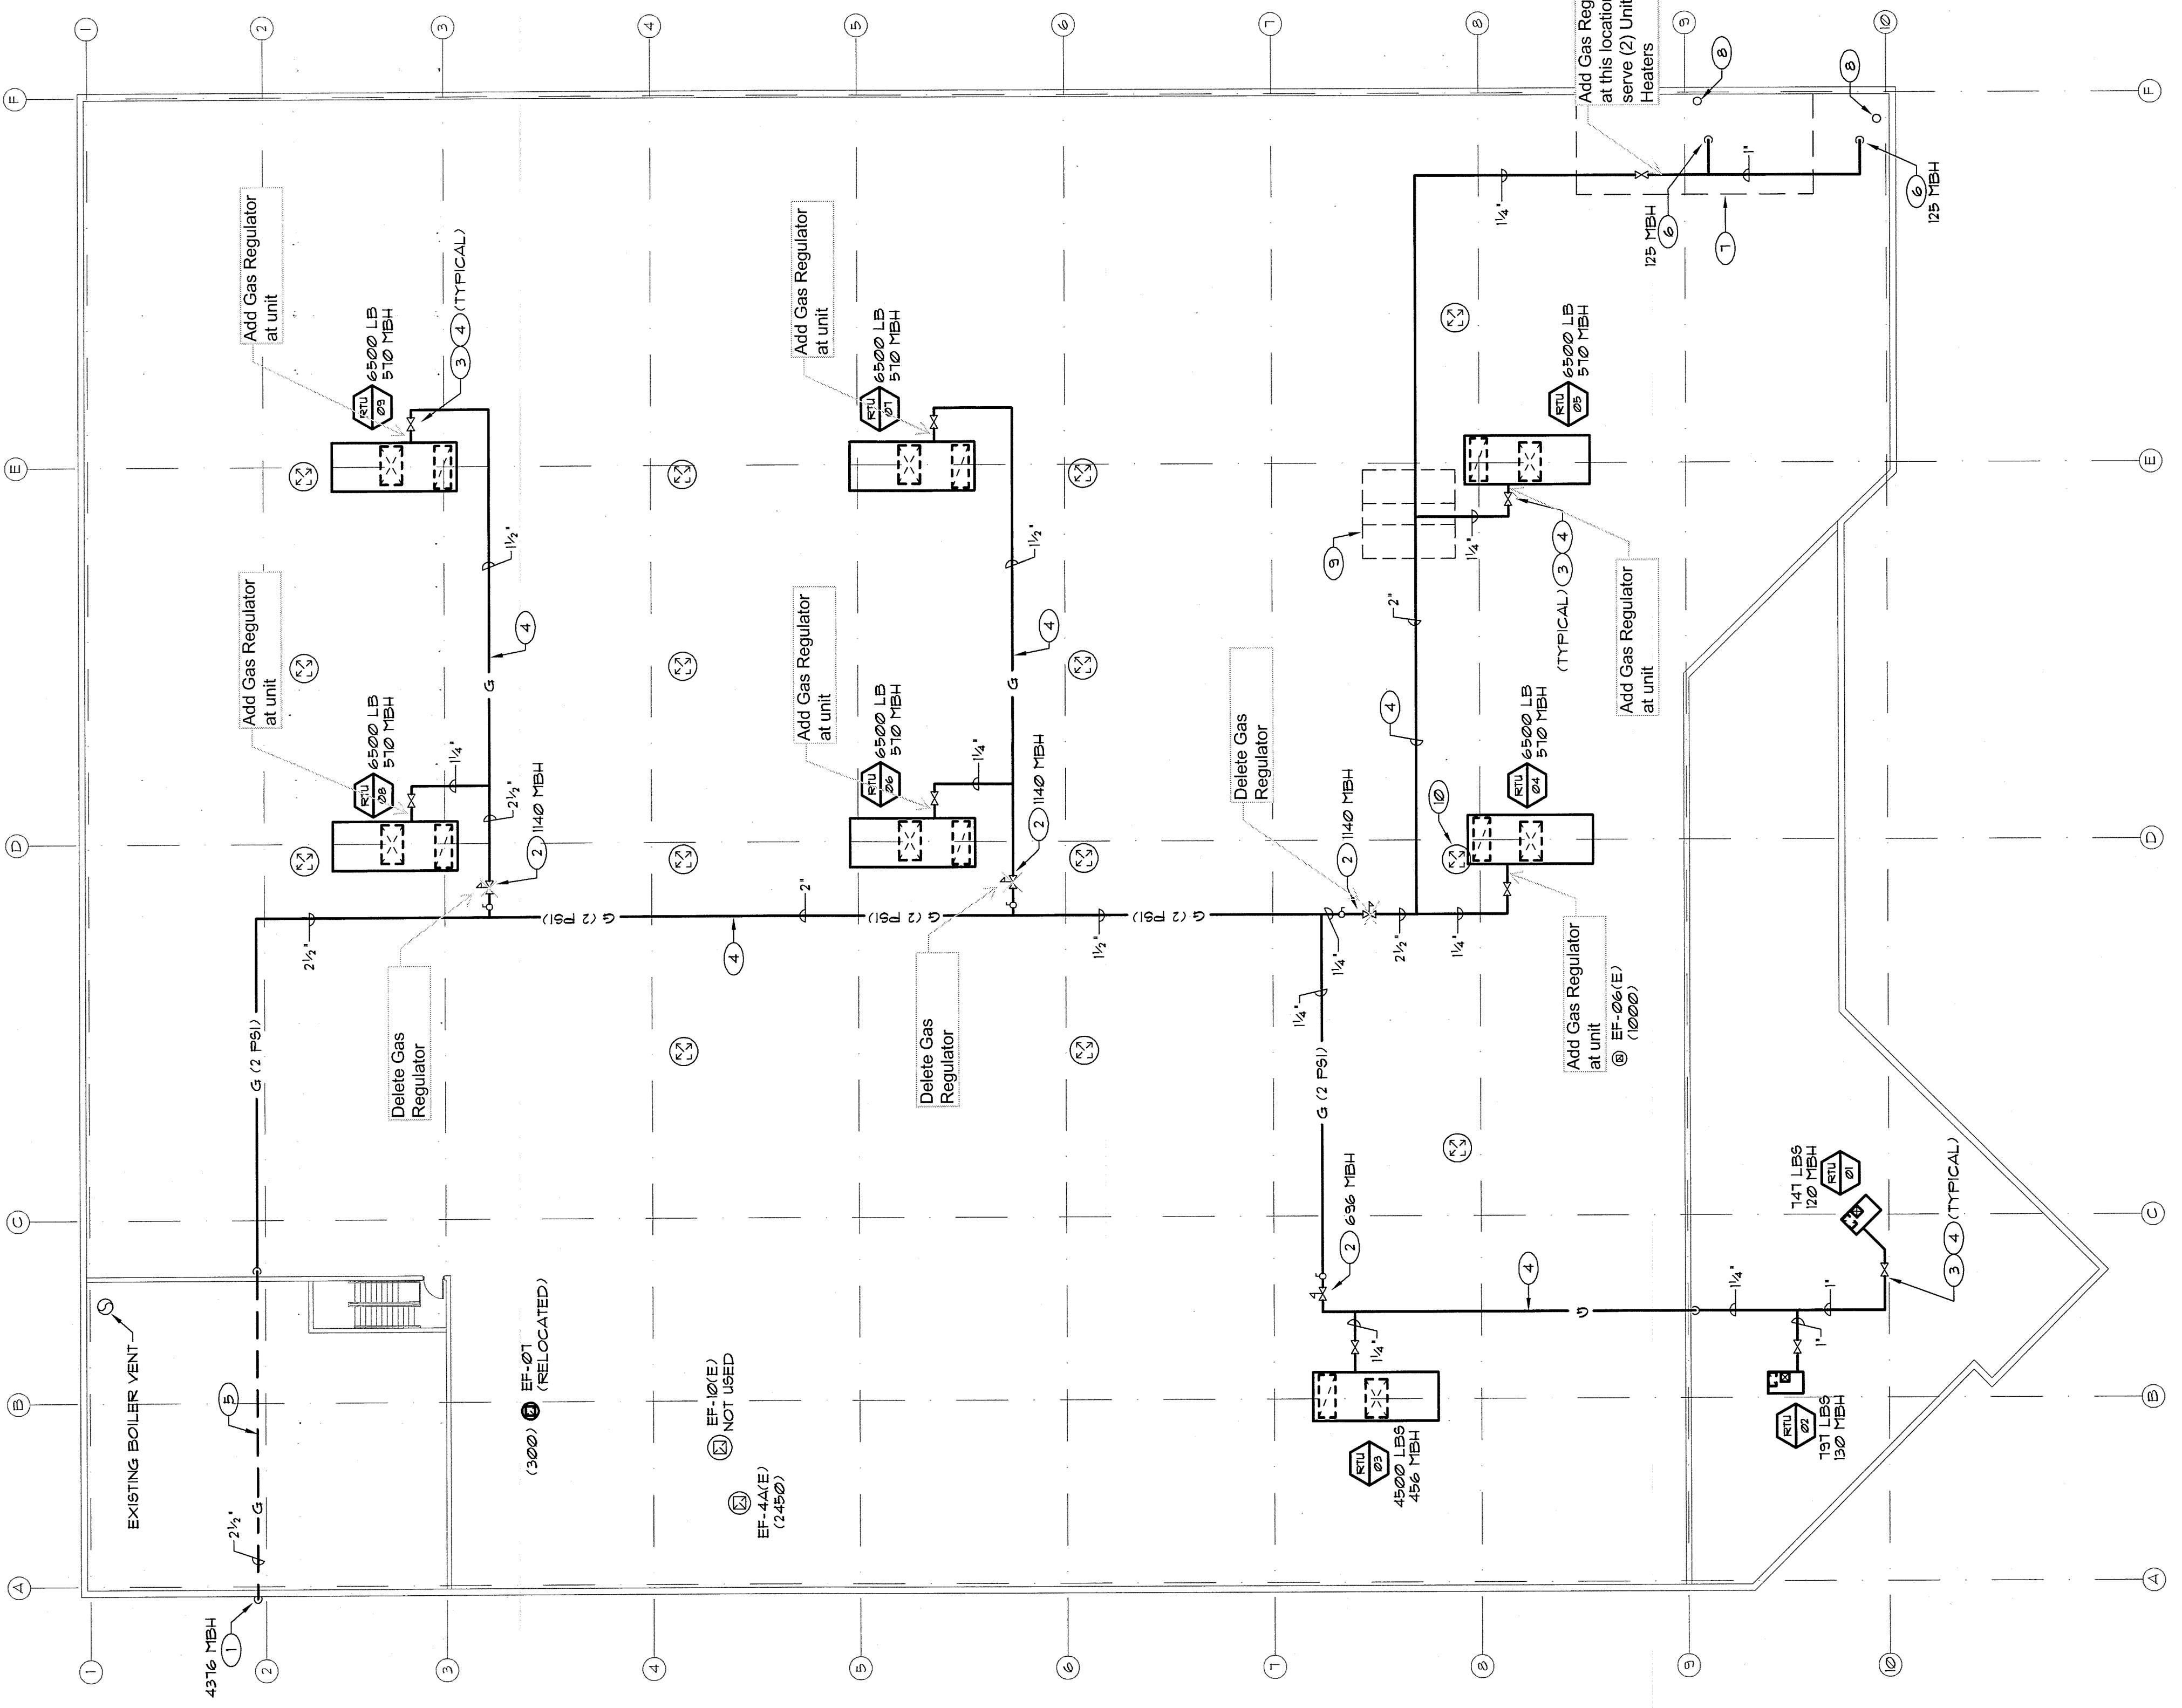

PROVIDE SUPPORTS AT EACH ELBOW AND TEE AND ON STRAIGHT PIPE RUNS AS FOLLOWS:  
 1/2" - 1/4" PIPE: EVERY 8 FEET  
 3/4" - 2 1/2" PIPE: EVERY 12 FEET  
 3" - 4" PIPE: EVERY 12 FEET

PIPE SUPPORT DIAGRAM  
SCALE: NONE

AS BUILT DRAWINGS BY:  
HARMON-BONDED PLUMBING &  
HEATING, INC.









- WORK NOTES (THIS SHEET ONLY)**
- 1) PROVIDE NEW CUI AND/OR IUI TO NEW FIXTURES.
  - 2) CONNECT NEW 2" WASTE FROM NEW DRINKING FOUNTAIN TO EXISTING STACK PRESERVING FOR DRINKING FOUNTAIN.
  - 3) CONNECT TO EXISTING 4" ABOVE GRADE GANG PLUMBING.
  - 4) CONNECT NEW FIXTURE VENTING TO EXISTING 3" VENT THRU ROOF.
  - 5) CONNECT ALL NEW FIXTURES TO NEW 4" VTR.
  - 6) INSTALL LAV TO MEET ADA REQUIREMENTS.
  - 7) NEW 4" ABOVE GRADE GANG PLUMBING DROPS TO BELOW GRADE.
  - 8) NOT USED.
  - 9) NOT USED.
  - 10) INSTALL NEW FLOOR DRAIN WITH TRAP GUARD SEAL.
  - 11) SUPPORT WATER HEATER ABOVE CEILING USING ANGLE IRON AND SPAN WALLS. AND PROVIDE DRAIN PAN UNDER WATER HEATER.

- DEMO NOTES (THIS SHEET ONLY)**
- 1) REMOVE UNDER DEMO SCOPE
  - 2) REMOVE ADDITIONAL FIXTURES.
  - 3) ROUGH-IN TO BE CHANGED FROM WATER CLOSET WALL HANG TO URINAL ROUGH-IN.
  - 4) EXISTING SERVICE SINK TO REMAIN.
  - 5) 4" DROP THROUGH FLOOR TO BE RELOCATED.


AS BUILT DRAWINGS BY:  
**HARMON-BONDED PLUMBING & HEATING, INC.**

NOTE: FIXTURES WITHOUT TAGS/ID ARE EXISTING, TO REMAIN UNLESS OTHERWISE NOTED.

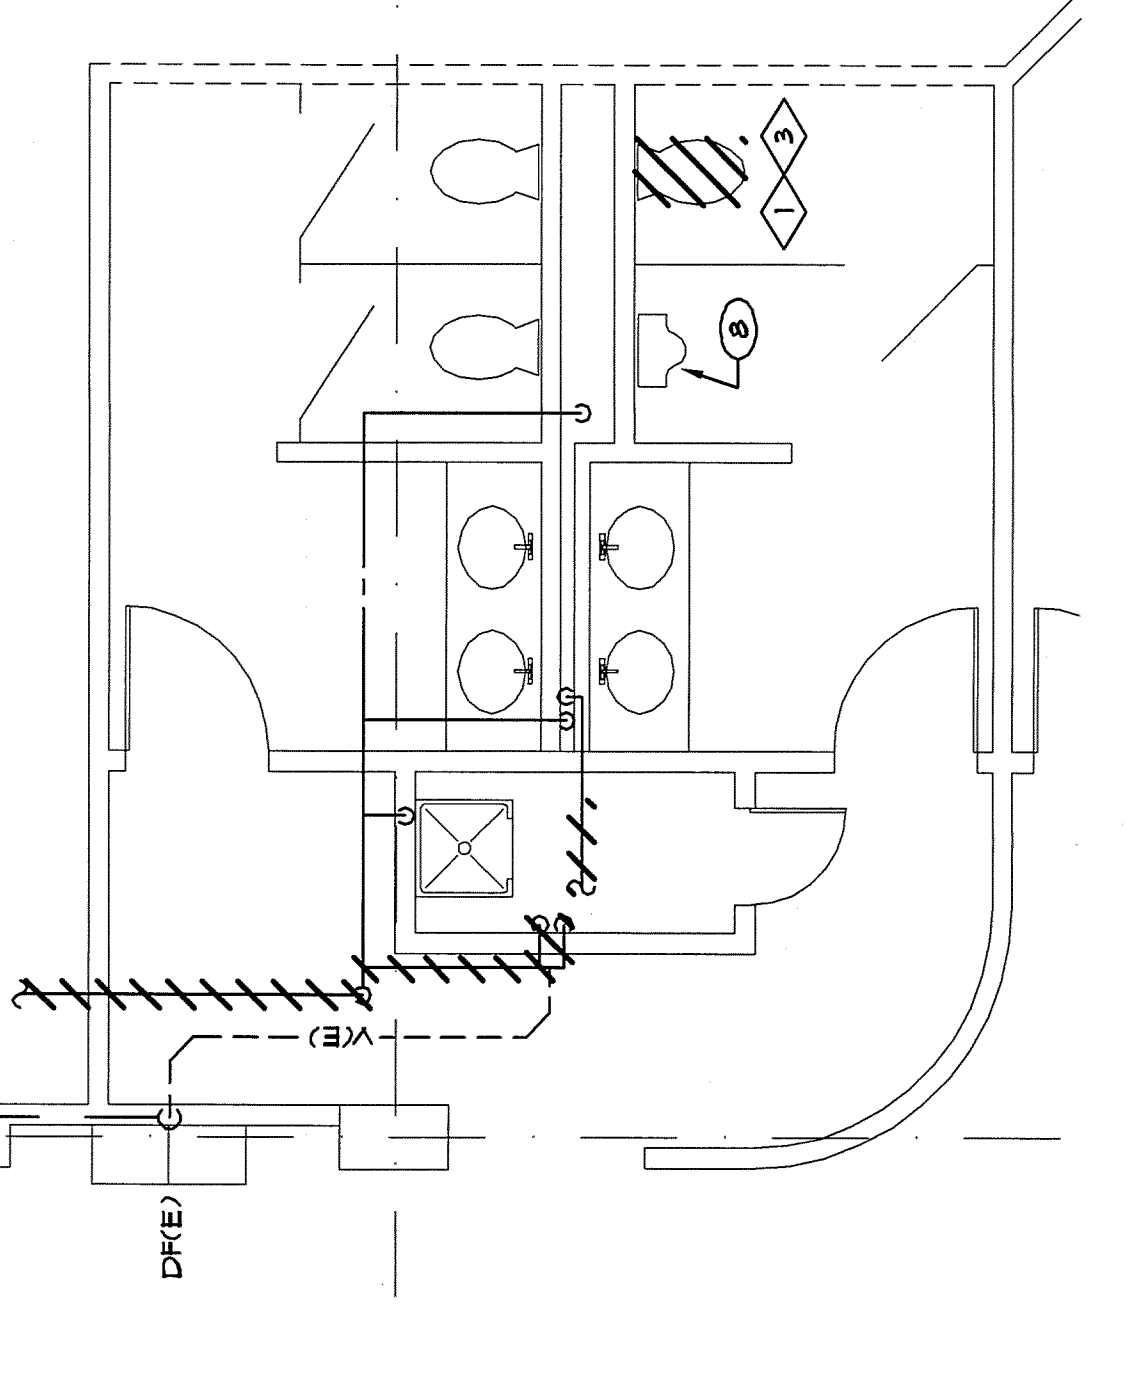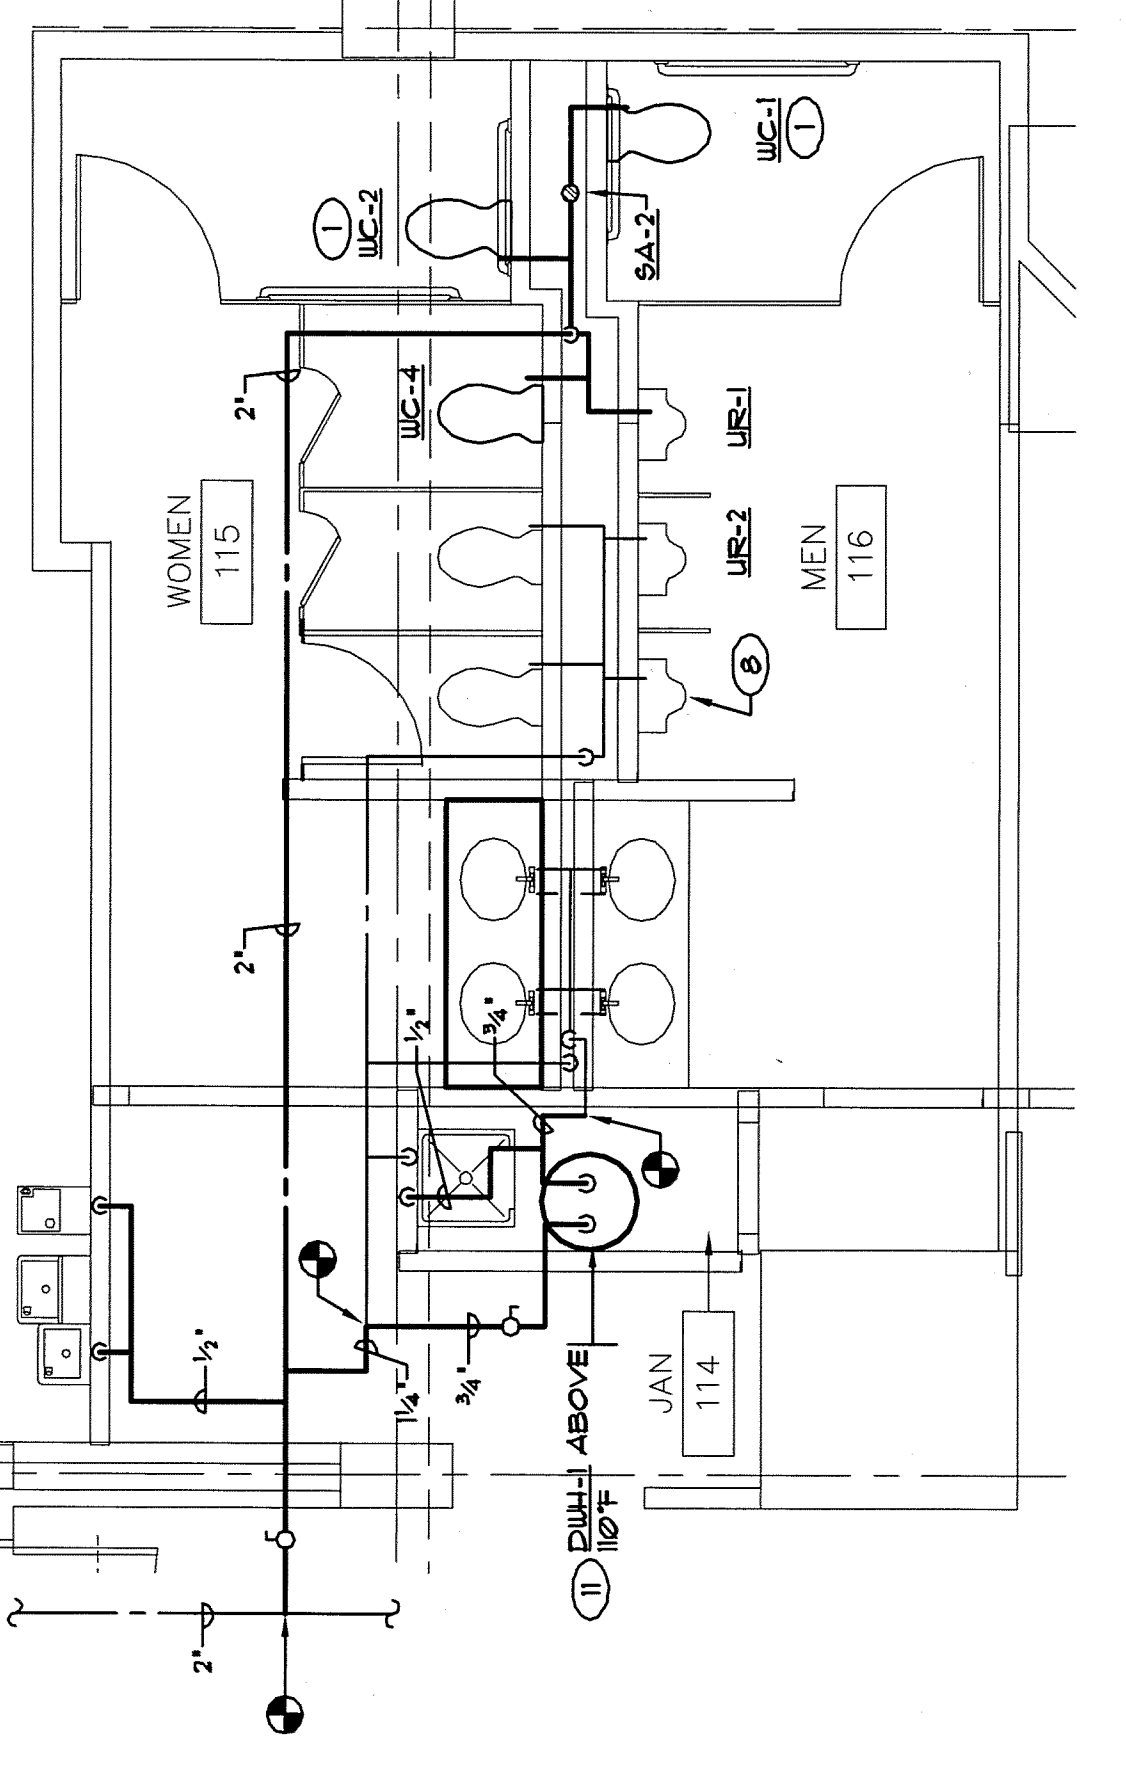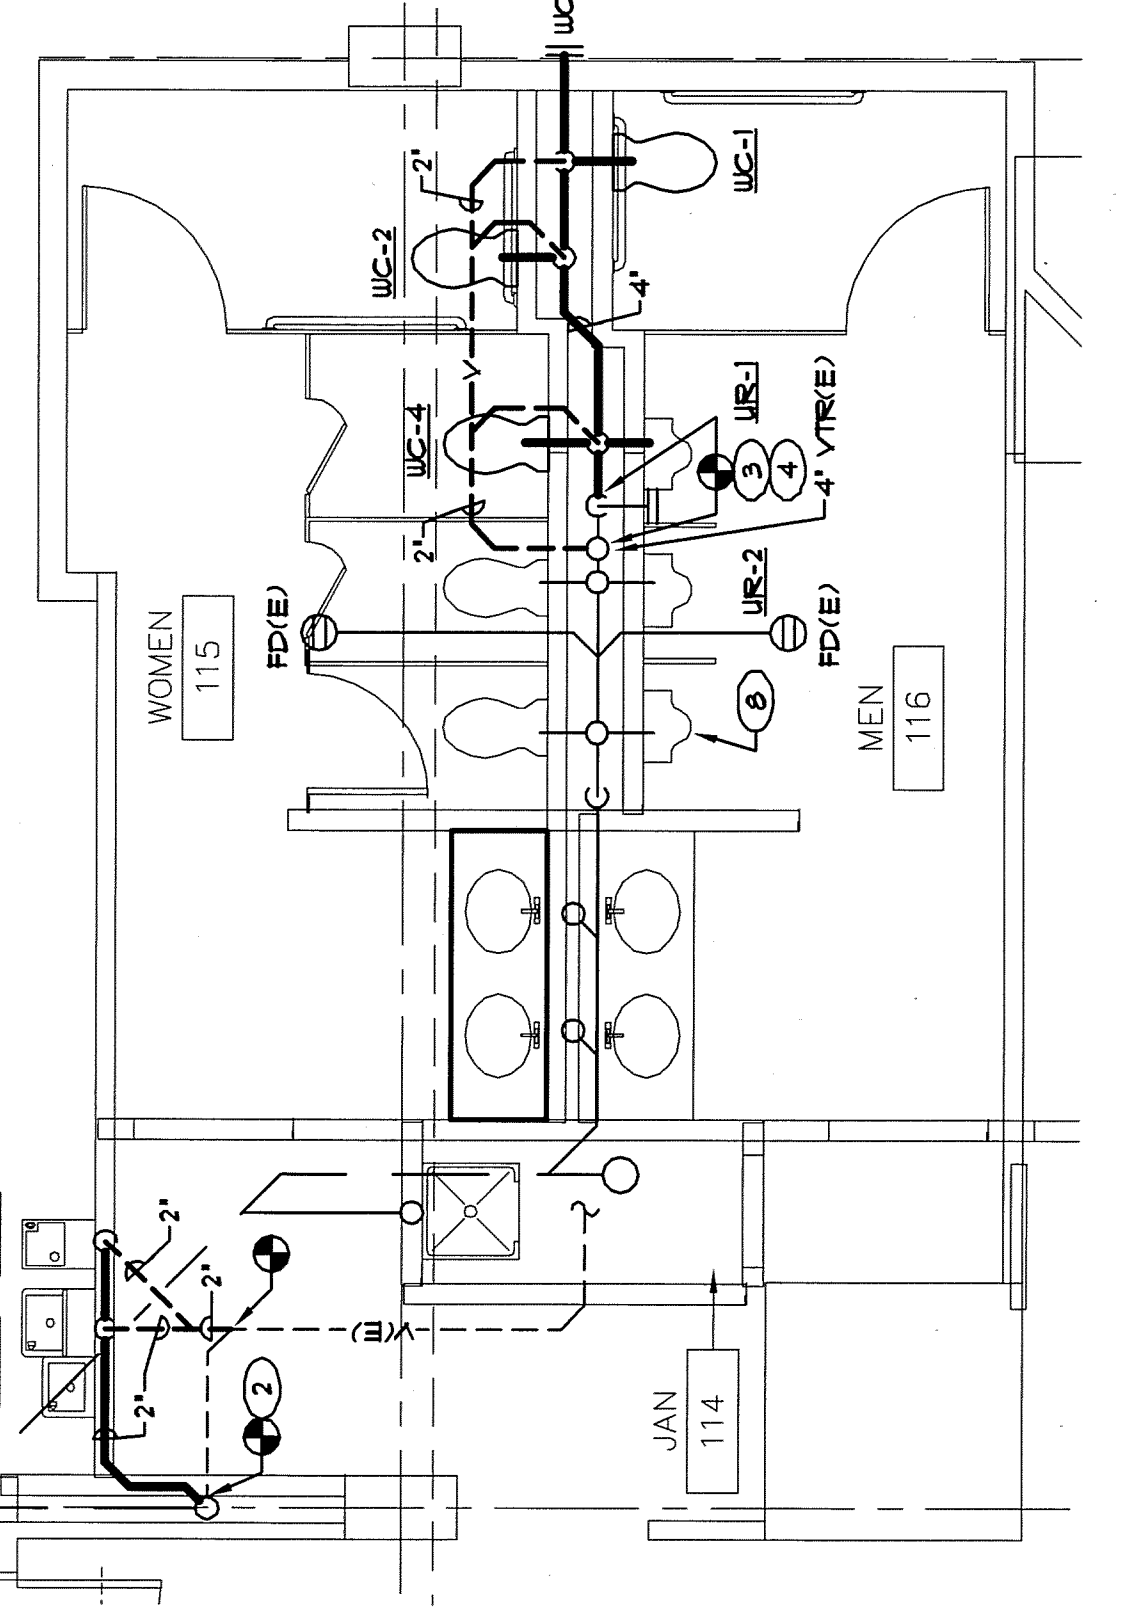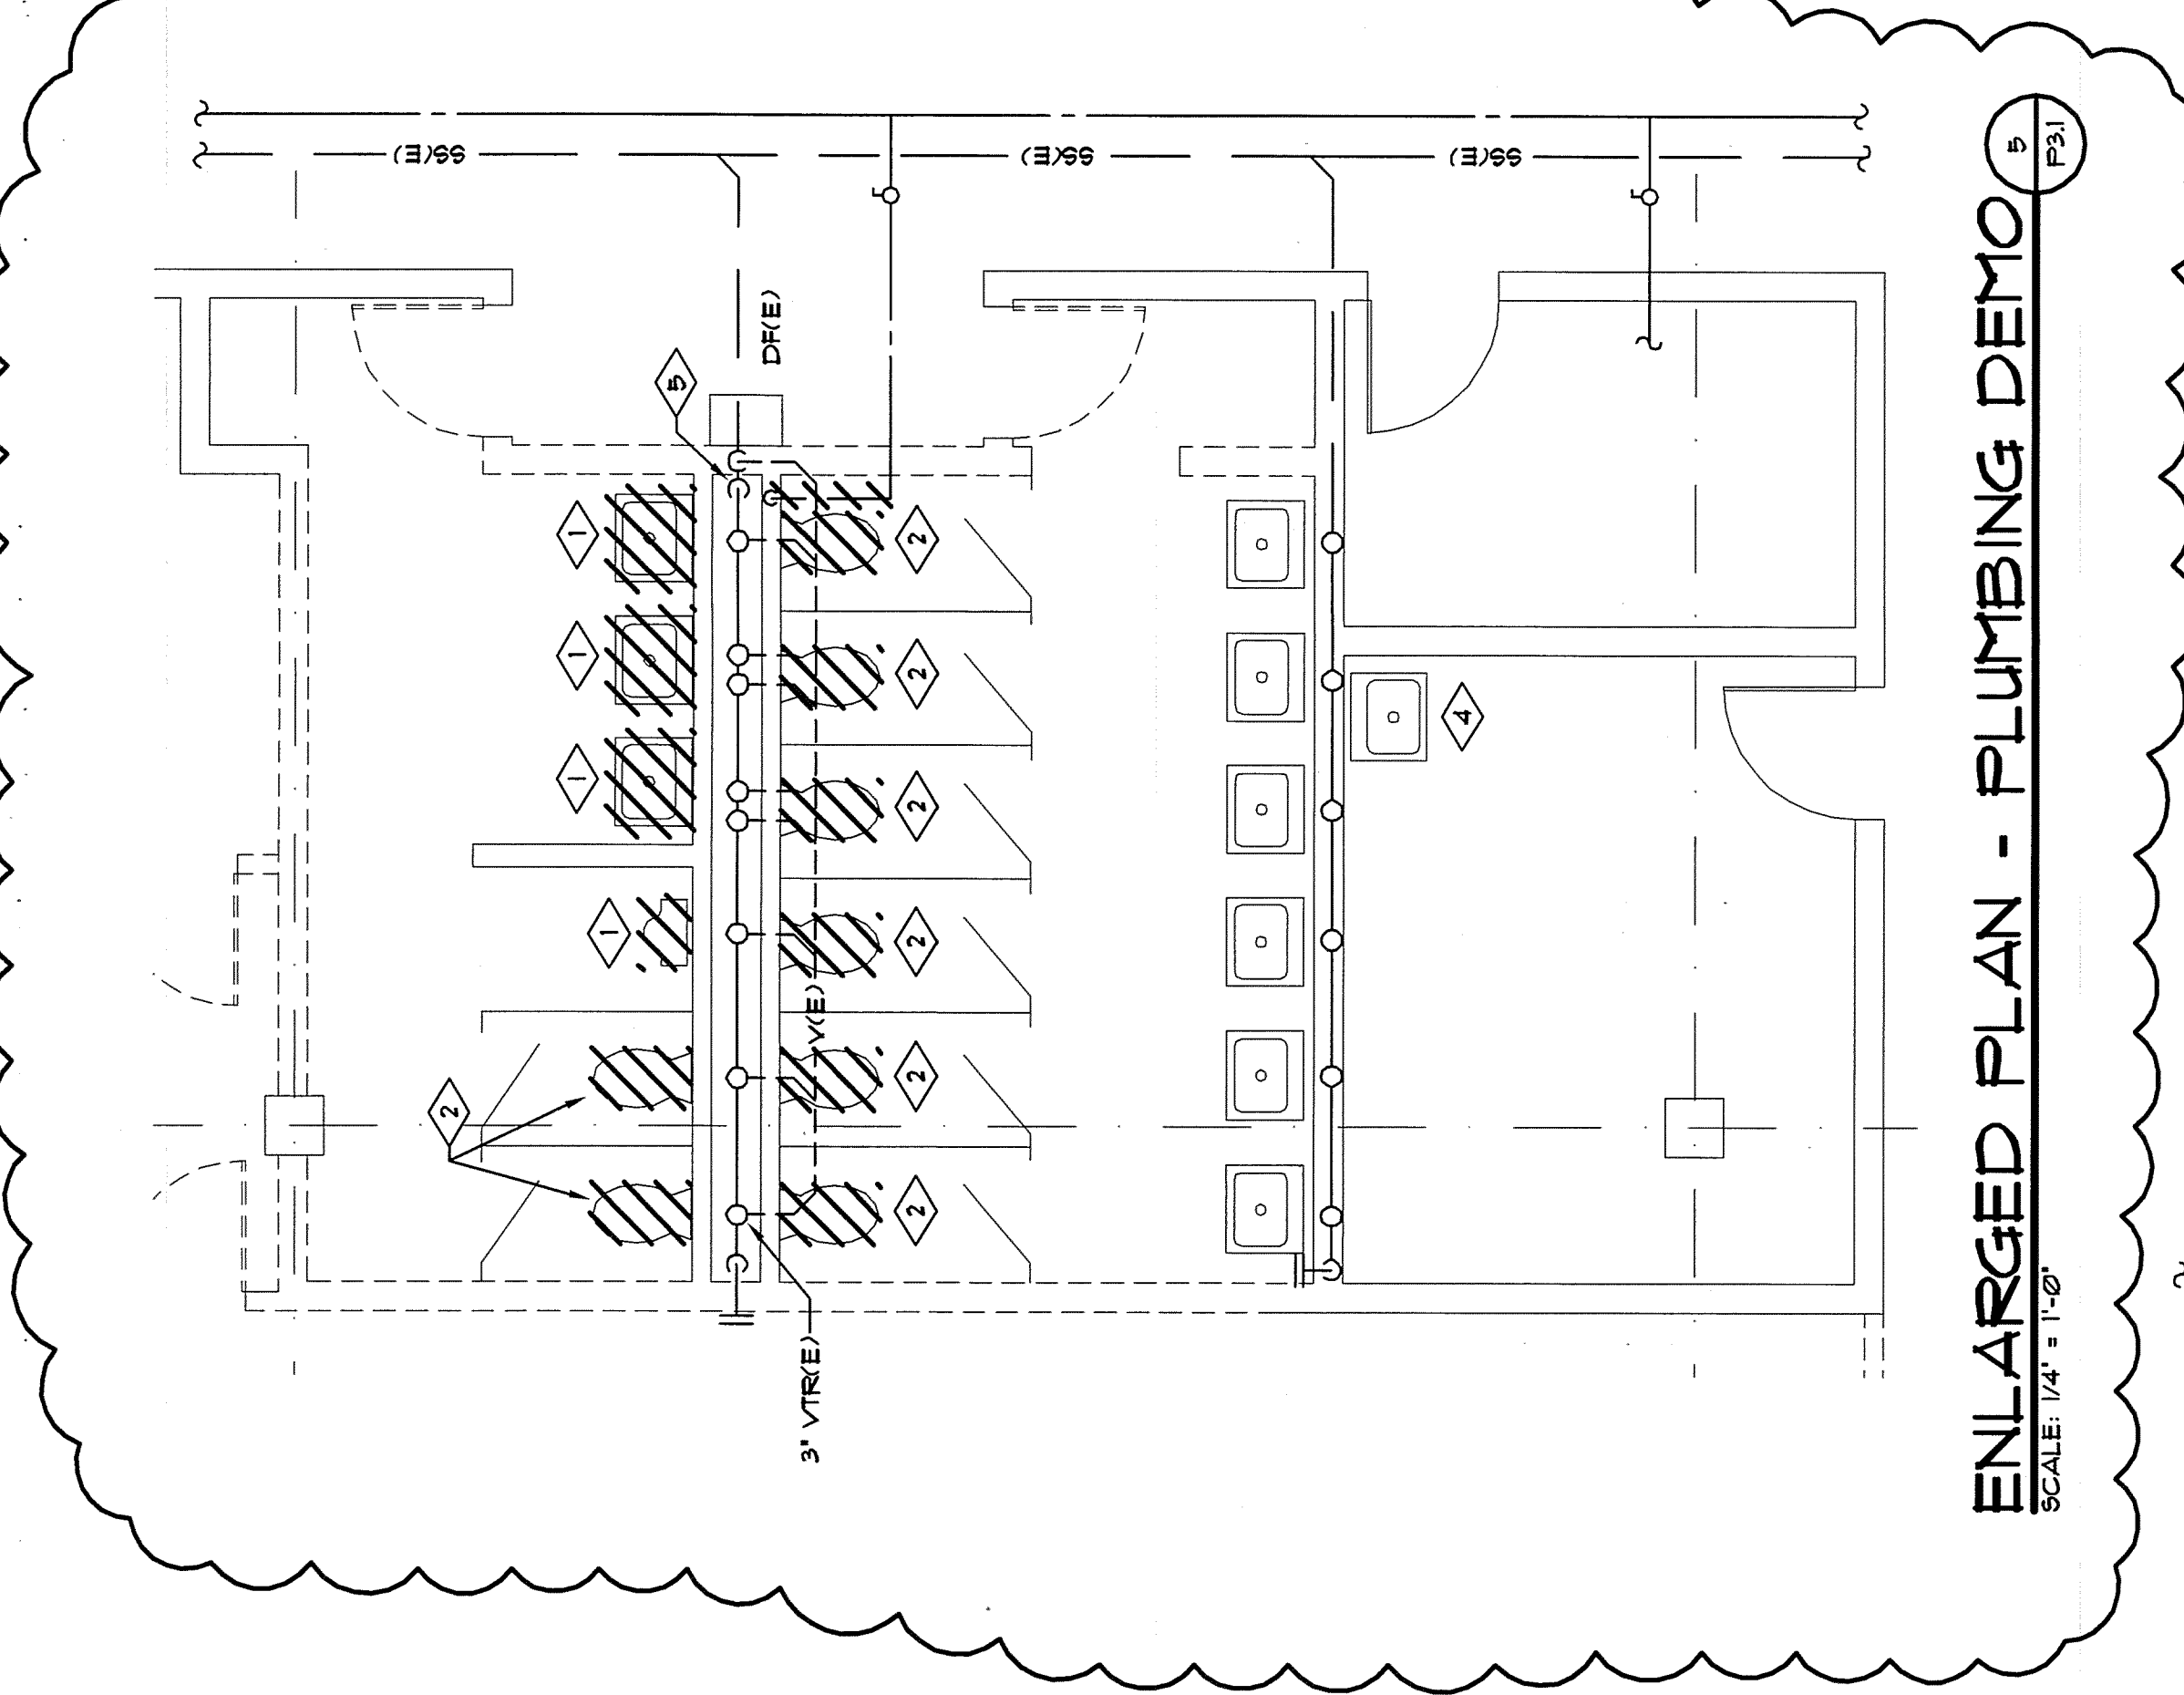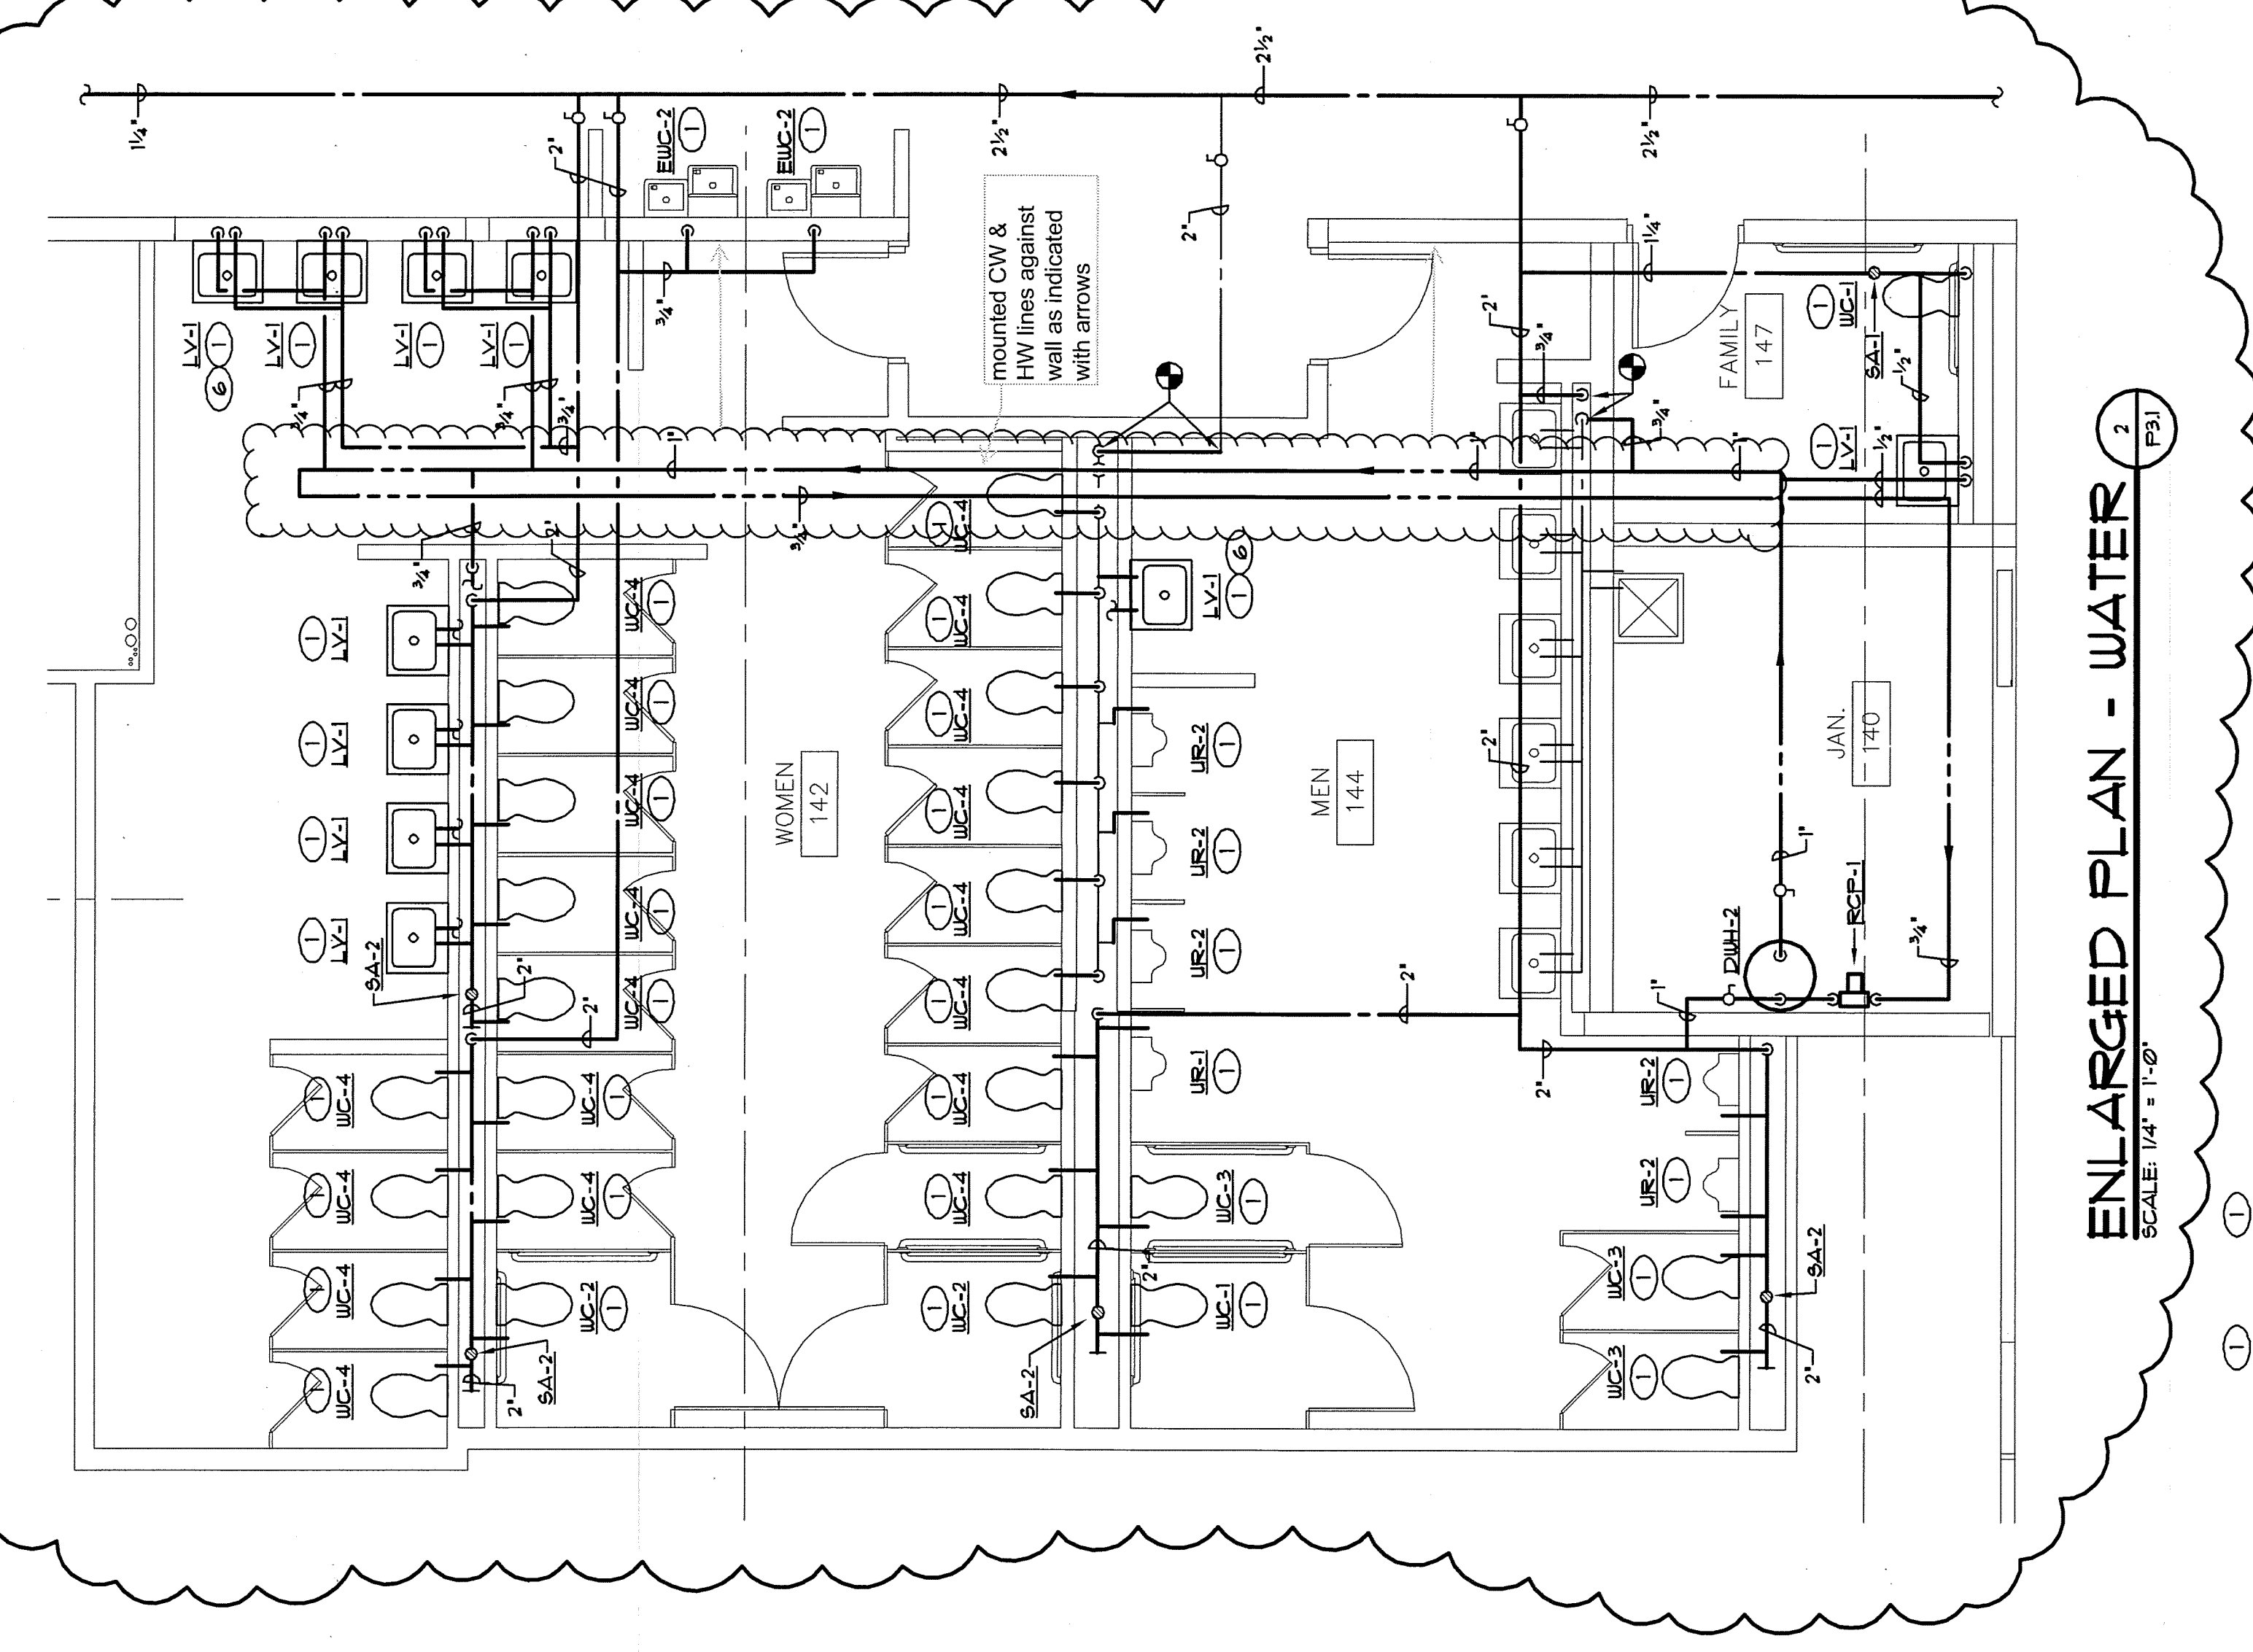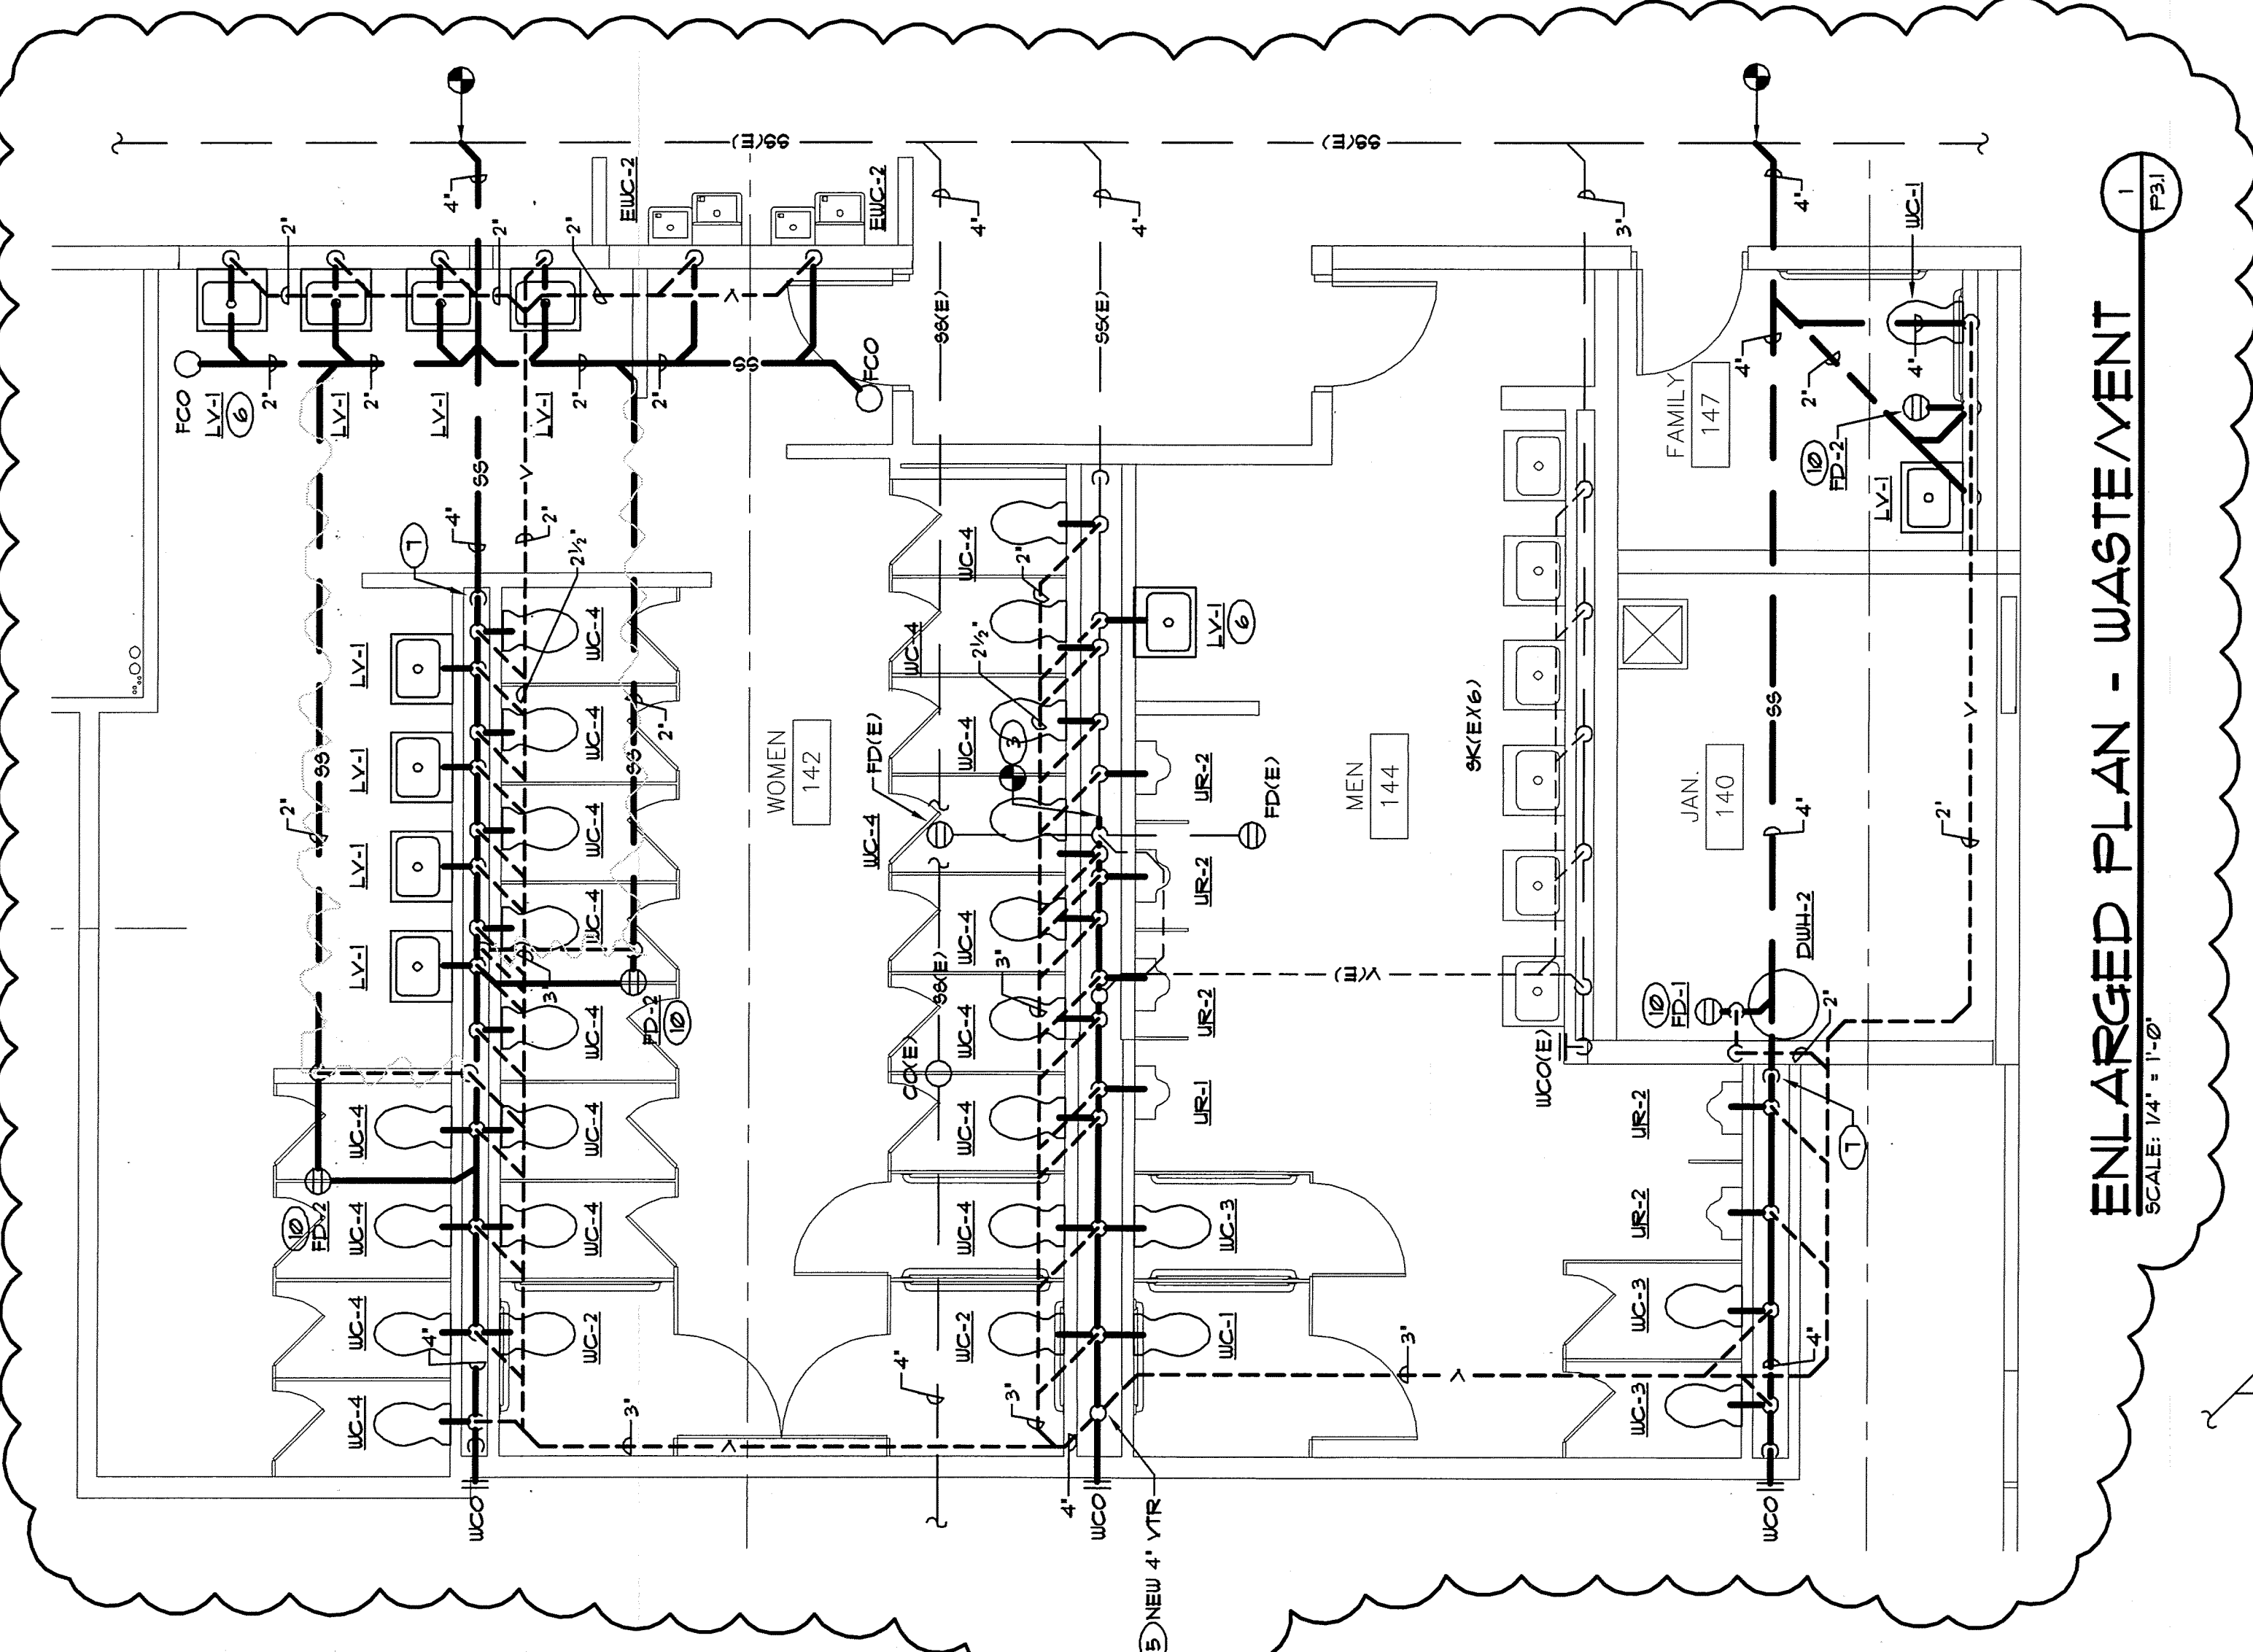


**LEGEND** (NOT ALL ITEMS WILL BE USED)

SYMBOL	DESCRIPTION
SW	SOFT, COLD AND NON-POTABLE WATER PIPING
CU	CUPRO-NICKEL PIPING
HW	HOT WATER AND HOT WATER CIRCULATING PIPING
Ox, A, Vu	MEDICAL OXYGEN, AIR AND VACUUM PIPING
FDV	FUEL OIL, FUEL OIL VENT PIPING
BS, GSS	SANITARY SEWER AND GREASE SANITARY SEWER PIPING
RD, CRD	ROOF DRAIN AND OVERFLOW ROOF DRAIN PIPING
FCO, WCO, COTG	FLOOR CLEANOUT, WALL CLEANOUT AND CLEANOUT TO GRADE PIPING TO BE REMOVED
	UNION FLANGE BOND FLANGE
	BOY GATE VALVE, BALL VALVE, GLOBE VALVE, BUTTERFLY VALVE
	CHECK VALVE, STRAINER
	PLUG VALVE, CALIBRATED AND DYNAMIC BALANCING VALVES
	LUBRICATED PLUG VALVE
	PRESSURE REDUCING VALVE
	THREE WAY CONTROL VALVE, SOLENOID AND TWO-WAY / THORIZED CONTROL VALVE
	REDUCED PRESSURE BACKFLOW PREVENTER
	ANGLE RELIEF VALVE, GAUGE AND COCK, THERMOPETER
	TEST PLUG
LAV / HAV, HEV	HOSE END DRAIN VALVE, AUTOMATIC AIR / MANUAL AIR VENT
HB, UH	HOBEBIBB, FROSTPROOF WALL HYDRANT, DOWN SPOUT NOZZLE
	PIPE ELBOW DOWN, PIPE TEE DOWN, PIPE TEE UP, PIPE ELBOW UP
	PIPE ANCHOR, PIPE GUIDE, PIPE SLEEVE
	FLEX CONNECTION, PIPE EXPANSION JOINT
VTR	VENT THRU ROOF
I.E.	INVERT ELEVATION
E, R, N	EXISTING, RELOCATED AND NEW
	WORK NOTE 1, REVISION NO. 1, DEMOLITION NOTE 1, POINT OF CONNECTION
	SECTION A ON SHEET M-1
	DIAGRAM 1 ON SHEET M-1
	RIBER R-1 ON SHEET M-1
	SECTION B ON SHEET M-2
	DIAGRAM 2 ON SHEET M-2
	RIBER R-2 ON SHEET M-2
WC-3	FIXTURE OR EQUIPMENT TAG
	FIXTURE OR EQUIPMENT TYPE
	FIXTURE OR EQUIPMENT NUMBER

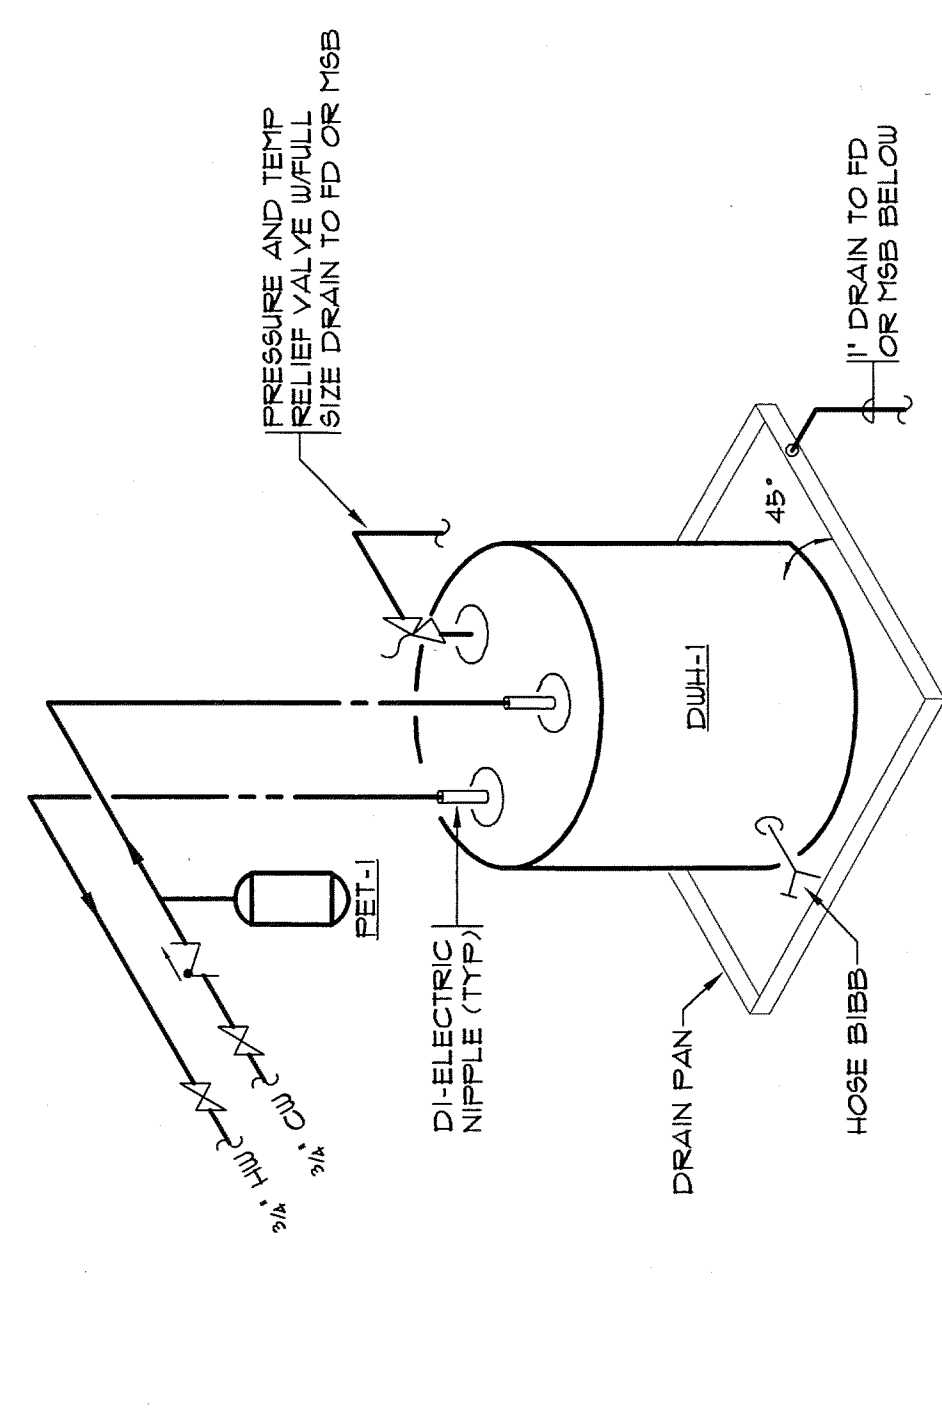

NOTE: REFERENCE PLAN FOR PIPE SIZES  
**DHW-1 DOMESTIC WATER HEATER**  
 SCALE: NONE

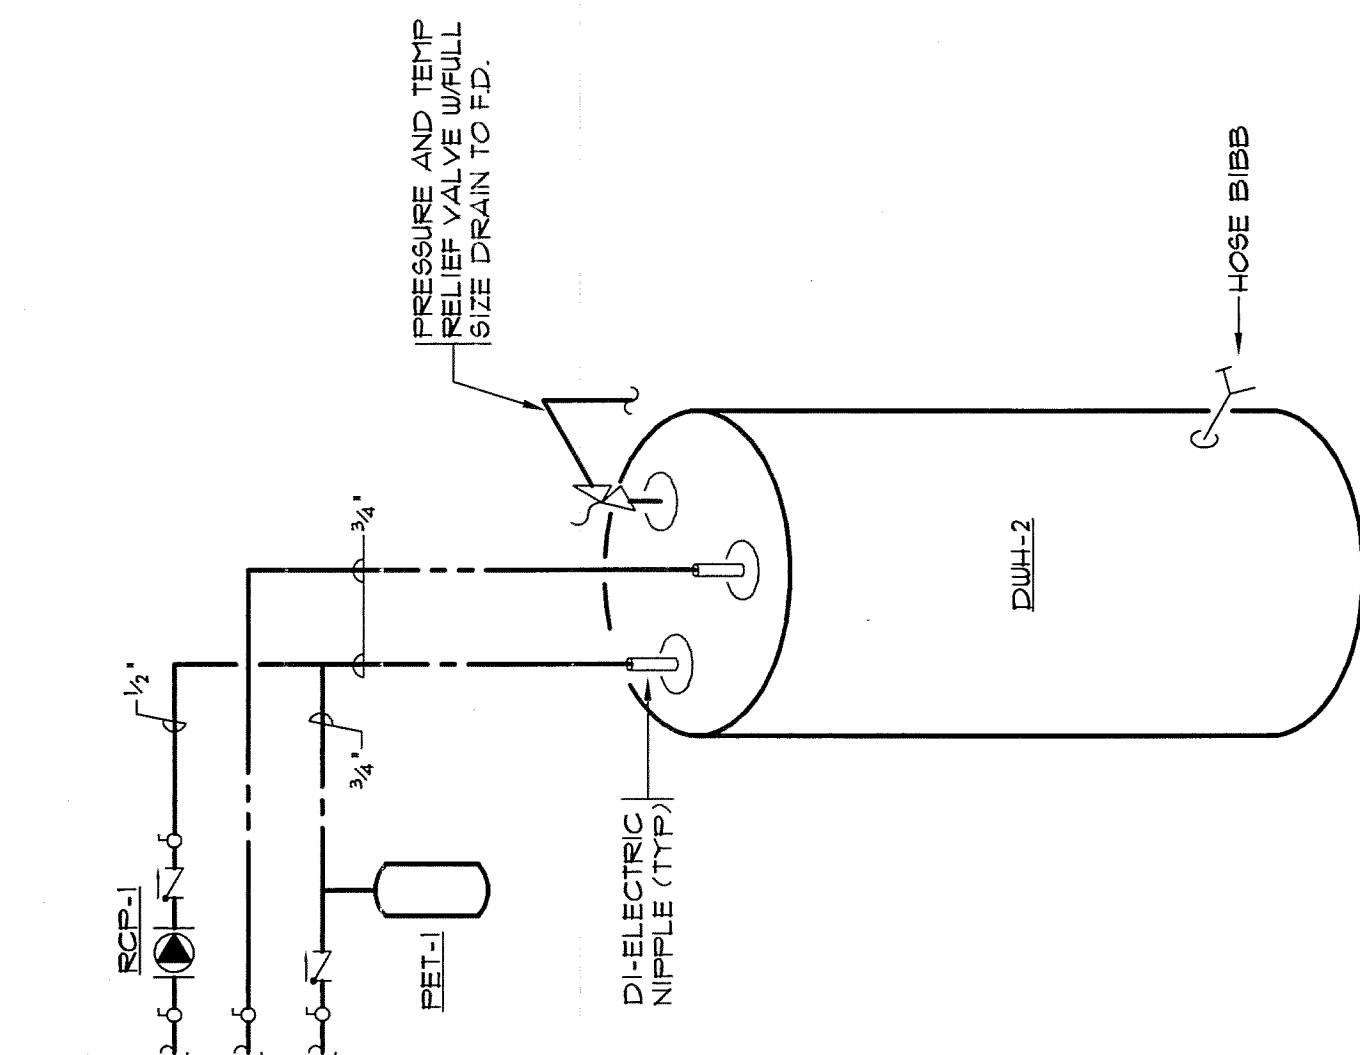

NOTE: REFERENCE PLAN FOR PIPE SIZES  
**DHW-2 DOMESTIC WATER HEATER**  
 SCALE: NONE

**DRAWING INDEX**

NUMBER	DRAWING TITLE
F01	DRAWING INDEX, GENERAL NOTES, LEGENDS AND SCHEDULES
F02	PARTIAL FLOOR PLAN - PLUMBING
F03	PARTIAL FLOOR PLAN - PLUMBING
F04	ENLARGED PLANS - WASTE/VENT/WATER

**GENERAL NOTES - PLUMBING**

- COORDINATE THE INSTALLATION OF PLUMBING SYSTEMS WITH OTHER TRADES. OFFSET PIPING AS NECESSARY TO AVOID CONFLICTS WITH OTHER WORK AND STRUCTURAL ABOVE CEILING AND/OR BELOW FLOOR.
- VERIFY EXACT LOCATION, SIZE AND INVERT ELEVATION OF ALL EXISTING UTILITIES AT SITE PRIOR TO INSTALLATION OF ANY PIPING SYSTEMS.
- RESOLVE ALL QUESTIONS OR CONFLICTS WITH THE ENGINEER BEFORE ANY EQUIPMENT IS ORDERED. MATERIALS FABRICATED OR SYSTEMS INSTALLED.
- REFER TO THE ARCHITECTURAL DRAWINGS FOR THE EXACT LOCATION OF THE PLUMBING FIXTURES AND ROOF DRAINS.
- SEAL ROOF PENETRATIONS WATERTIGHT WITH ROOF SYSTEM COMPATIBLE WITH ROOFING.
- CONNECT ALL NEW PIPING TO EXISTING USING APPROVED FITTINGS. PROVIDE VALVES ON DOMESTIC HOT AND COLD WATER PIPING AT CONNECTIONS. TAG VALVES TO IDENTIFY AREA SERVED.
- DOMESTIC WATER BRINGS SHALL BE TYPE "L" HARD COPPER WITH UNDRAGHT COPPER FITTINGS. NO LEAD SOLDER TO BE USED FOR SWEAT FITTINGS, OR PRESSURE FITTINGS MAY BE USED.
- INSULATE ALL DOMESTIC WATER PIPING AND ROOF DRAIN PIPING PER INSULATION SCHEDULES SHOWN IN PROJECT SPECIFICATIONS OR AS REQUIRED BY IBC.
- WASTE AND VENT PIPING SHALL BE SERVICE WEIGHT CAST IRON WITH NO-HUB FITTINGS ABOVE GRADE. PVC SCHEDULE 40 MAY BE USED BELOW GRADE. SLOPE ALL WASTE PIPING AT 1/4" PER FOOT MINIMUM UNLESS OTHERWISE NOTED.
- MAINTAIN THE UNIFORM SLOPE SHOWN ON THE PLANS FOR THE SANITARY SEWER, STORM DRAIN AND CONDENSATE DRAIN PIPING SYSTEMS.
- SUPPORT ALL CAST IRON SOIL PIPE, COPPER PIPE AND STEEL PIPE RISERS AT EVERY STORY MINIMUM.
- ALL SANITARY VENTS SHALL BE LOCATED MINIMUM 10'-0" FROM BUILDING OUTSIDE AIR INTAKES.
- INSTALLATION SHALL CONFORM TO THE REQUIREMENTS OF THE 2020 INTERNATIONAL PLUMBING CODE, APPLICABLE SECTIONS OF THE INTERNATIONAL BUILDING CODE.
- OWNER WILL SUPPLY ABRETTOS MATERIALS TESTING, AND CLEARANCE REPORTS. ANY MATERIAL SUSPECTED TO CONTAIN ABRETTOS SHALL BE IMMEDIATELY IDENTIFIED BY LOCATION, MATERIAL TYPE, IDENTIFICATION NUMBER AND QUANTITY. MATERIALS IDENTIFIED AS ABRETTOS SHALL BE IMMEDIATELY IDENTIFIED AS ABRETTOS. MATERIALS IDENTIFIED AS ABRETTOS SHALL BE IMMEDIATELY IDENTIFIED AS ABRETTOS.

**PLUMBING FIXTURE SCHEDULE**

NOTES: 1) PROVIDE WITH 3 HOLE 4" CENTER SET FAUCET PUNCH. 2) INSTALL BLOCKING AS REQUIRED TO SUPPORT FAUCET.

TAG	FIXTURE DESCRIPTION	TRAP	WASTE	VENT	CU	HW	HOT
WC-1	WALL HANG WATER CLOSET - ZURN Z545(021) SIPHON JET ACTION 16 GPF WHITE VITREOUS CHINA ELONGATED BOWL 18" TOP INLET SPUD. PROVIDE DRAIN 2X2622AV(181) FLUSH VALVE WITH ADA FLUSH HANDLE. OLSONITE 95 OPEN FRONT BEAT LESS COVER. PROVIDE CLOSET CARRIER FOR AN INSTALLED RIM HEIGHT OF 18" FOR ADA.	NT	4"	2"	1/4"	---	---
WC-2	WALL HANG WATER CLOSET - ZURN Z546(021) SIPHON JET ACTION 16 GPF WHITE VITREOUS CHINA ELONGATED BOWL 18" TOP INLET SPUD. PROVIDE DRAIN 2X2622AV(181) FLUSH VALVE WITH ADA FLUSH HANDLE. OLSONITE 95 OPEN FRONT BEAT LESS COVER. PROVIDE CLOSET CARRIER FOR AN INSTALLED RIM HEIGHT OF 18" FOR ADA.	NT	4"	2"	1/4"	---	---
WC-3	WALL HANG WATER CLOSET - ZURN Z546(021) SIPHON JET ACTION 16 GPF WHITE VITREOUS CHINA ELONGATED BOWL 18" TOP INLET SPUD. PROVIDE DRAIN 2X2622AV(181) FLUSH VALVE WITH ADA FLUSH HANDLE. OLSONITE 95 OPEN FRONT BEAT LESS COVER. PROVIDE CLOSET CARRIER FOR STANDARD RIM HEIGHT (NON ADA).	NT	4"	2"	1/4"	---	---
WC-4	WALL HANG WATER CLOSET - ZURN Z546(021) SIPHON JET ACTION 16 GPF WHITE VITREOUS CHINA ELONGATED BOWL 18" TOP INLET SPUD. PROVIDE DRAIN 2X2622AV(181) FLUSH VALVE WITH ADA FLUSH HANDLE. OLSONITE 95 OPEN FRONT BEAT LESS COVER. PROVIDE CLOSET CARRIER FOR STANDARD RIM HEIGHT (NON ADA).	NT	4"	2"	1/4"	---	---
UR-1	WALL HANG URINAL - ZURN Z575(102) GPF SIPHON JET SINGLE WALL OUTLET. 1/4" TOP SPUD. WHITE VITREOUS CHINA. PROVIDE ZURN Z575(102) FLUSH VALVE WITH ADA FLUSH HANDLE. PROVIDE BEHAVIOR STRAINER AND SMITH SERIES 0631 URINAL SUPPORT. LIP HEIGHT FOR ADA.	NT	2"	2"	3/8"	---	---
UR-2	WALL HANG URINAL - ZURN Z575(102) GPF SIPHON JET SINGLE WALL OUTLET. 1/4" TOP SPUD. WHITE VITREOUS CHINA. PROVIDE ZURN Z575(102) FLUSH VALVE WITH ADA FLUSH HANDLE. PROVIDE BEHAVIOR STRAINER AND SMITH SERIES 0631 URINAL SUPPORT. LIP HEIGHT FOR ADA.	NT	2"	2"	3/8"	---	---
LX-1	WALL HANG LAVATORY - ZURN Z3360 WHITE VITREOUS CHINA 4" FAUCET CENTERS. PROVIDE ZURN Z3360 SINGLE HANDLE METERING FAUCET, OPEN GRID DRAIN, OFFSET VITREOUS CHINA ELONGATED BOWL 18" TOP INLET SPUD. PROVIDE DRAIN 2X2622AV(181) FLUSH VALVE WITH ADA FLUSH HANDLE. OLSONITE 95 OPEN FRONT BEAT LESS COVER. PROVIDE CLOSET CARRIER FOR STANDARD RIM HEIGHT (NON ADA).	18"	2"	18"	1/2"	1/2"	1/2"
EMC-1	WATER COOLER - ELKAY ETB400 SINGLE LEVEL, CHROME PLATED STEEL HOOD-BUILDING BUBBLER FRONT AND SIDE FISH BAR OPERATION. NON REFRIGERATED. PROVIDE N LIGHT GREY GRANITE.	1/4"	2"	18"	1/2"	---	---
EMC-2	WATER COOLER - ELKAY ETB400 SINGLE LEVEL, CHROME PLATED STEEL HOOD-BUILDING BUBBLER FRONT AND SIDE FISH BAR OPERATION. NON REFRIGERATED. PROVIDE N LIGHT GREY GRANITE.	1/4"	2"	18"	1/2"	---	---
MB-1	HOP SERVICE BASIN - FIAT, MODEL 195C-18(9) NEO CORNER TERRAZZO WITH 6" DROP FRONT. PROVIDE DELTA SERVICE 5/8" FITTING 2822383 WITH VACUUM BREAKER, HOSE THREAD, OUTLET AND PAUL HOOK. NOTE 2.	3"	3"	2"	1/2"	1/2"	1/2"


**PLUMBING EQUIPMENT SCHEDULE**

NOTES: 1)


TAG	EQUIPMENT DESCRIPTION
PLUMBING	PLUMBING
RCF-1	HU RECIRC PUMP - IN-LINE CIRCULATOR TACO MODEL 6023RHP ALL BRONZE PUMP WITH A CAPACITY OF 15 GPM @ 4' HEAD. 1/409 HP. 18V - 1 PHASE. 40 AMP. 1/2" SWEET CONNECTION. PROVIDE WITH TITNER STEEL BRONZE 200# TANK 200# PHASE. 41.655 LINED TANK 2"NS BLIND COPPER ELEMENTS ADJUSTABLE CONTROL. 18T. ANODE ROD. ASME TP VALVE. DRAIN VALVE. PROVIDE BEAT TRAP AND VACUUM BREAKER FOR SIDE INLET PIPING CONFIGURATION.
DHW-1	DOMESTIC WATER HEATER - A.O. SMITH DEN-300 30 GALLON TANK SINGLE 5 KW HEATER. 208V/1 PHASE. GLASS LINED TANK ZINC PLATED COPPER ELEMENTS ADJUSTABLE CONTROL. 18T. ANODE ROD. ASME TP VALVE. DRAIN VALVE.
DHW-2	DOMESTIC WATER HEATER - A.O. SMITH DEN-300 30 GALLON TANK SINGLE 5 KW HEATER. 208V/1 PHASE. GLASS LINED TANK ZINC PLATED COPPER ELEMENTS ADJUSTABLE CONTROL. 18T. ANODE ROD. ASME TP VALVE. DRAIN VALVE.
FD-1	FLOOR DRAIN - ZURN 419 CAST IRON BODY WITH FLASHING COLLAR AND SQUARE NICKEL BRONZE 1/4" GRATE AND STRAINER WITH TRAP. PROVIDE WITH "SURE SEAL" TRAP SEAL.
SA-1	SHOCK ARRESTOR - ZURN Z1700 #400.
SA-2	SHOCK ARRESTOR - ZURN Z1700 #400.
HB-1	HOSE BIBB - WOODFORD MODEL 26 WALL FAUCET WITH FIELD TESTABLE BACKFLOW PREVENTER.
PET-1	POTABLE EXPANSION TANK - ANTRON TUBER-X TPO1 57.5-G. 50 GALLON OPERATING FACTOR. 21 GALLON TOTAL VOLUME. 50 PSIG MIN. AND 150 PSIG MAX OPERATING PRESSURE. FDA APPROVED. OPERATING WEIGHT IS 19 LBS. 3/4" CU.
EHT	ELECTRIC HEAT TRACE - CHROMOLOX 8413-GS TRACE, UL LISTED, 8 BTU/HR PER LINEAR FOOT, SELF REGULATING - SET @ 40°F.

REVISIONS


- WORK NOTES (THIS SHEET ONLY)**
- EXISTING DOMESTIC WATER PIPING TO BE RAISED TO BOTTOM OF STRUCTURE.
  - COORDINATE TO INSTALL PIPING ALONG WITH NEW HEATING WATER PIPING.
  - CONNECT TO EXISTING PIPING TO SERVE MECHANICAL AREA.
  - RECONNECT PIPING IN MECHANICAL ROOM TO ISOLATE OLD WATER SUPPLIES TO MAINTAIN OTHER WATER SUPPLIES TO MECHANICAL ROOM.
  - PROVIDE "X" ISOLATION VALVE IN VERTICAL LINE 9' AFF.

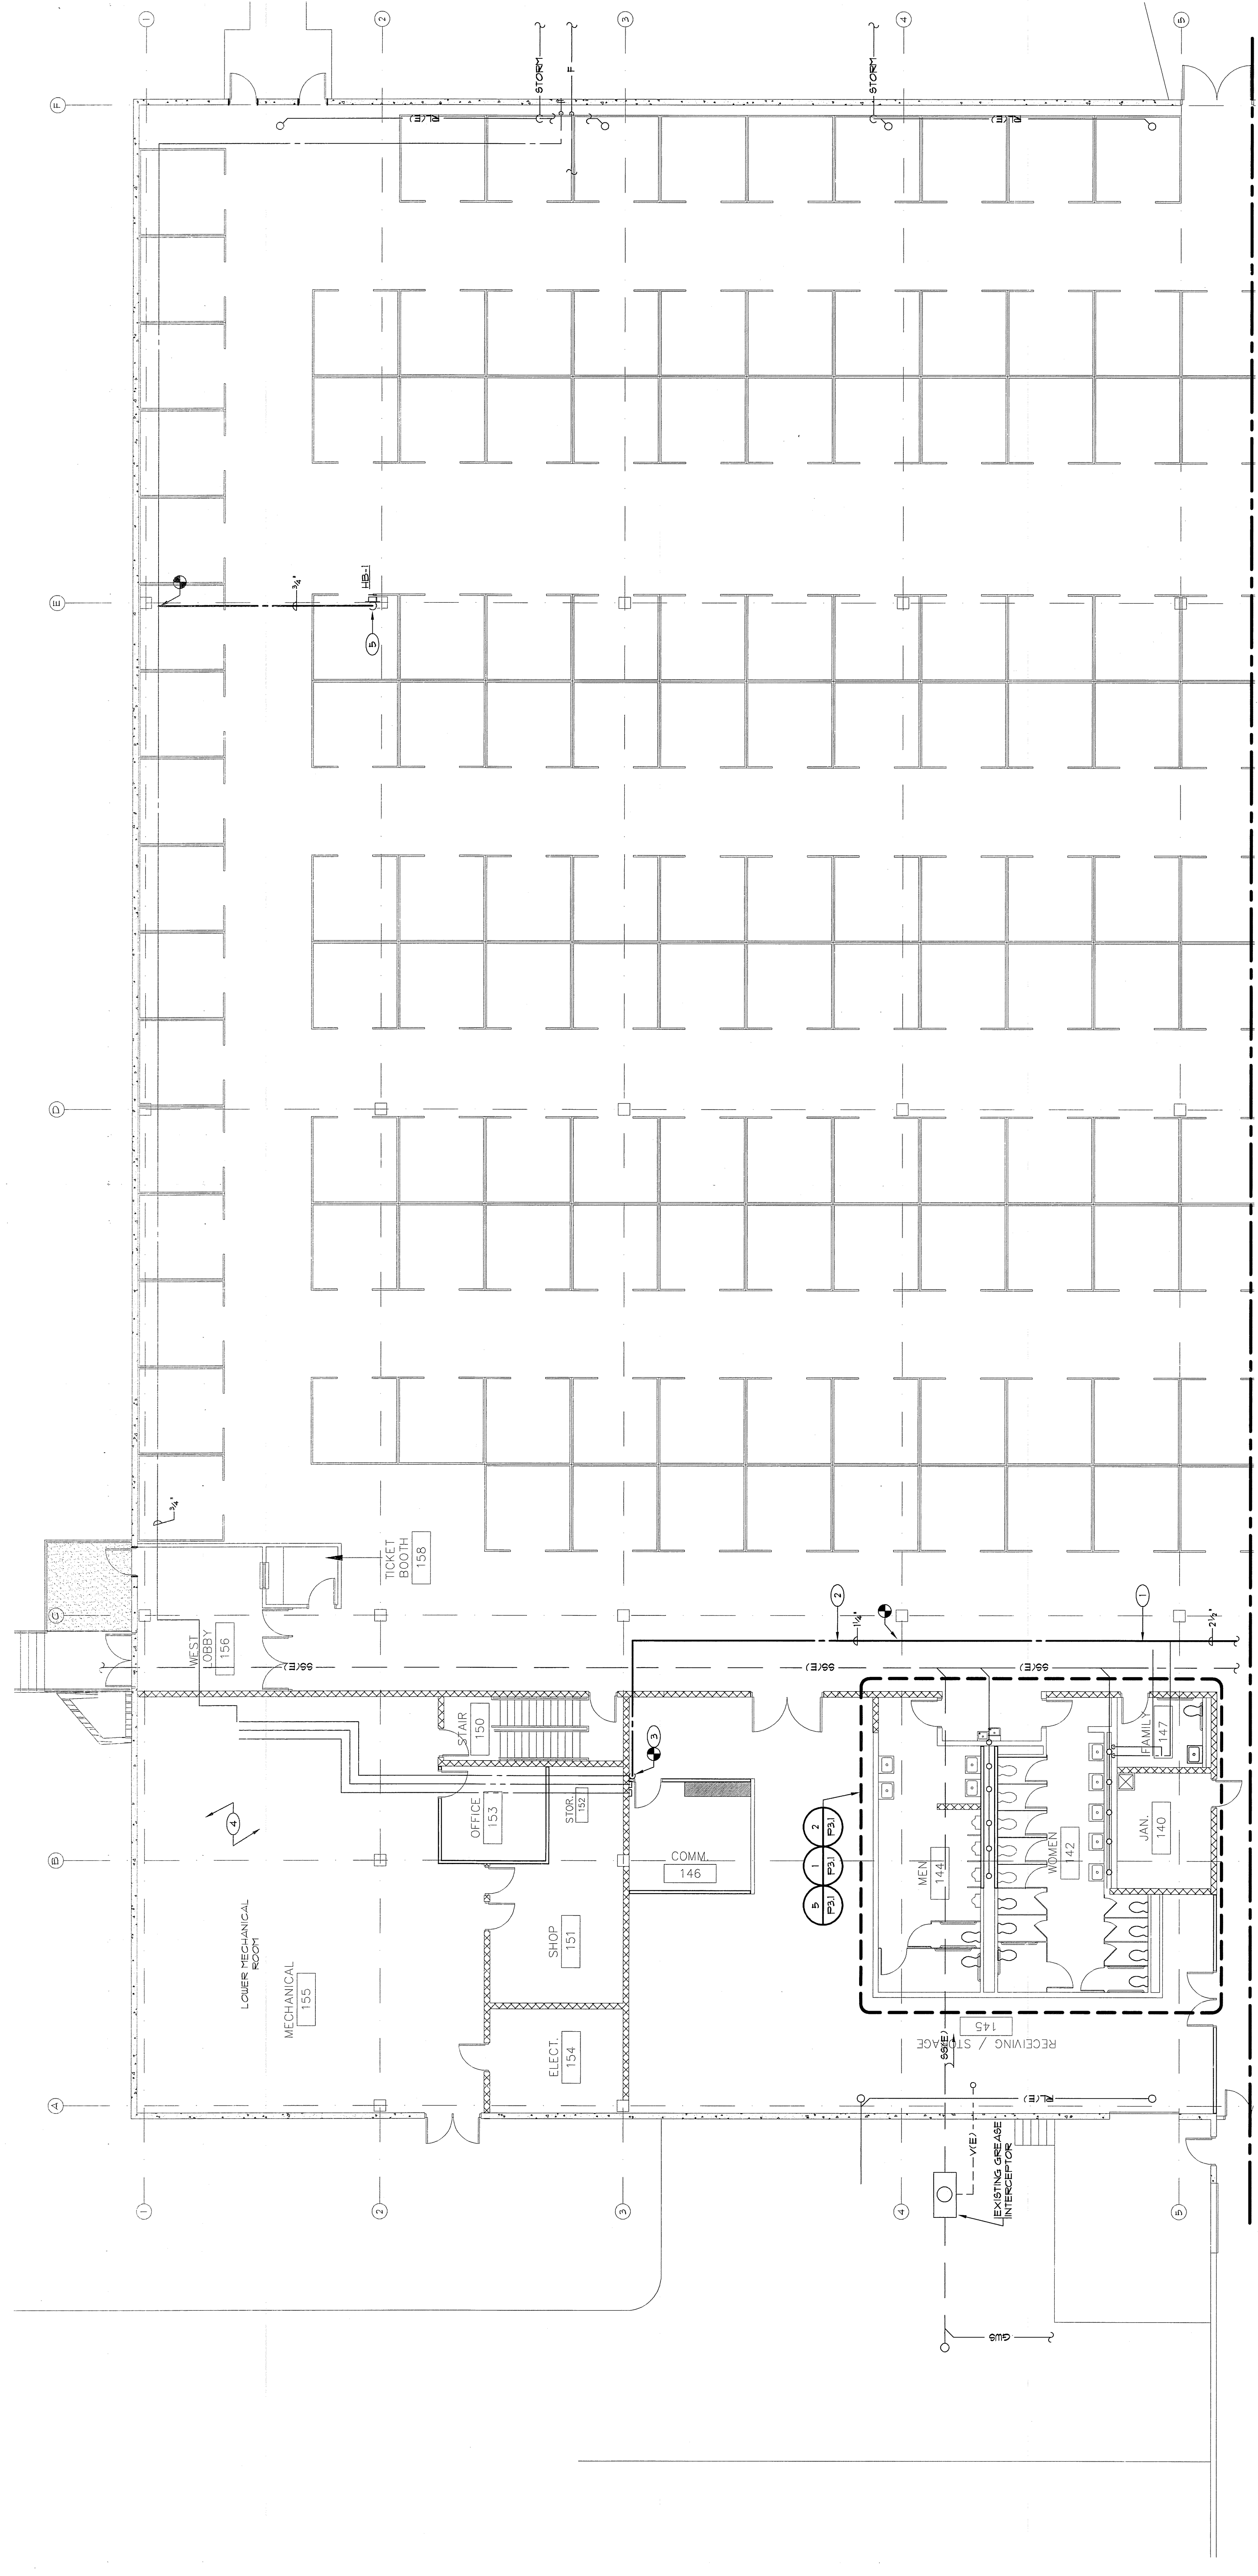




**PARTIAL FLOOR PLAN - PLUMBING**  
SCALE: 1/8" = 1'-0"

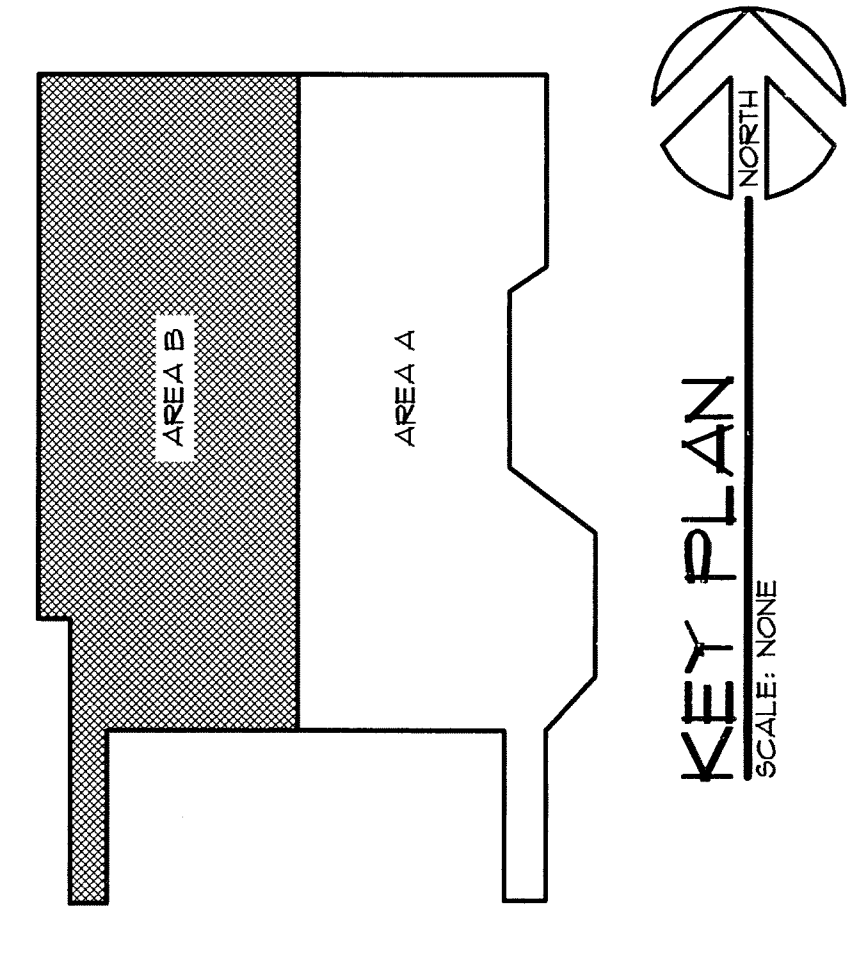

**KEY PLAN**  
SCALE: NONE





- WORK NOTES (THIS SHEET ONLY)**
- 1 PROVIDE NEW CU AND/OR HU TO NEW FIXTURES.
  - 2 CONNECT NEW 2" WASTE FROM NEW DRINKING FOUNTAIN TO EXISTING STACK PREVIOUSLY FOR DRINKING FOUNTAIN.
  - 3 CONNECT TO EXISTING 4" ABOVE GRADE GANG PIPING.
  - 4 CONNECT NEW FIXTURE VENTING TO EXISTING 3" VENT THRU ROOF.
  - 5 CONNECT ALL NEW FIXTURES TO NEW 4" VTR.
  - 6 CONNECT NEW 2" WASTE FROM DRINKING FOUNTAIN TO EXISTING 4" ABOVE GRADE WASTE.
  - 7 NEW 4" ABOVE GRADE GANG PIPING PROPS TO BELOW GRADE.
  - 8 REPLACE EXISTING URINAL WITH NEW LOU CONSUMPTION UR-2 (ACCEPTED ADD ALTERNATE).
  - 9 HODDITY OLD SINK CUI/HU PIPING FOR NEW M85 FAUCET.
  - 10 INSTALL NEW FLOOR DRAIN WITH TRAF GUARD SEAL.
  - 11 SUPPORT WATER HEATER ABOVE CEILING USING ANGLE IRON TO BRAN WALLS, AND PROVIDE DRAIN FAN UNDER WATER HEATER.
- DEMO NOTES (THIS SHEET ONLY)**
- 1 REMOVED UNDER DEMO SCOPE.
  - 2 REMOVE ADDITIONAL FIXTURES TO BE REPLACED WITH URINALS.
  - 3 ROUGH-IN TO BE CHANGED FROM WATER CLOSET WALL HANG TO URINAL ROUGH-IN.
  - 4 REMOVE SERVICE SINK WATER LINES TO BE REUSED.
  - 5 4" DROFF THROUGH FLOOR TO BE RELOCATED.
- NOTE:**  
FIXTURES WITHOUT TAGS/ID ARE EXISTING, TO REMAIN UNLESS OTHERWISE NOTED.

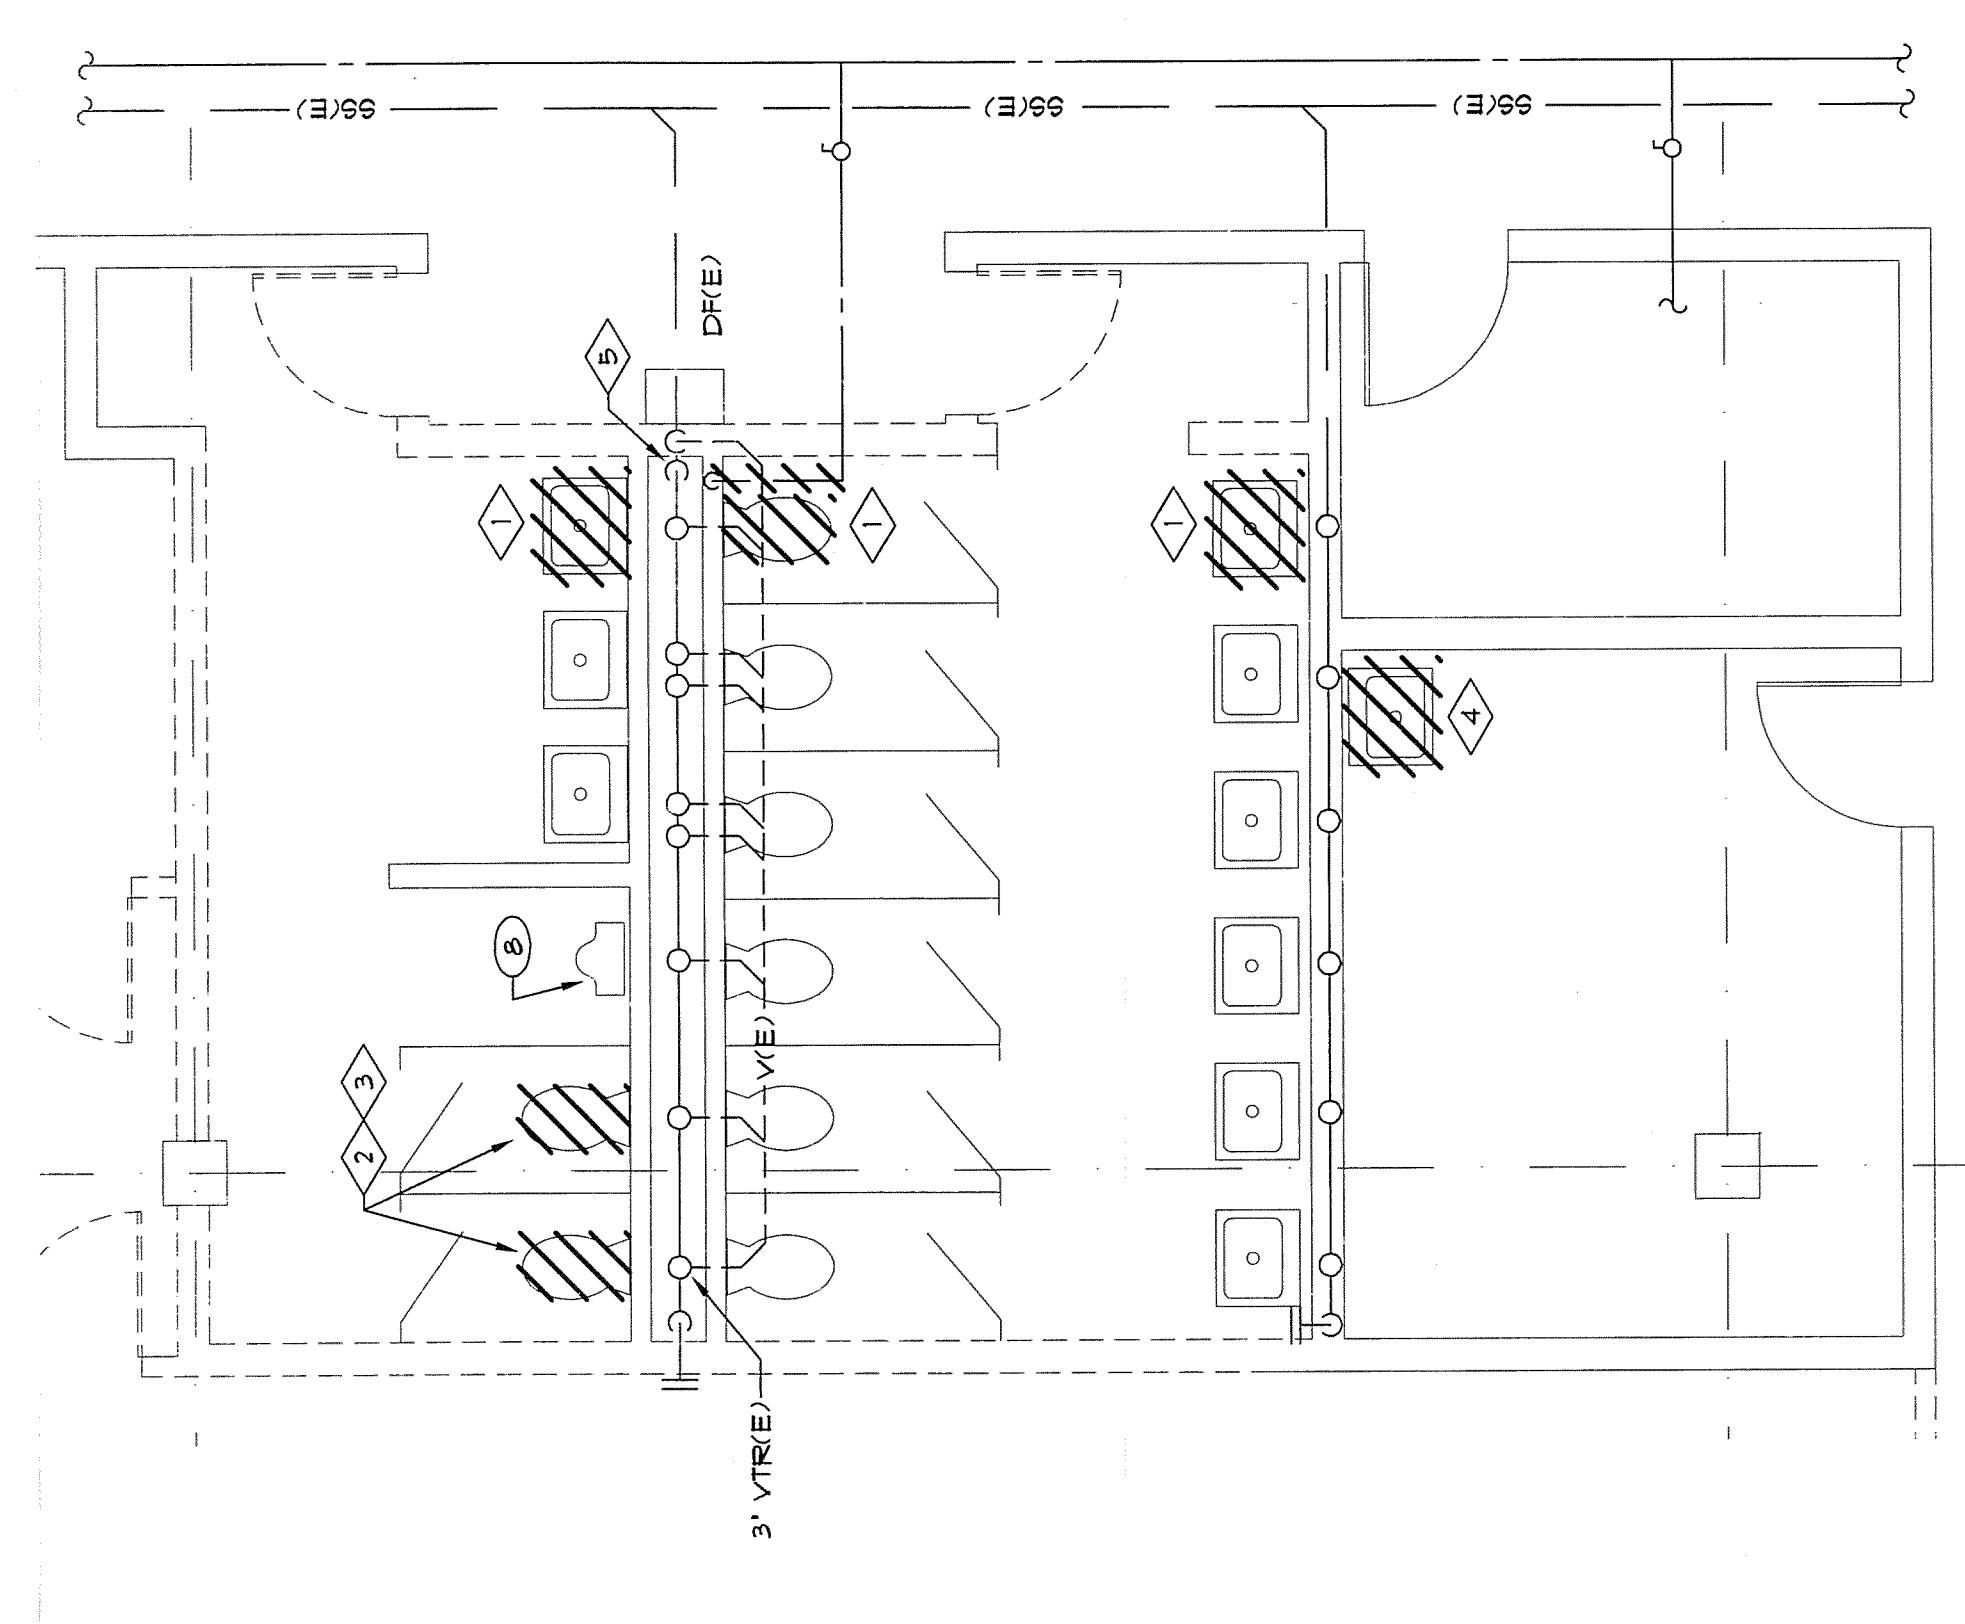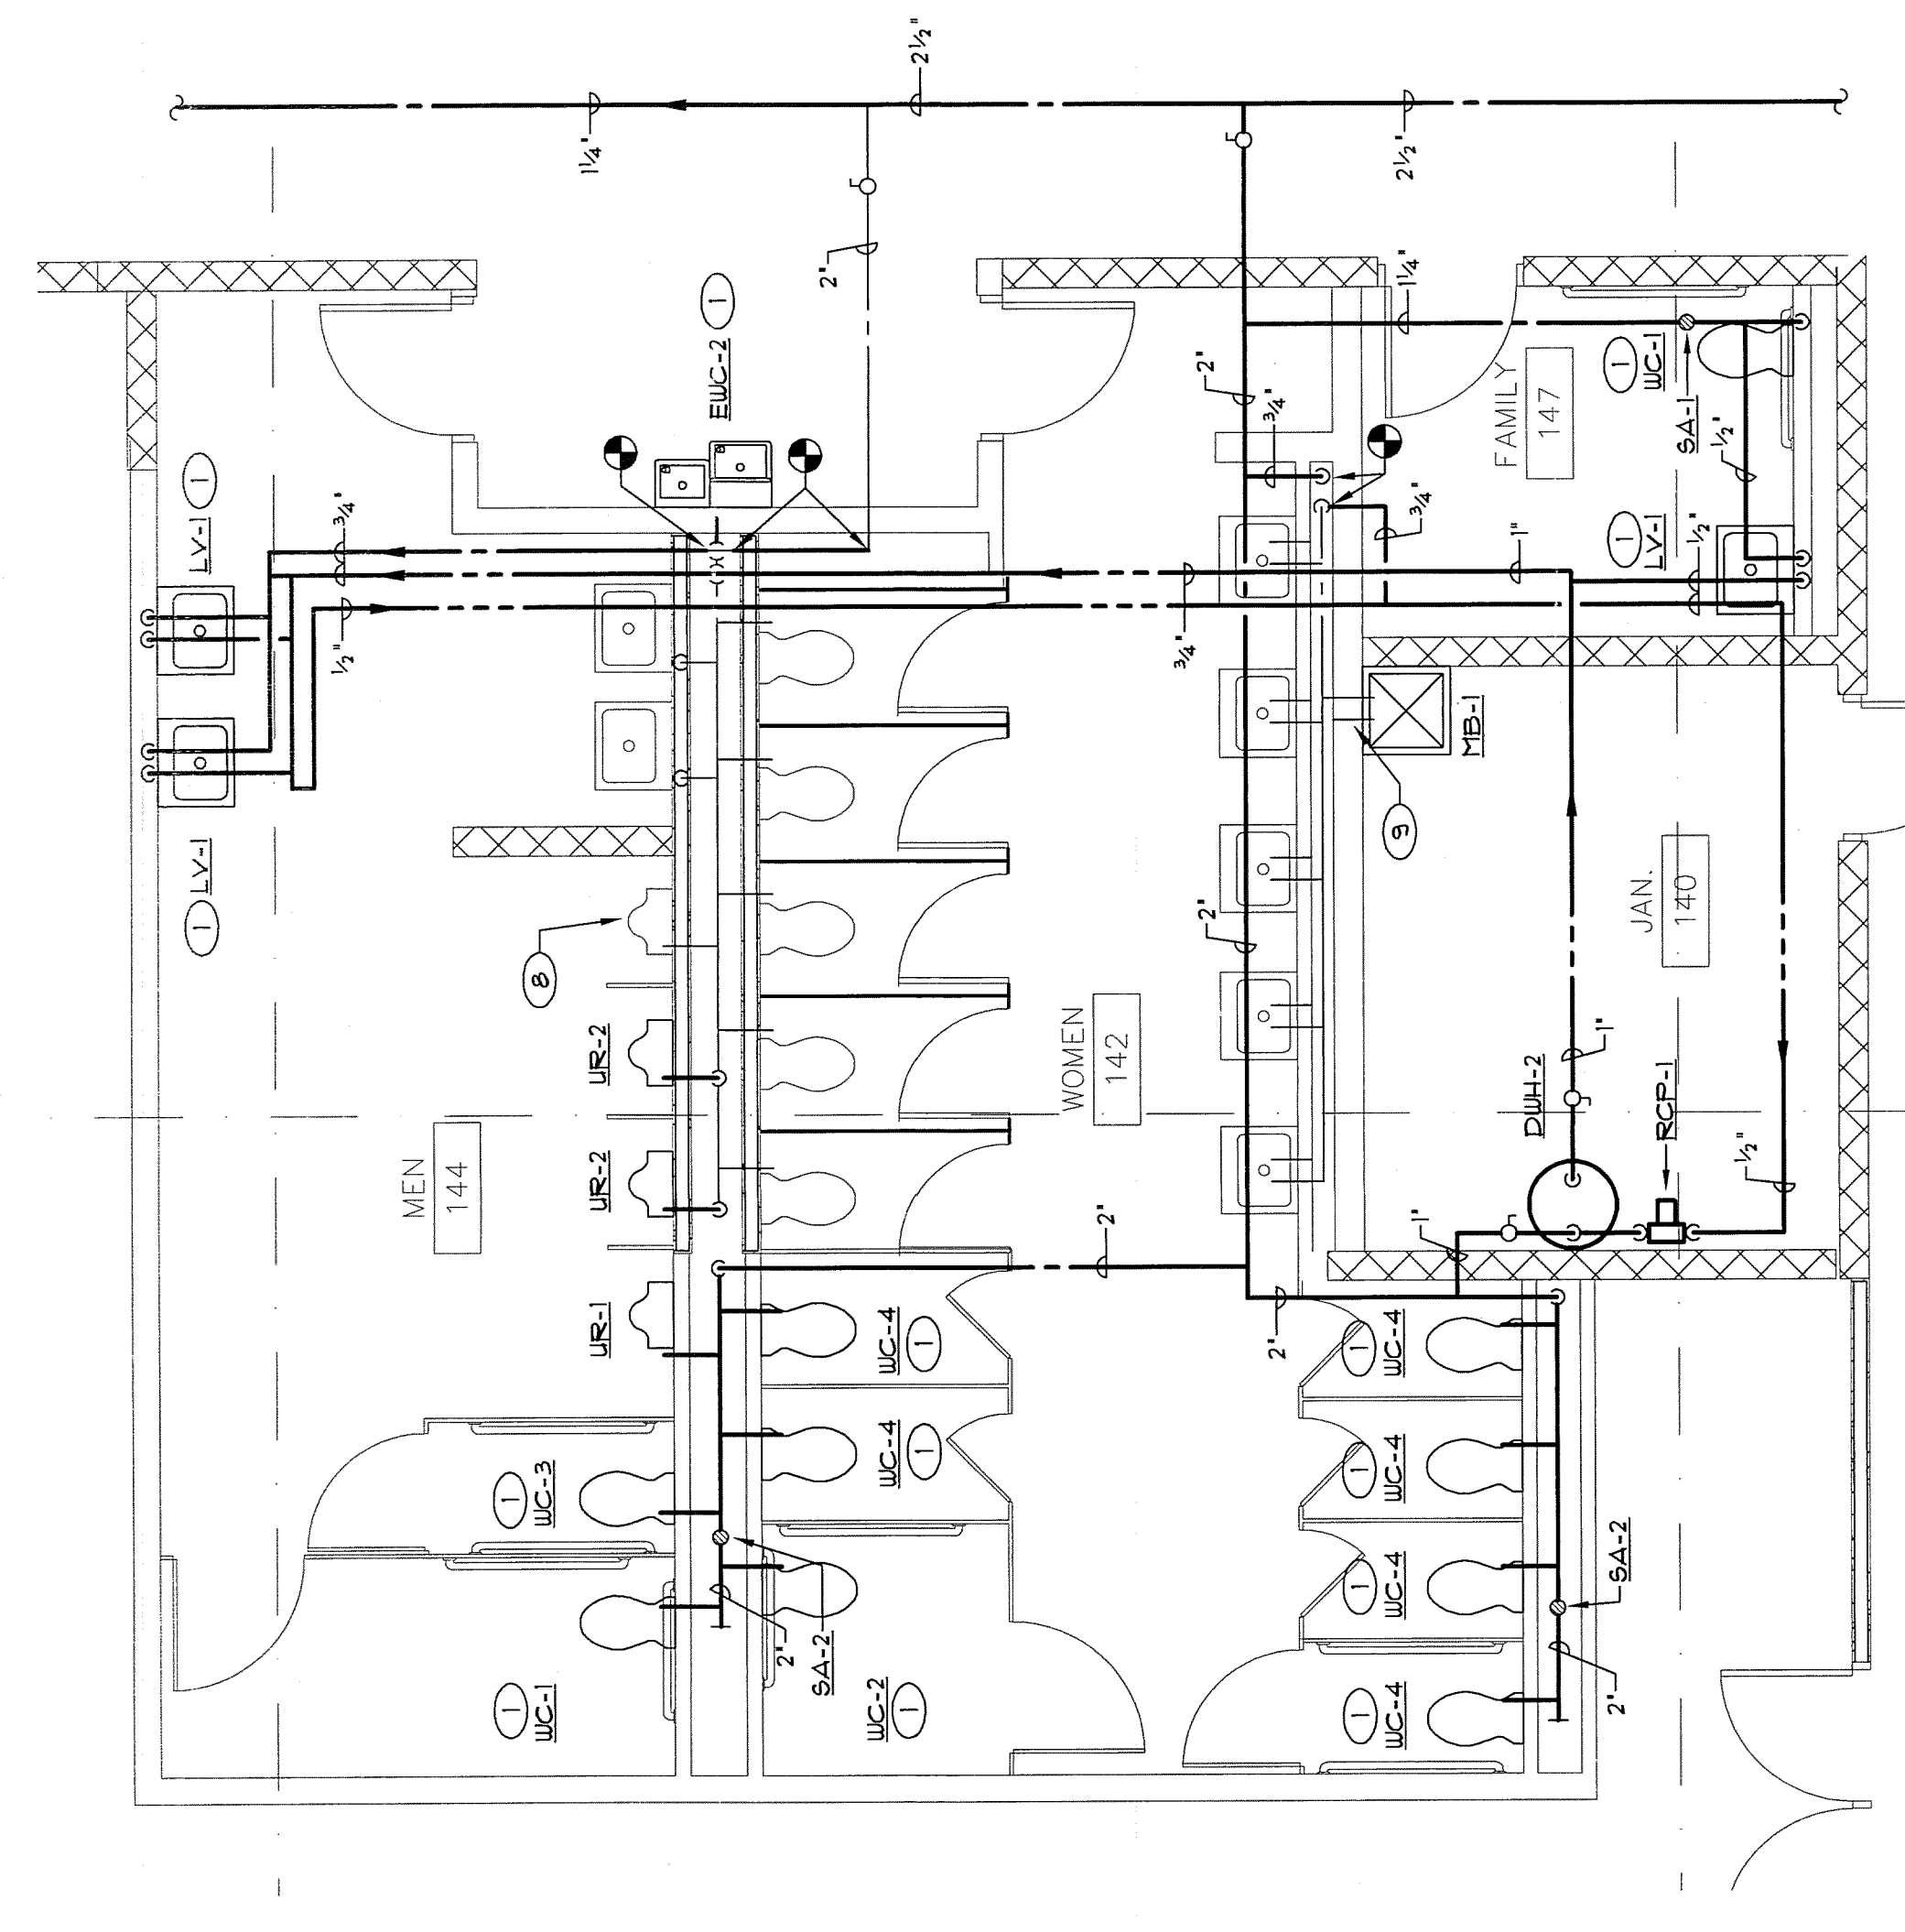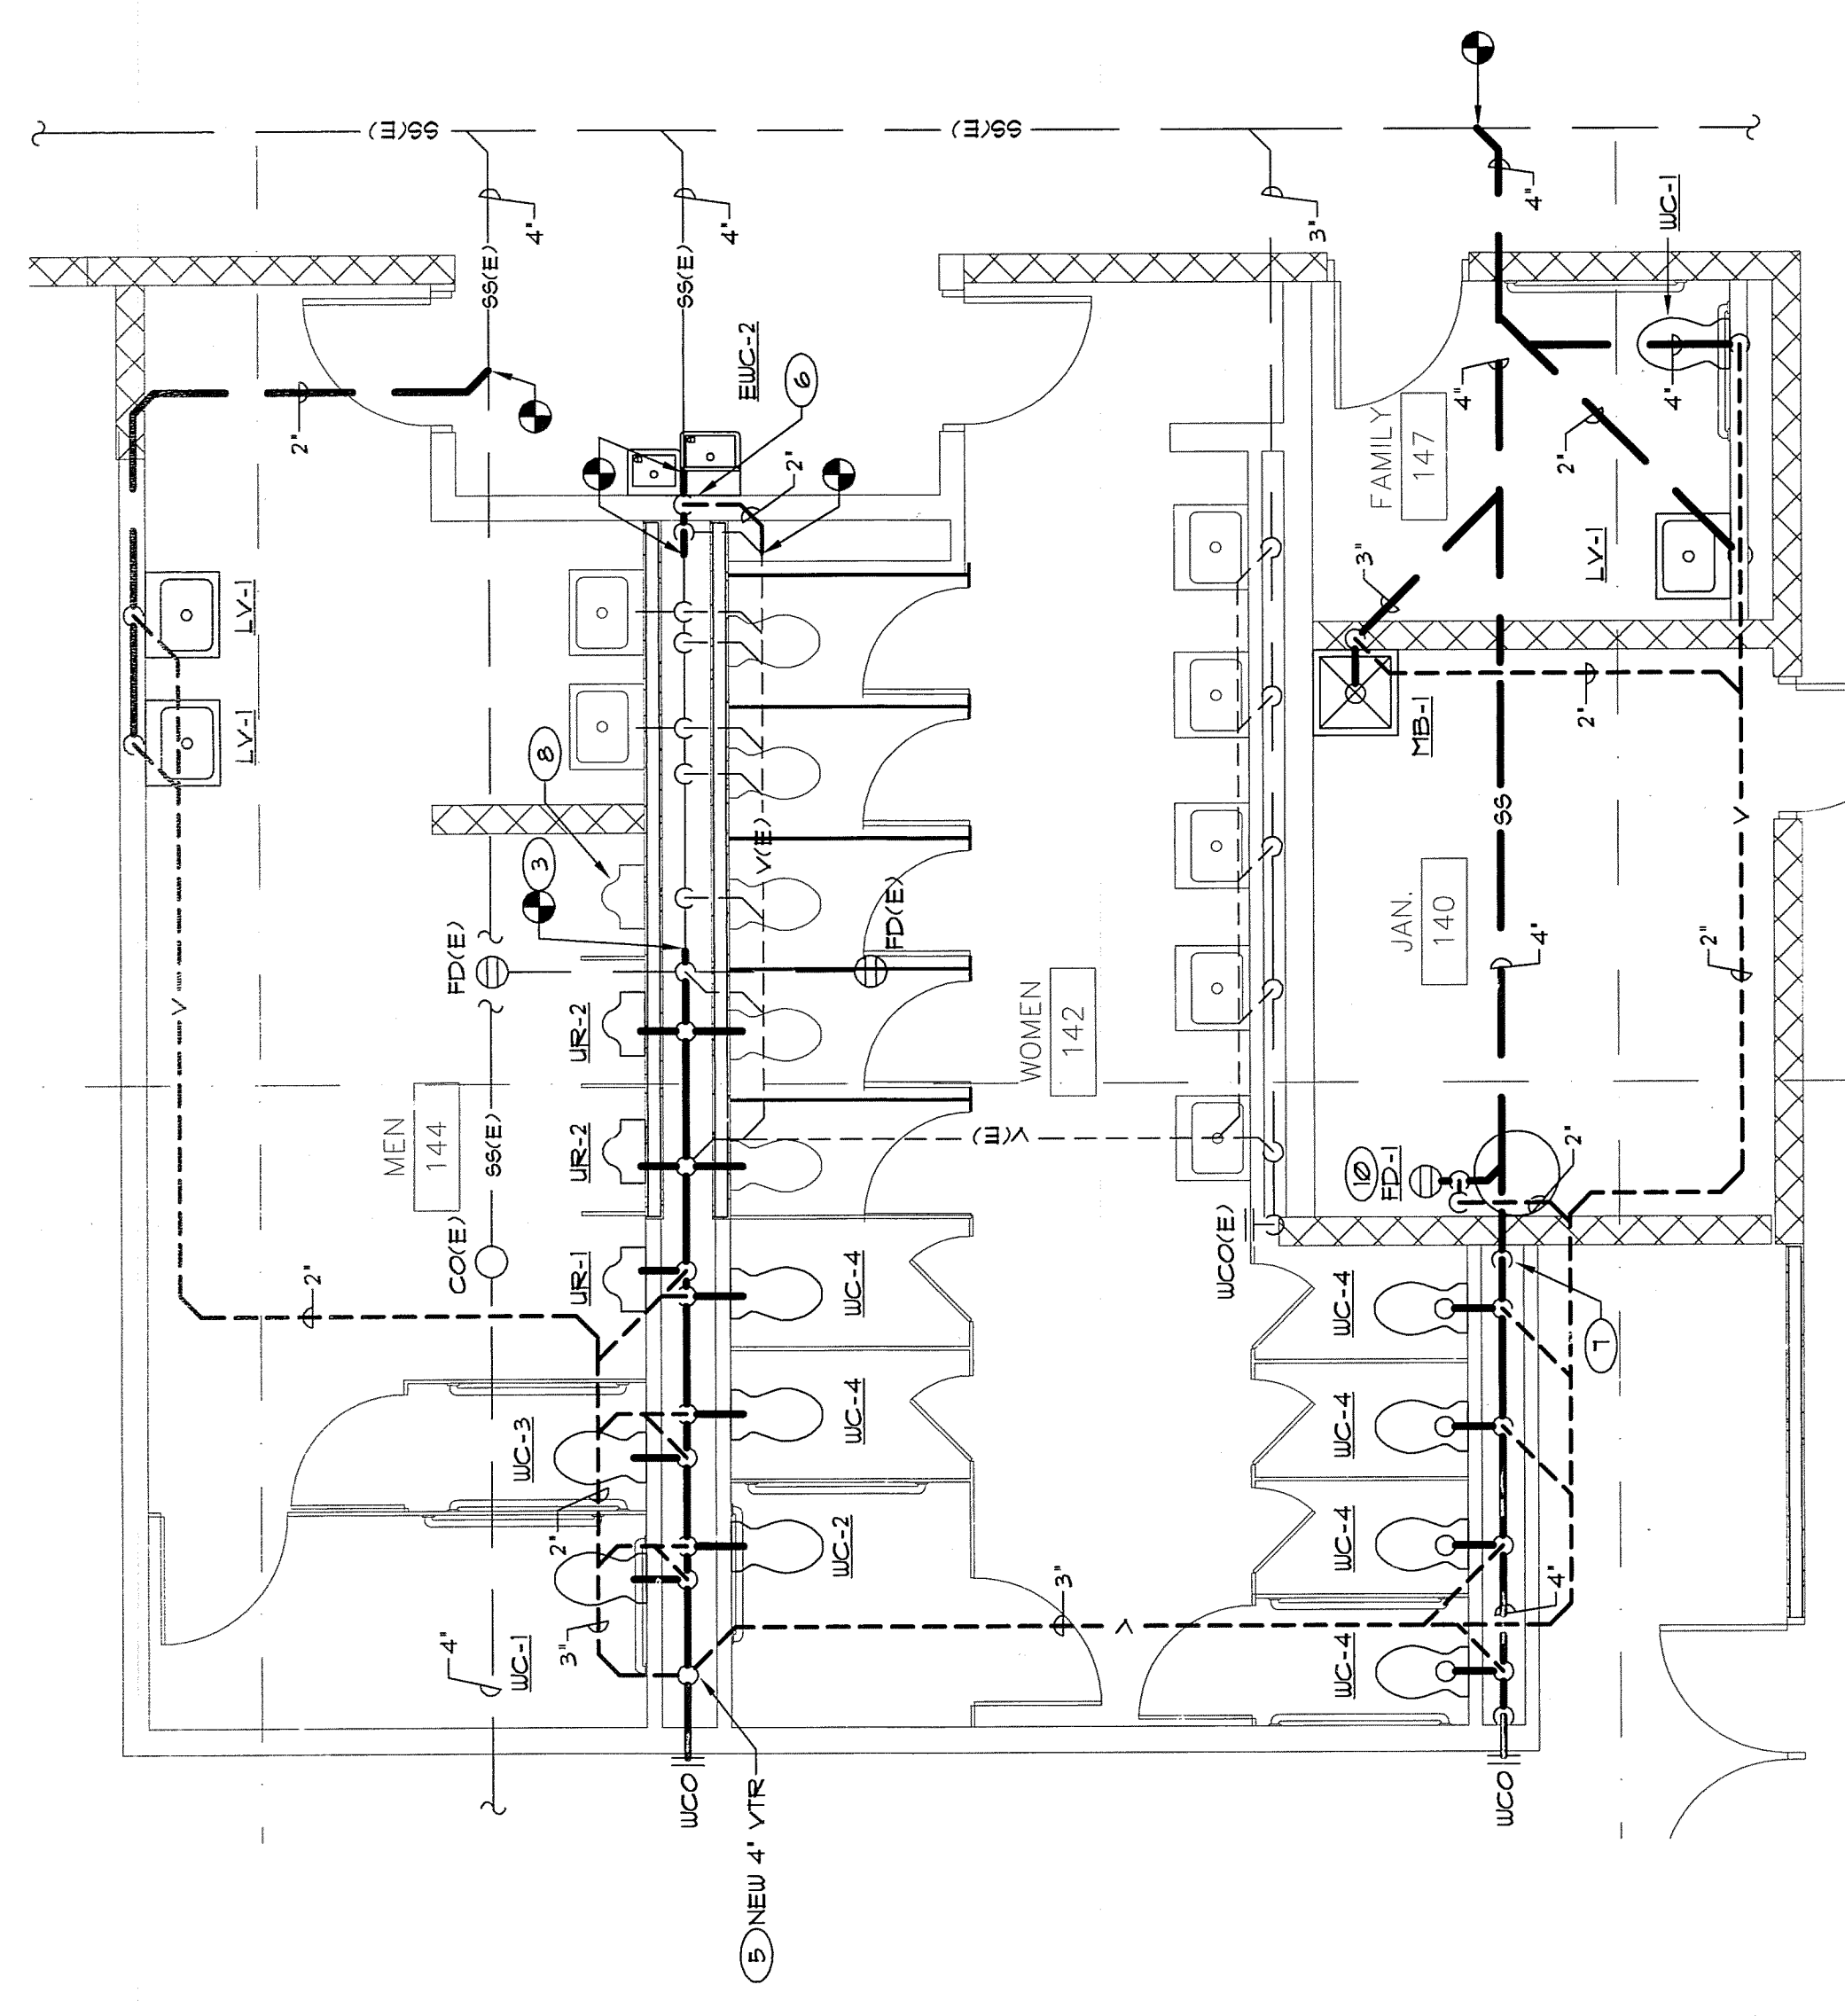


1  
ENLARGED PLAN - WASTE/VENT  
SCALE: 1/4" = 1'-0"

2  
ENLARGED PLAN - WATER  
SCALE: 1/4" = 1'-0"


5  
ENLARGED PLAN - PLUMBING DEMO  
SCALE: 1/4" = 1'-0"

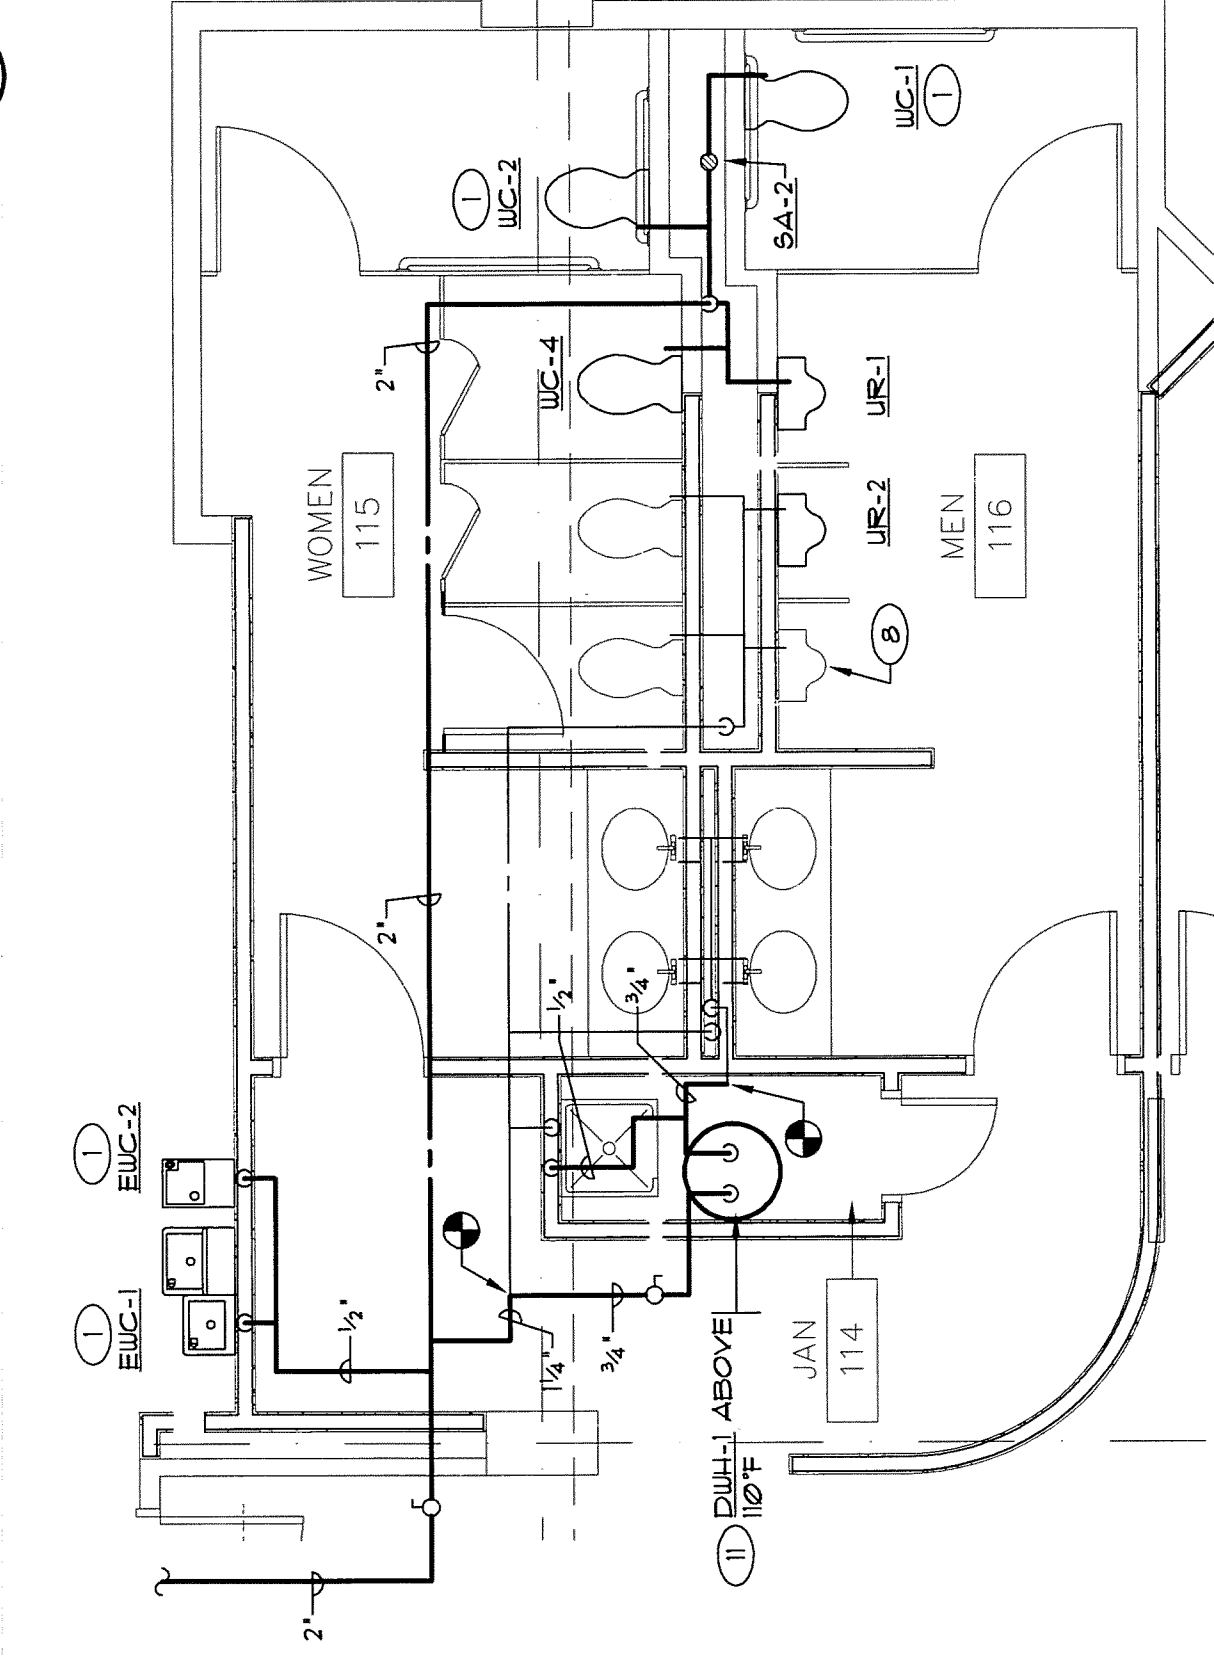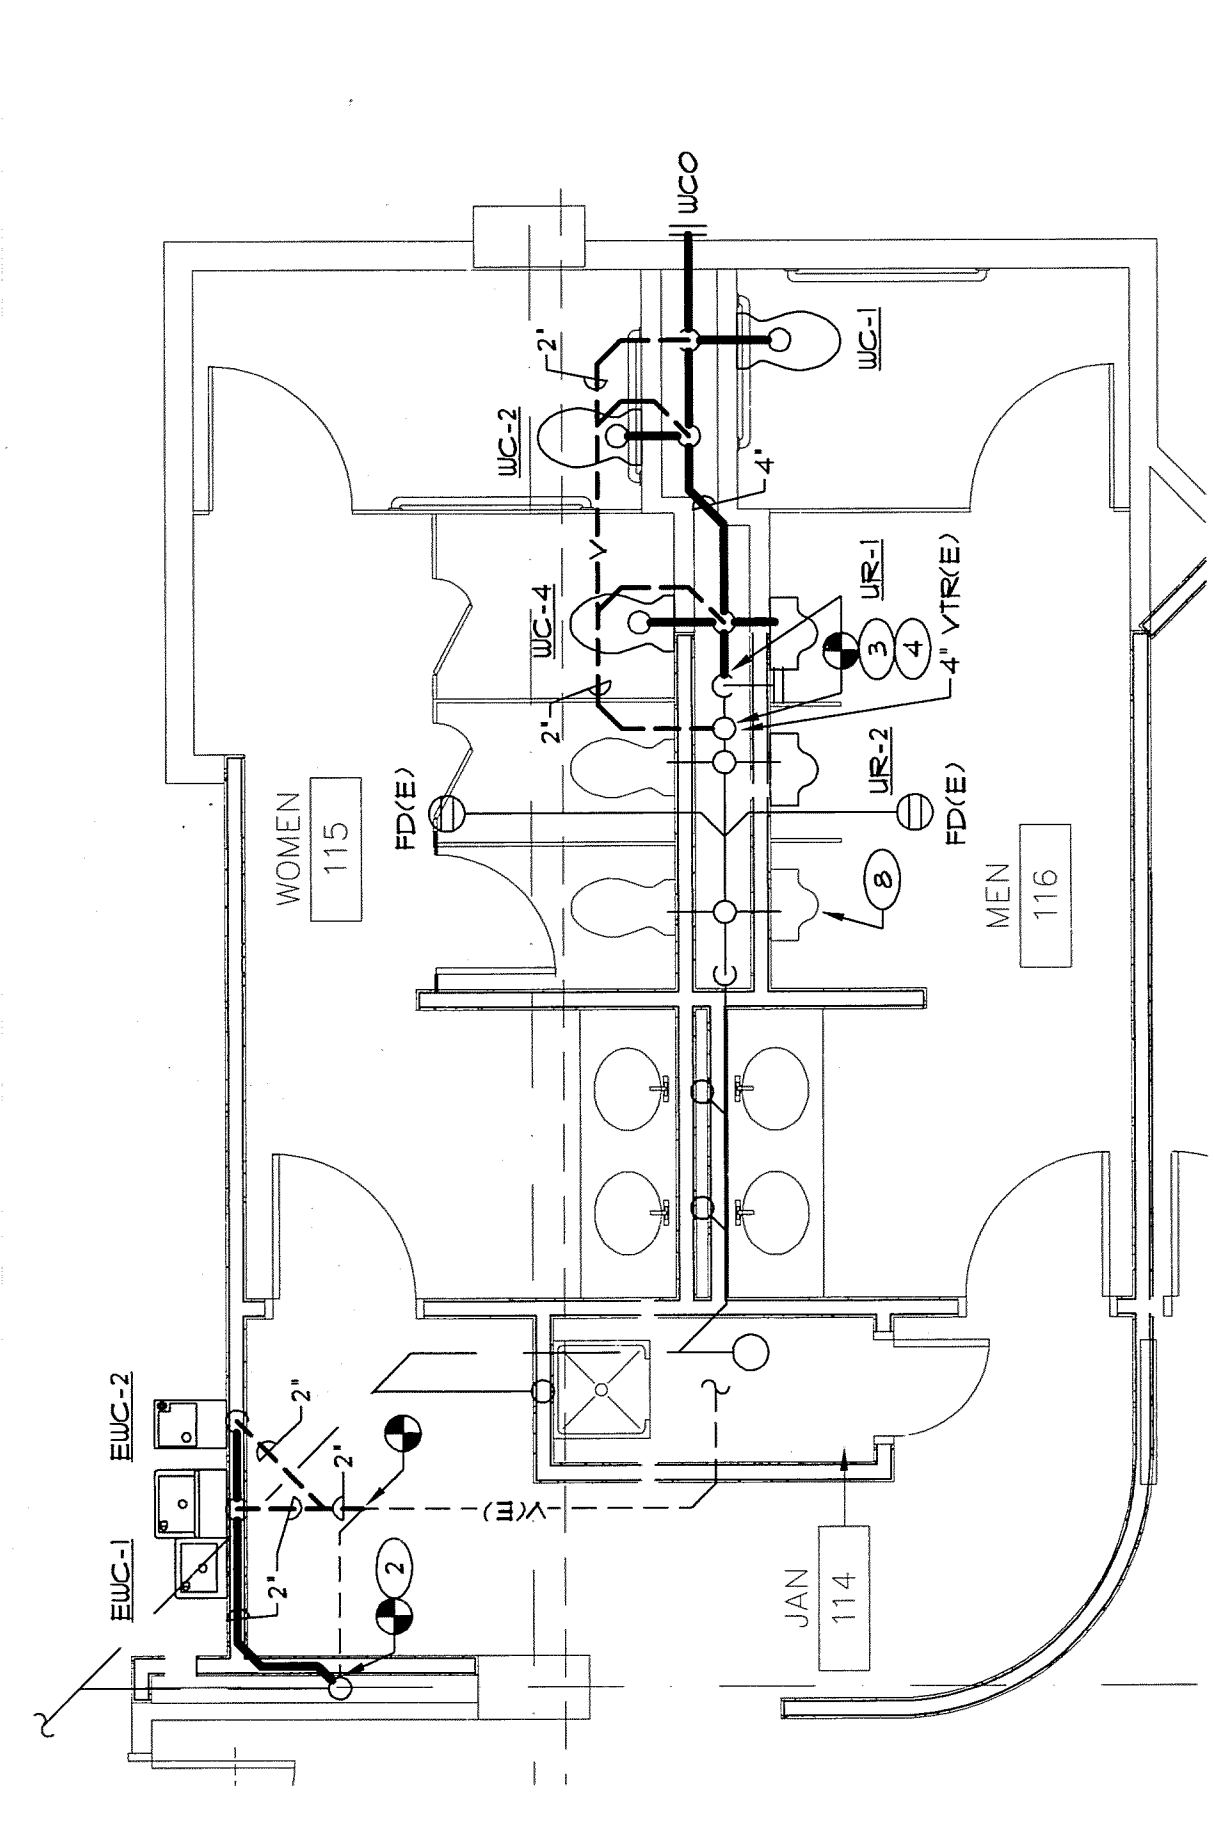

4  
ENLARGED PLAN - WATER  
SCALE: 1/4" = 1'-0"

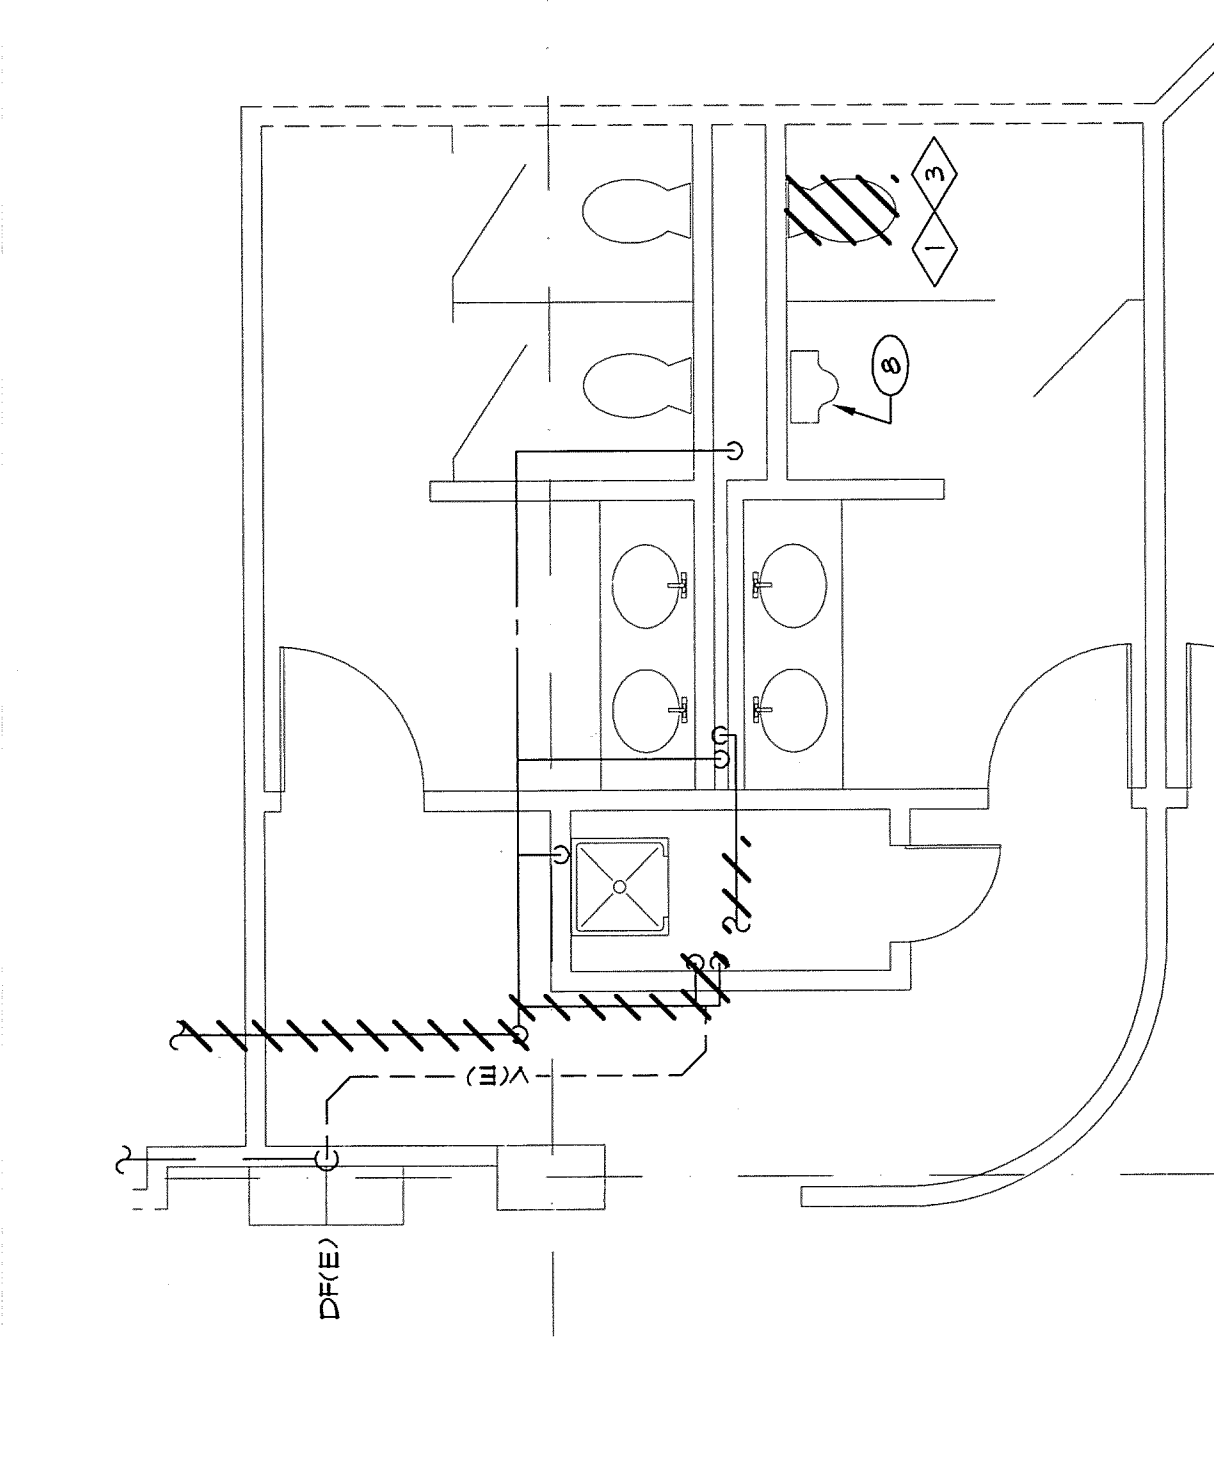

6  
ENLARGED PLAN - PLUMBING DEMO  
SCALE: 1/4" = 1'-0"

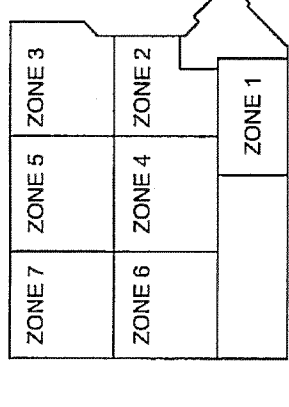


KEY PLAN SHOWS LIGHTING CONTROL ZONES 1-7.  
EXPO HALLSPEAKERS SHALL BE WIRED AS TWO CHANNELS:  
CHANNEL 1: ZONES 1-3  
CHANNEL 2: ZONES 4-7  
All 8-in speakers shall be tied to nearest channel; 300W max per channel.

**KEY PLAN - CONTROL ZONES**  
NO SCALE

**LIGHTING CONTROL SCHEME**  
EXPO HALL WILL BE CONTROLLED IN SEVEN ZONES. EACH ZONE HAS THREE SWITCHES TO INDIVIDUALLY CONTROL EACH OF THREE BALLASTS IN EACH TYPE A/E FIXTURE PROVIDING 4 LEVELS OF LIGHT CONTROL. (SWITCH ON 1 LAMP, 2-4 FULL 5 LAMPS WITHIN THE ZONE).  
SPECIAL CONTROL: SWITCHES WILL CONTROL ONE 2-LAMP BALLAST IN ALL FIXTURES ALONG THE MAIN HALL (along column line C).  
FIXTURES NOTED 'N' SHALL HAVE TYPE L LAMP BALLAST WIRE FOR CONTINUOUS OPERATION AS A SECURITY NIGHT LIGHT. FINAL FIXTURES WIRE FOR NIGHT LIGHT SHALL BE COORDINATED WITH OWNER.  
OCCUPANCY SENSORS IN RESTROOMS, OFFICES AND OTHER LOCATIONS AS NOTED SHALL CONTROL FIXTURES. SEE 28 27 26.

**GENERAL NOTES / SCOPE NOTES:**  
1. ALL LIGHTING CIRCUITS SHALL BE TERMINATED TO SWITCHED BUS WITHIN PANELS A ON 5' TO MEET EFC ALL O.C.T. CODE REQUIREMENT.  
2. PROVIDE EXPO HALL POINT CALC PER FIXTURE SCHEDULE BASED ON: 1.5' HALLWAY, 1.5' OFFICE, 0.91 LIT AND 1.175 FT (AVE) OF 16'-0" AFF FOR TYPE A/E FIXTURES.

**KEYED NOTES:**  
1. EXISTING LIGHTING TO REMAIN. FIELD VERIFY & MAINTAIN HOMERUN(S) SERVING THESE AREAS FROM LOCAL 277V LUG PANEL (PANEL A OR B). RE-TERMINATE HOMERUN TO BREAKER IN REPLACEMENT PANEL.  
2. DEMO EXISTING DAMAGED WALL PACK AND REPLACE WITH TYPE S2 WALL PACK. RECONNECT TO ORIGINAL O.C.T. OR SHOWER (F10WVG).  
3. ADD TYPE S2 WALL PACK. CORE DRILL EXTERIOR WITH WATERPROOF SEAL. CONNECT VIA O.C.T. INDICATED. CONDUIT ROUTED ON INTERIOR.  
4. RE-CIRCUIT J-BOX FOR SECURITY LIGHTING (247). SEE PNL SCHED EXT.  
5. COMMISSION EXTERIOR LIGHTING CONTROLS. TIME CLOCK, PHOTO CELL. SEE SITE PLAN FOR SITE LIGHTING WORK.  
6. CONNECT EACH ZONE OF LIGHTS TO PANEL VIA LOCAL LIGHT SWITCH BANK PER LIGHTING CONTROL SCHEME NOTED ABOVE. PROVIDE LABEL THAT DENOTES ZONE AND LAMP(S) CONTROLLED FOR EA SW. SWITCHES SHALL BE INSTALLED IN THE MAIN HALL (along column line C).  
7. DEMO AND REPLACE EXISTING ASTRONOMICAL TIME CLOCK AND PROVIDE 4-POLE MECHHELD LIGHTING CONTACTOR (LC). COMMISSION WIRE EX 3-POLE LC FOR SECURITY LIGHTS AND ADD 4-POLE FOR REMAINING S1 POLE L.T.S. 54 FLOORS. 55 POLE L.T.S. & PYLON SIGN.  
8. HALL LIGHT SW. CONNECT DN LIGHTS AND ONE 2-LAMP BALLAST IN TYPE A FIXTURES ALONG THE MAIN HALL TO THIS O.C.T. LABEL COVER AS HALL LIT.  
9. REINSTALL EXISTING 24 FIXTURES IN THIS ROOM. CONNECT ONLY ONE OF TWO 2-LAMP BALLASTS. LENS FRAME WILL NOT BE REINSTALLED.  
10. PA SOUND SYSTEM HEADEND RACK. SEE POWER PLAN & SPECS. COORDINATE FINAL LAYOUT OF EQUIP ON THIS WALL WITH OWNER.  
11. EXISTING 3-POLE LIGHTING CONTACTOR LC-1. PROVIDE LC-2 PER SITE PLAN AND PANEL SCHEDULE EXT.  
12. DEMO EX 12-IN DOWN LIGHT AND REPLACE WITH FIXTURE INDICATED. RECONNECT TO EXISTING O.C.T. EXT-1; PATCH SOFFIT TO MATCH. OPTION: REPAIR EXISTING NUMBER VAPOR FIXTURE IF POSSIBLE.

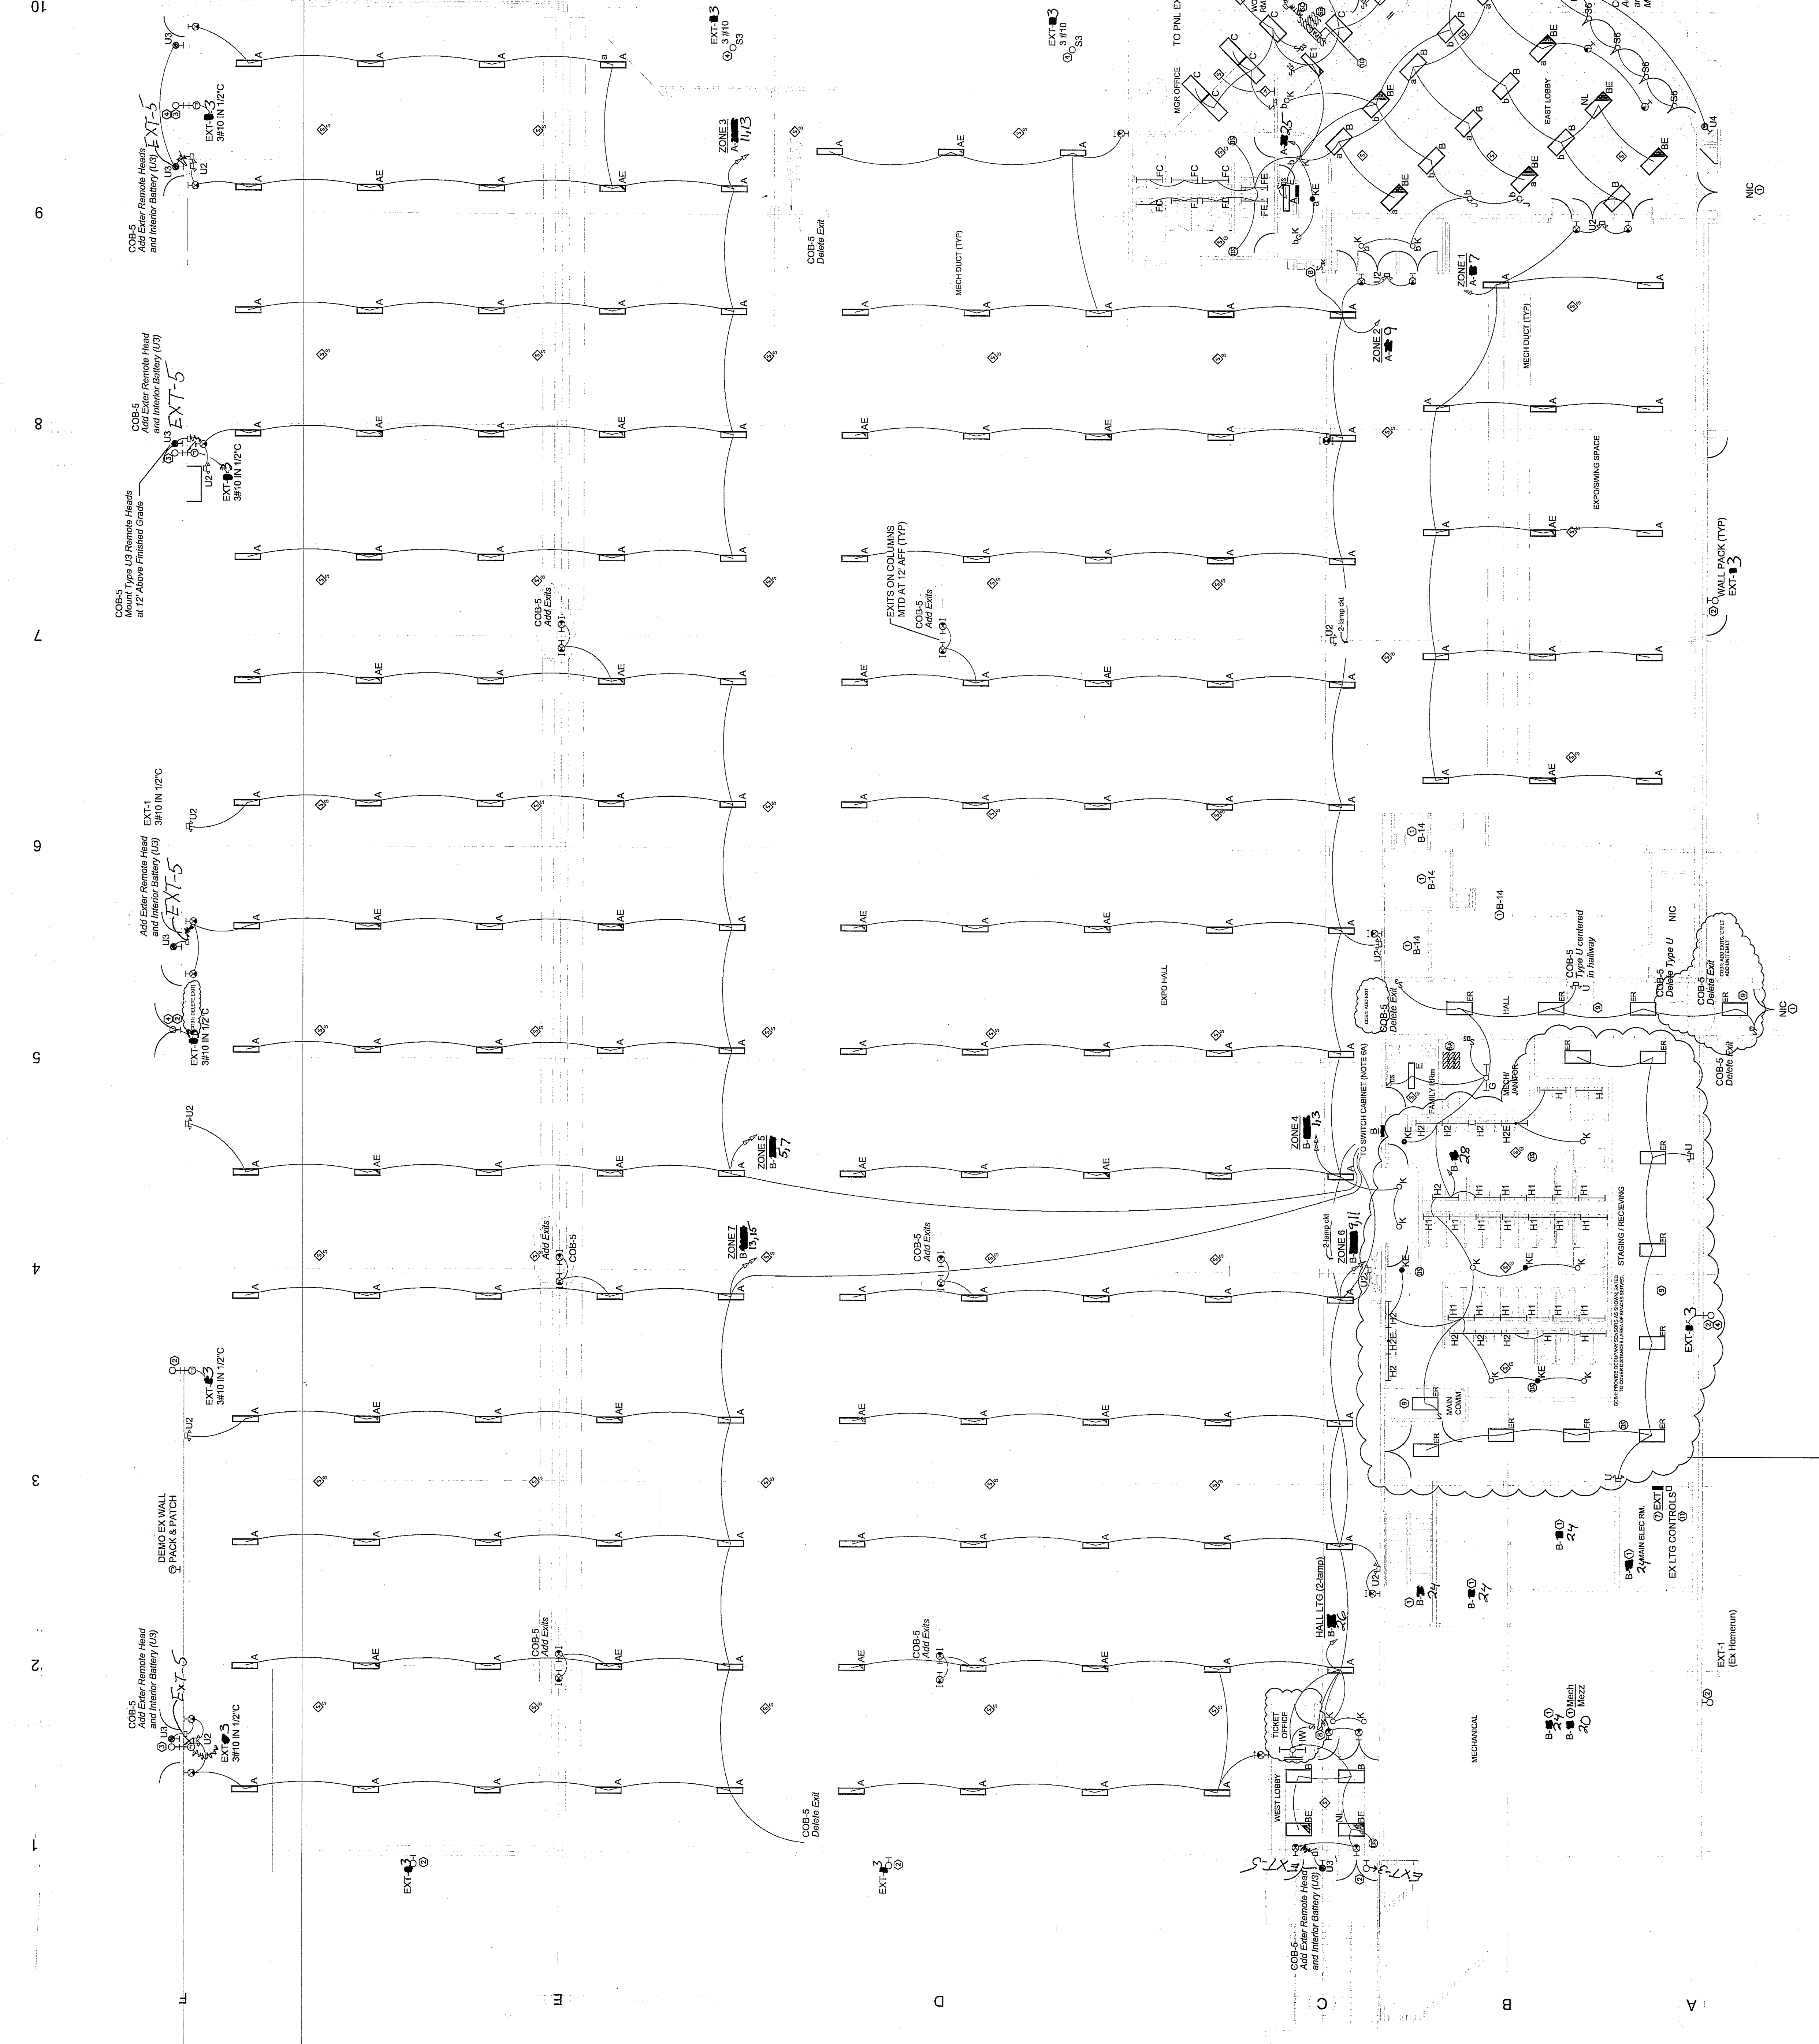

**FLOOR PLAN - LIGHTING**  
SCALE: 3/32" = 1'-0"

REVISIONS

001	MAIN RESTROOM REVISIONS & MISC EGRESS LTR
002	ADD GEC AND SYSTEM, REVISE POWER CART FRMS & DROPS

- GENERAL NOTES:**
- POWER CARTS ARE EXISTING.
  - ALL EXISTING RECEP SHALL BE REPLACED UNDER THIS WORK. PROVIDE BLANK COVERS/PLATES FOR UNUSED J-BOXES IN EXISTING DUPLEX RECEP ON COLUMNS ARE EX TO REMAIN W/RE TO PANEL C.
  - VOICE DATA, SECURITY EQUIP AND ALL DEVICES WIRING BY OWNER. INCLUDE OUTLET ROUGHINS AS INDICATED.
  - TELEPHONE SYSTEM SHALL BE PROVIDED BY OWNER.
  - PROVIDE A PA SYSTEM. SEE SPECIFICATION.
  - SEC SHALL BE PROVIDED BY OWNER. PROVIDE ROUGH-IN FOR KEY PAD AT EAST AND WEST ENTRY DOORS. (KPI) THE CONTROL PANEL WILL BE LOCATED IN THE SOUTH HALLS; AND LV CABLING WILL POWER DEVICES LOCATED IN THE DUP HALL (NORTH HALLS).
  - VERIFY LOCATIONS OF AC PANELS WITH OWNER PRIOR TO ROUGH-IN. AND WORKROOM LAYOUT PRIOR TO ROUGH-IN.

- KEYED NOTES:**
- PROVIDE BREAKERS AND FUSES IN EX GEAR PER ONE-LINE SCHEDULES.
  - PROVIDE PANEL AND CONNECT PER ONE-LINE & ASSOC PNL SCHEDULE.
  - INCLUDE WORK REQUIRED TO PROVIDE COMM SERVICE FROM COMCAST DEMO EX COMM EQUIPMENT ONLY AS REQD TO INSTALL EQUIPMENT PER OWNERS IT / VOICE DATA PROVIDER.
  - EXTEND EX 208V FEEDERS INTO PULLBOX INSTALLED AT STRUCTURE. SEE ONE-LINE (PREVIOUSLY SERVED 208V BUS DUCT FROM MOP).
  - PROVIDE POWER FOR DATA RACK AND PHONE SYSTEM. INCLUDE GND, FLYWOOD BACKBOARD ACROSS ADREN WALL. COORD LAYOUT WITH PER OWNERS IT / VOICE DATA PROVIDER. PROVIDE ISO GND TYPE RECEPTACLES WHERE REQUESTED BY IT.
  - POWER CONDUITS SHALL BE INSTALLED AT EACH END OF EACH SERVICE CORD WITH HELMING AT EACH END NOMINA AND LABEL PNL-SLEEVE INDUSTRIAL RECEP TO MATCH PWR CART. SEE SPEC 28.27B. PROVIDE 50 FT 3/4" X 3/4" GND CORD WITH 100A RECEPTACLE. INCLUDE CORD HANGER SUPPORTS PER SPEC 28.05.00.
  - INSTALL BUS DUCT PER ONE-LINE. TIGHT TO STRUCTURE. INSTALL AND FUSE EX 100A PLUG-IN DISC SWITCHES TO SERVE POWER CART DROPS. ROUTE A FEEDER FROM PLUG-IN DISC TO EACH POWER CART DROPS. 3 # 3/4" X 3/4" GND IN 1-1/4" X 1/4" X 3/4" DISC WITH 100A BK (TYP OF 6) OUT STARTER HEATERS IN MCC TO MATCH PUMP HP. (HP#25)
  - CHANGE OUT STARTER HEATERS IN MCC TO MATCH PUMP HP. (HP#25)
  - INSTALL RECEP IN EXISTING FLUSH BACKBOXES AS LKGS THIS WALL AND CIRCUIT AS SHOWN. ADD HOMERUN (CONDUITS) AS REQUIRED.
  - WIRE CONTROL STATION FURNISHED WITH DOOR. SEE SPEC 08.3B13.
  - PROVIDE POWER TO OPERATOR PER MGR AND INCLUDE WIRING OF LOW-VOLTAGE RF TRANSFORMER TO OPERATOR. (RF ACTUATORS) INCLUDE A MEANS TO DISABLE POWER FOR 5-15 MINUTES WHEN LOCKED.
  - WIRE FOOD VENDOR OUTLETS (TYP OF 5) TO EXISTING SPARE BKRS IN EXISTING FLUSH BACKBOXES. PROVIDE 100A RECEPTACLE TO VENDOR EQUIP. NOTE PNL K1 IS A 400A TWO SECTION PANEL WITH EX LOADS REMOVED UNDER PREVIOUS DEMO PHASE. ANY ABANDONED LOADS SHALL BE REMOVED UNDER THIS PHASE. ALL BE CUT OFF 4' ABOVE THE TOP OF THE EXISTING WALL AND CAIRED.
  - PROVIDE ROUGH-IN WITH 400A 1P 2W SECURITY DIRECT WIRE FOR SECURITY KEY-PAD. COORD BACKBOX WITH SECURITY CONTRACTOR.
  - RE-CONNECT RECEP TO EX CKT SHOWN. REMOVE ABANDONED WIRE IN EXISTING CONDUIT. ORIGINAL CMT SERVING OUTLET IS DISHONED (O-X).
  - CONNECT 3#12 VIA 3002 NF DISC TO UNIT. LOCATE DISC IN LOS TO UNIT.

- REVISIONS:**
- REVISED-  
REVISED-

- REVISIONS:**
- REVISED-  
REVISED-


- REVISIONS:**
- REVISED-  
REVISED-

- REVISIONS:**
- REVISED-  
REVISED-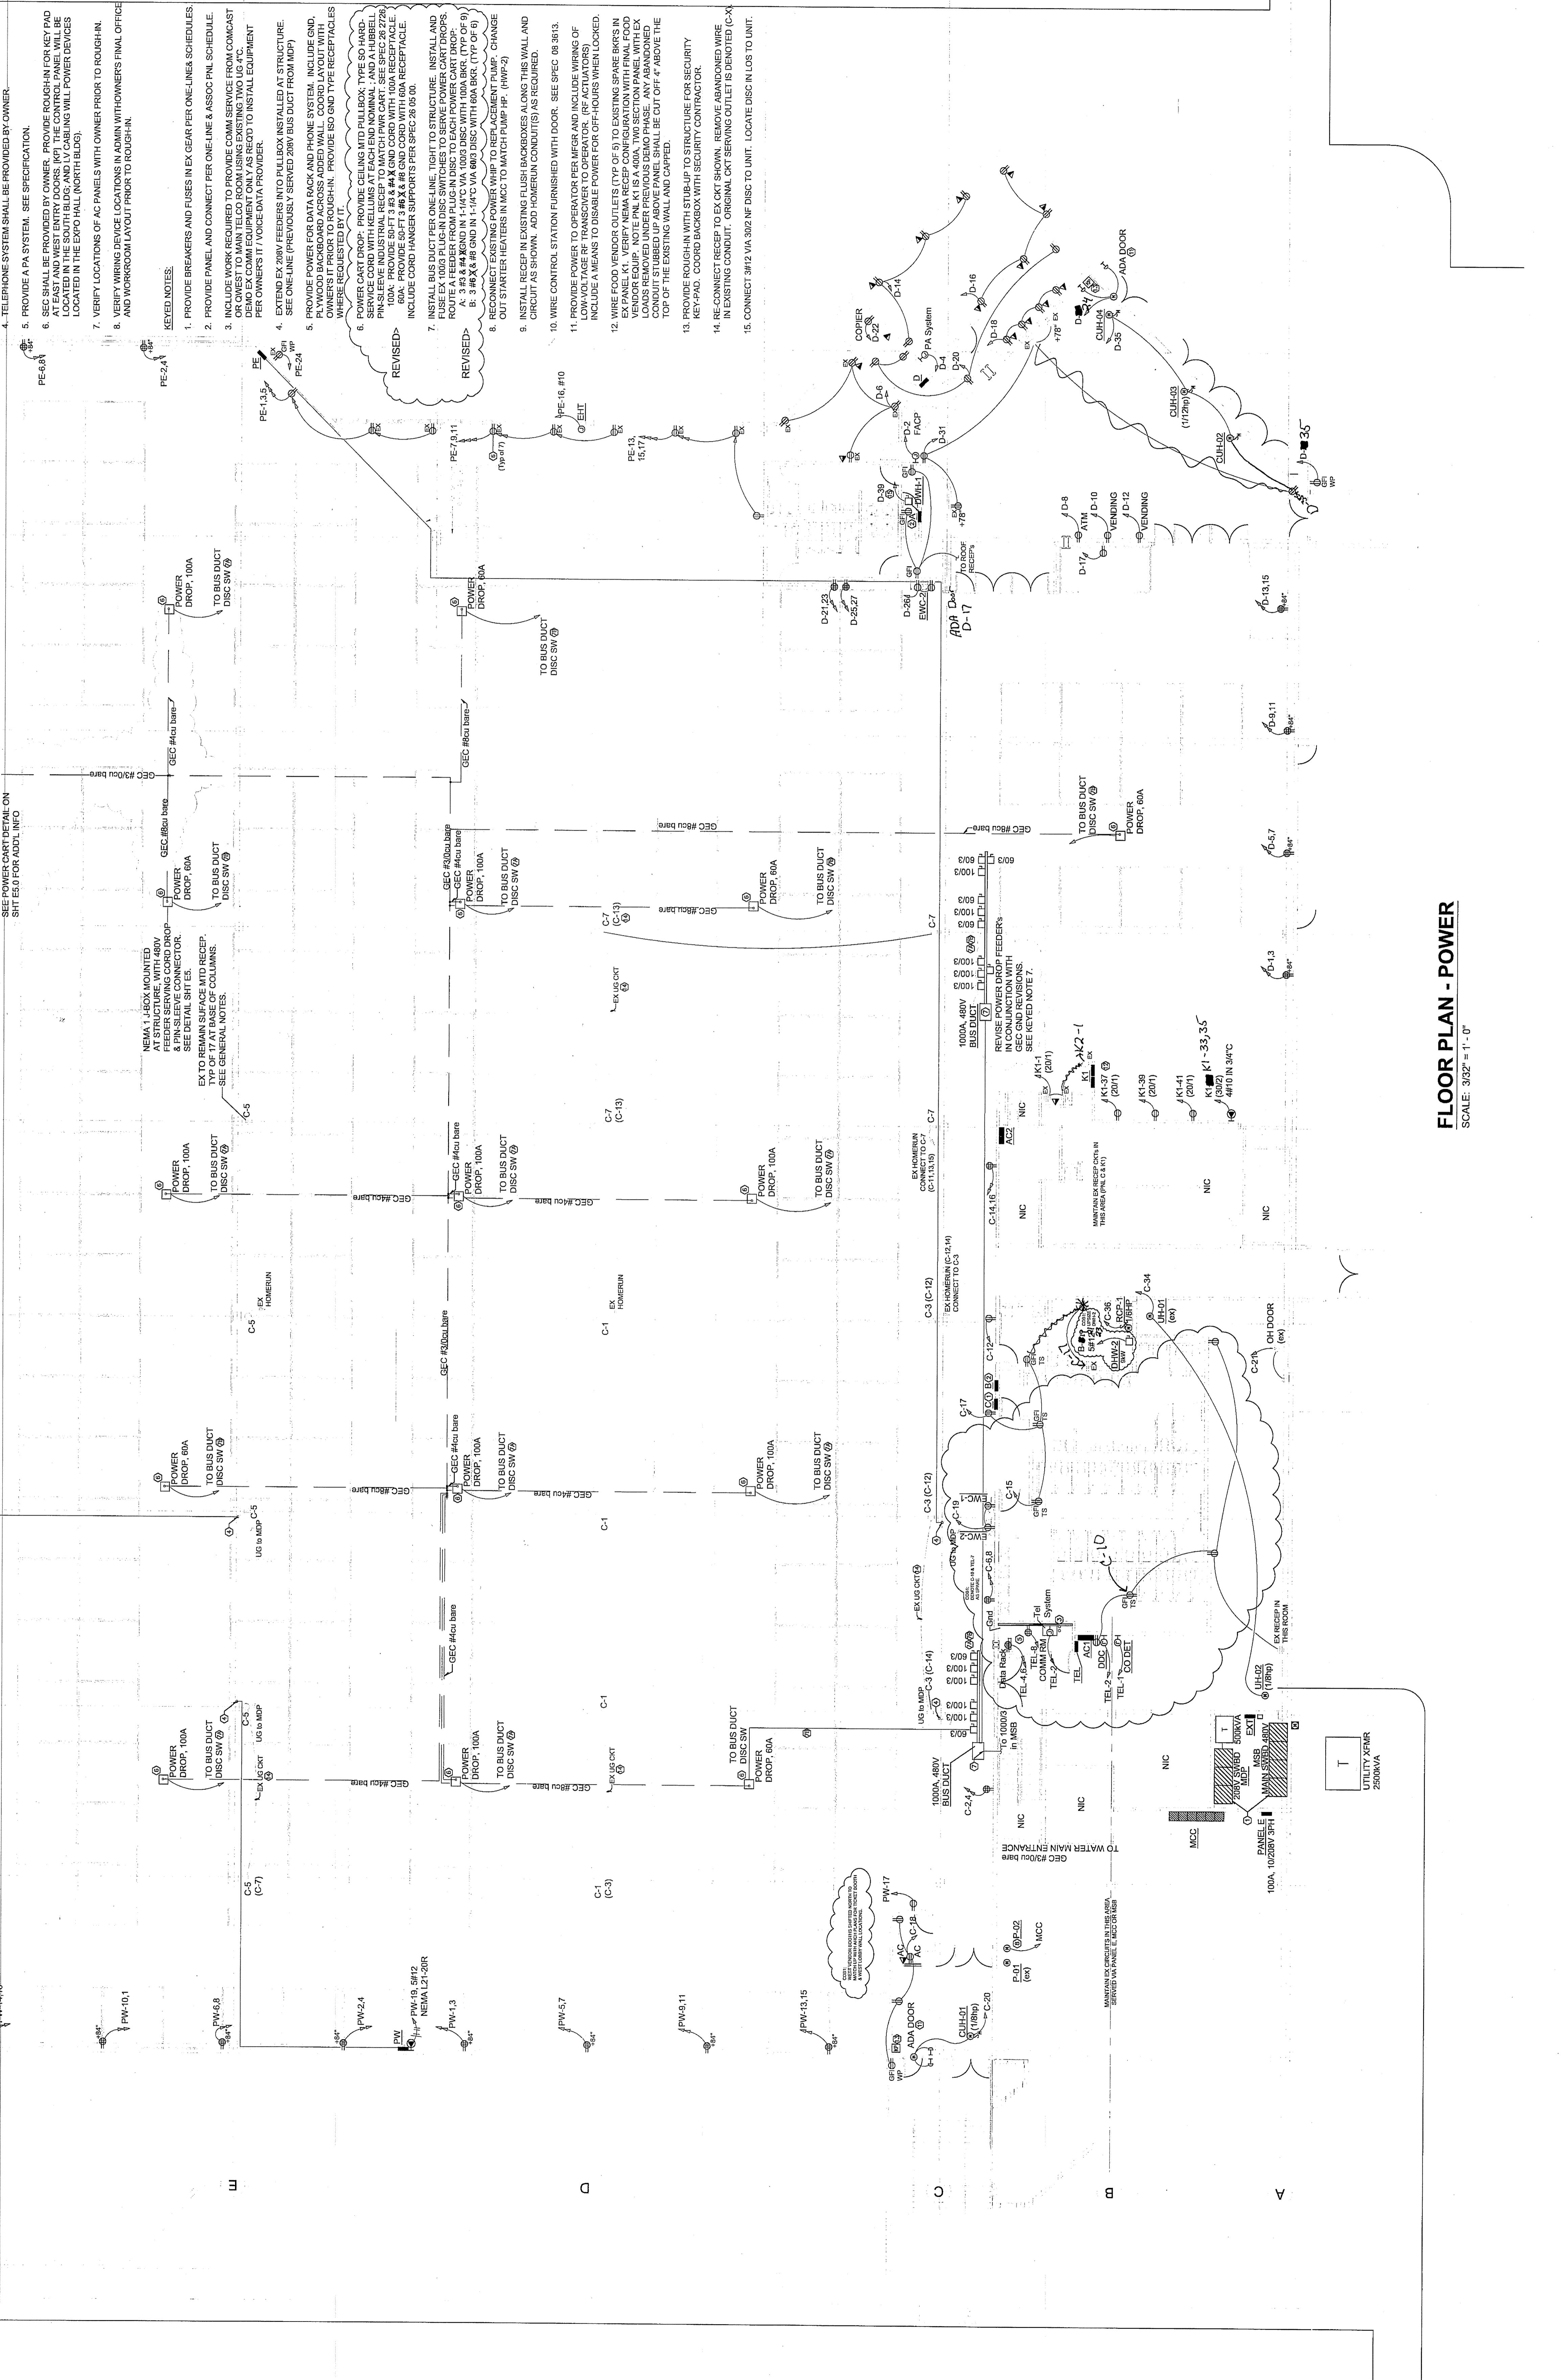

**FLOOR PLAN - POWER**  
SCALE: 3/32" = 1'-0"

REVISIONS

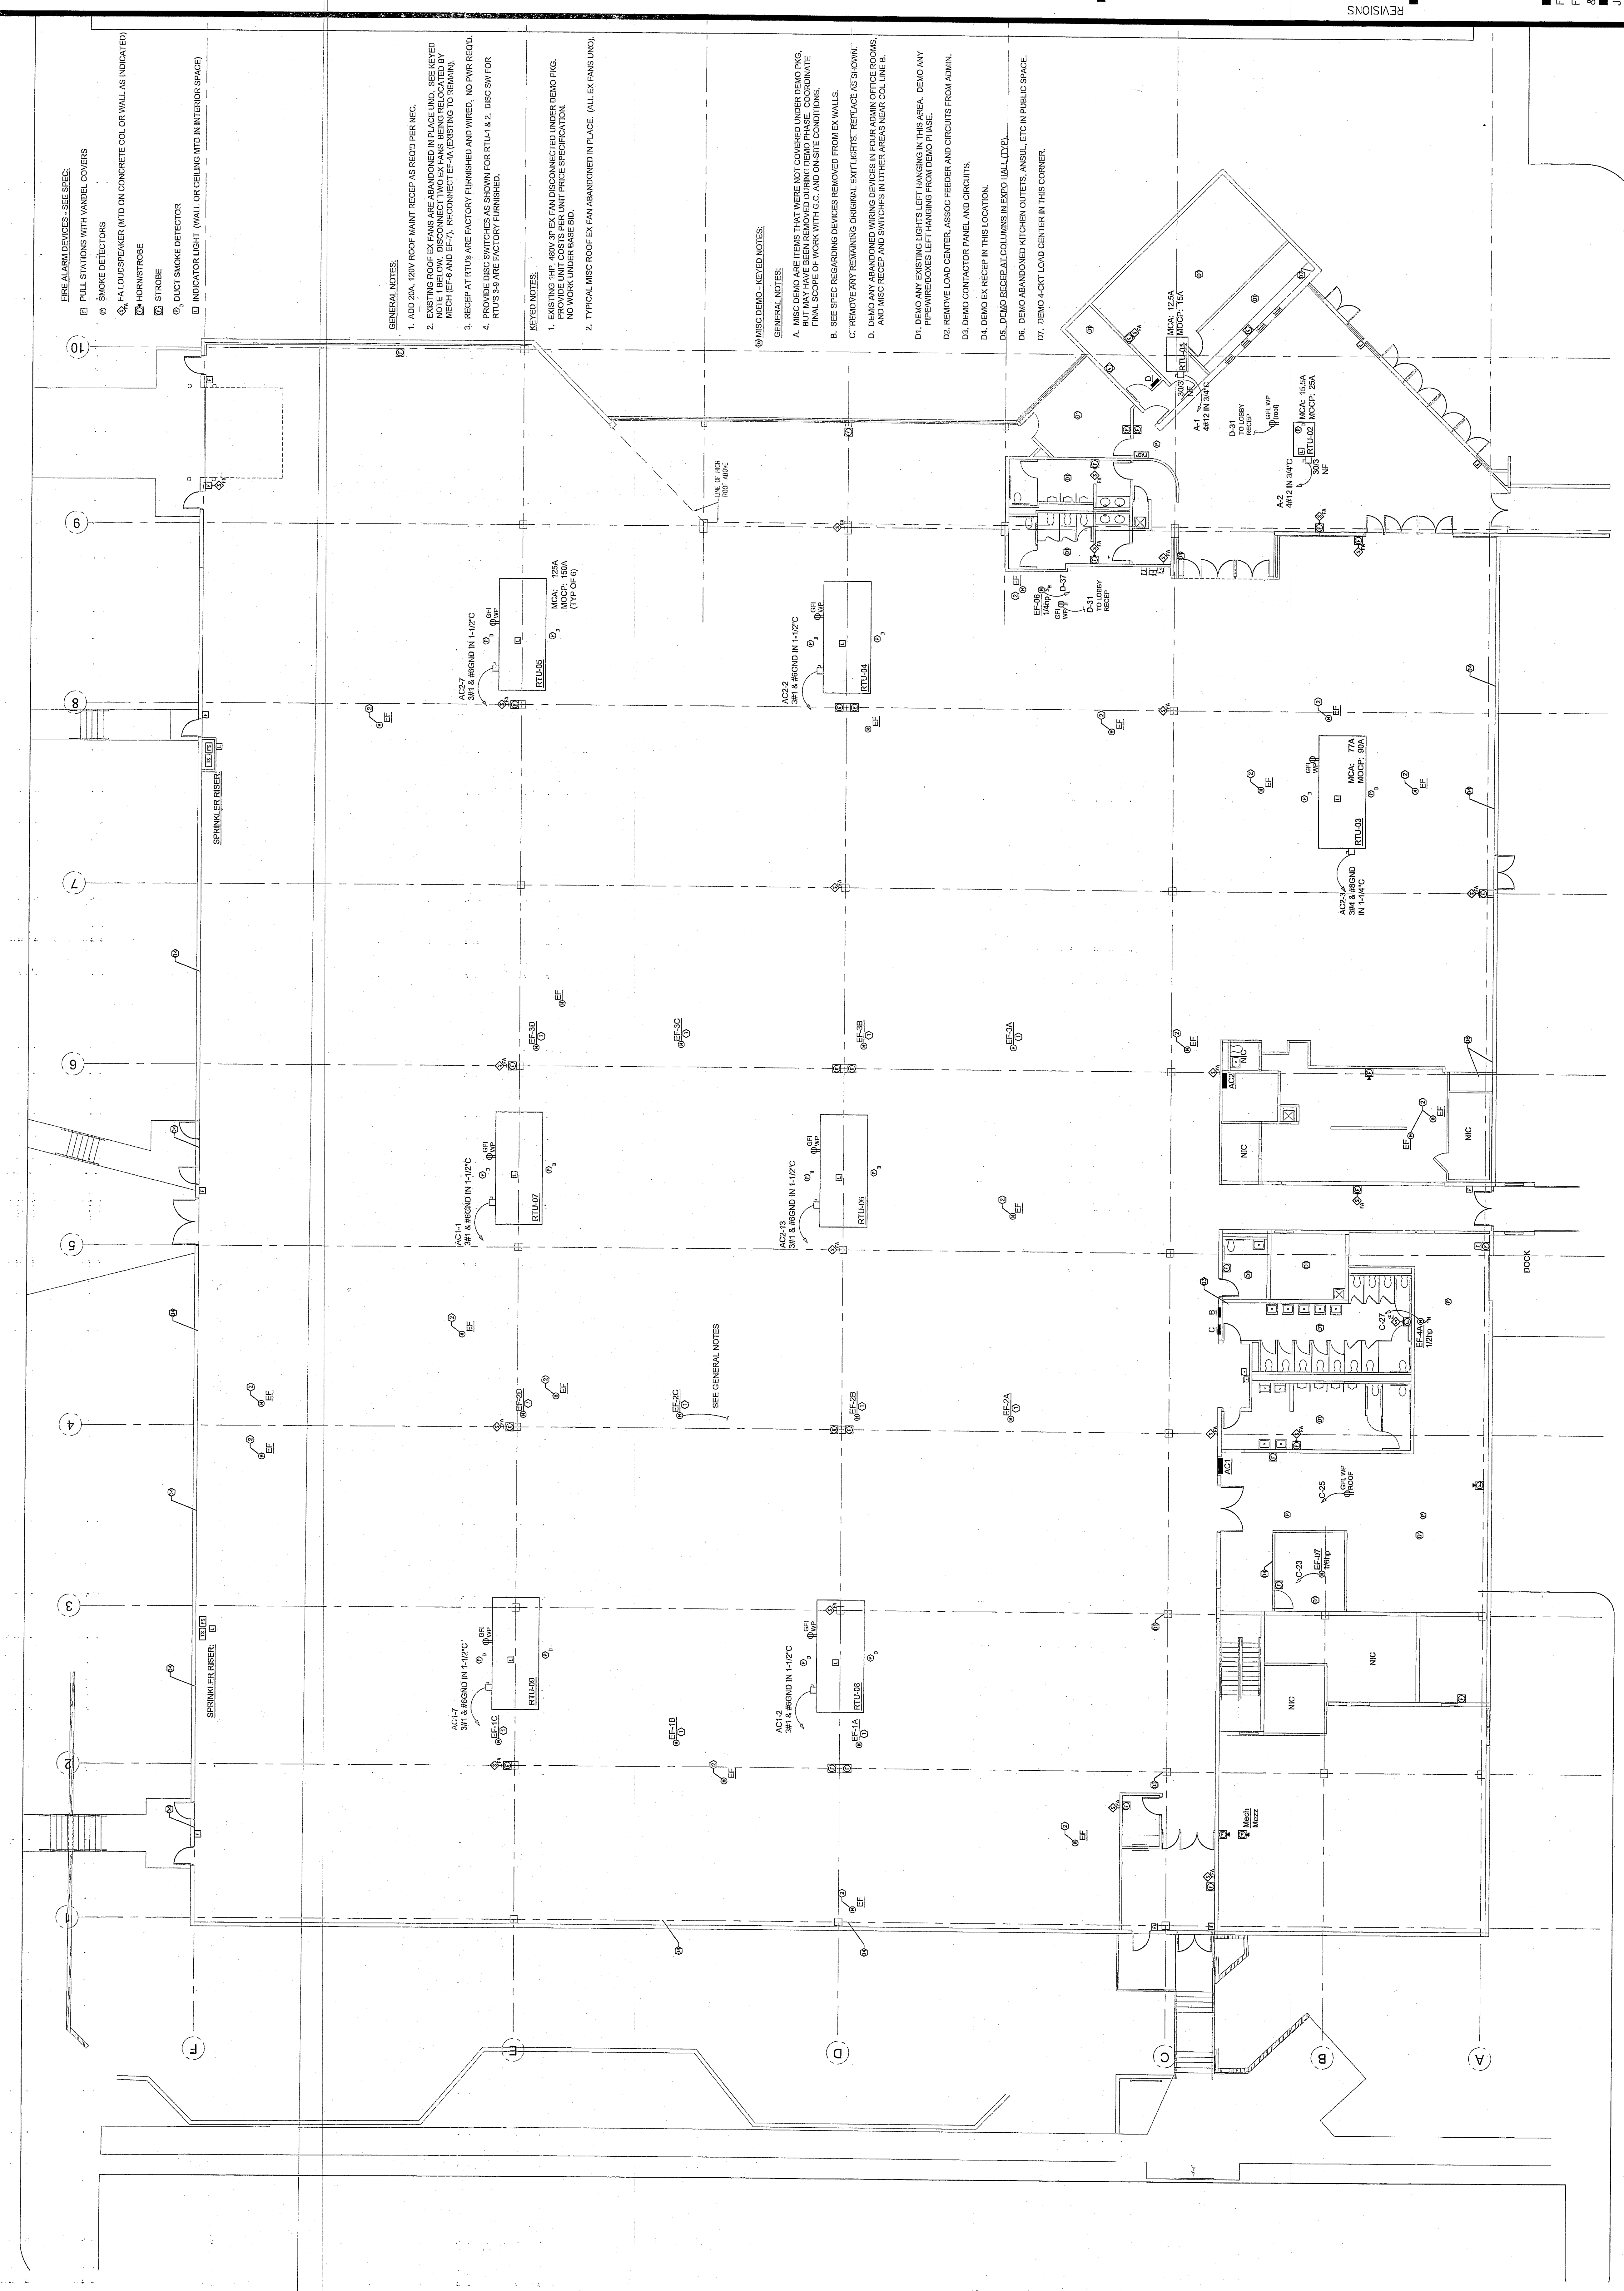**FLOOR PLAN - FA & ROOF EQUIP**  
SCALE: 3/32" = 1'-0"



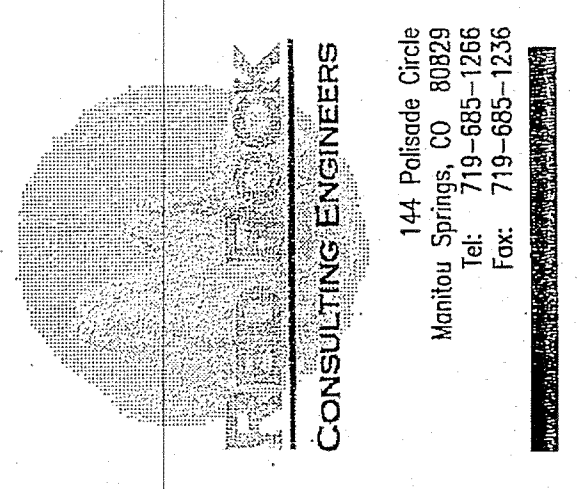


144 Palmdale Circle  
 Monument, CO 80132  
 P: 719.553.1235  
 F: 719.553.1236

NORTH NEVADA EXPO  
 3650 NORTH NEVADA AVE. BUILDING RENOVATION  
 COLORADO SPRINGS, CO

NO.	DESCRIPTION
1	REVISIONS

SITE PLAN ELECTRICAL
JOB NO.: 1002210
DATE: 06/03/11
SCALE: AS NOTED
DRAWN: CAD
CHECKED: JBT
E4.00
SHEET

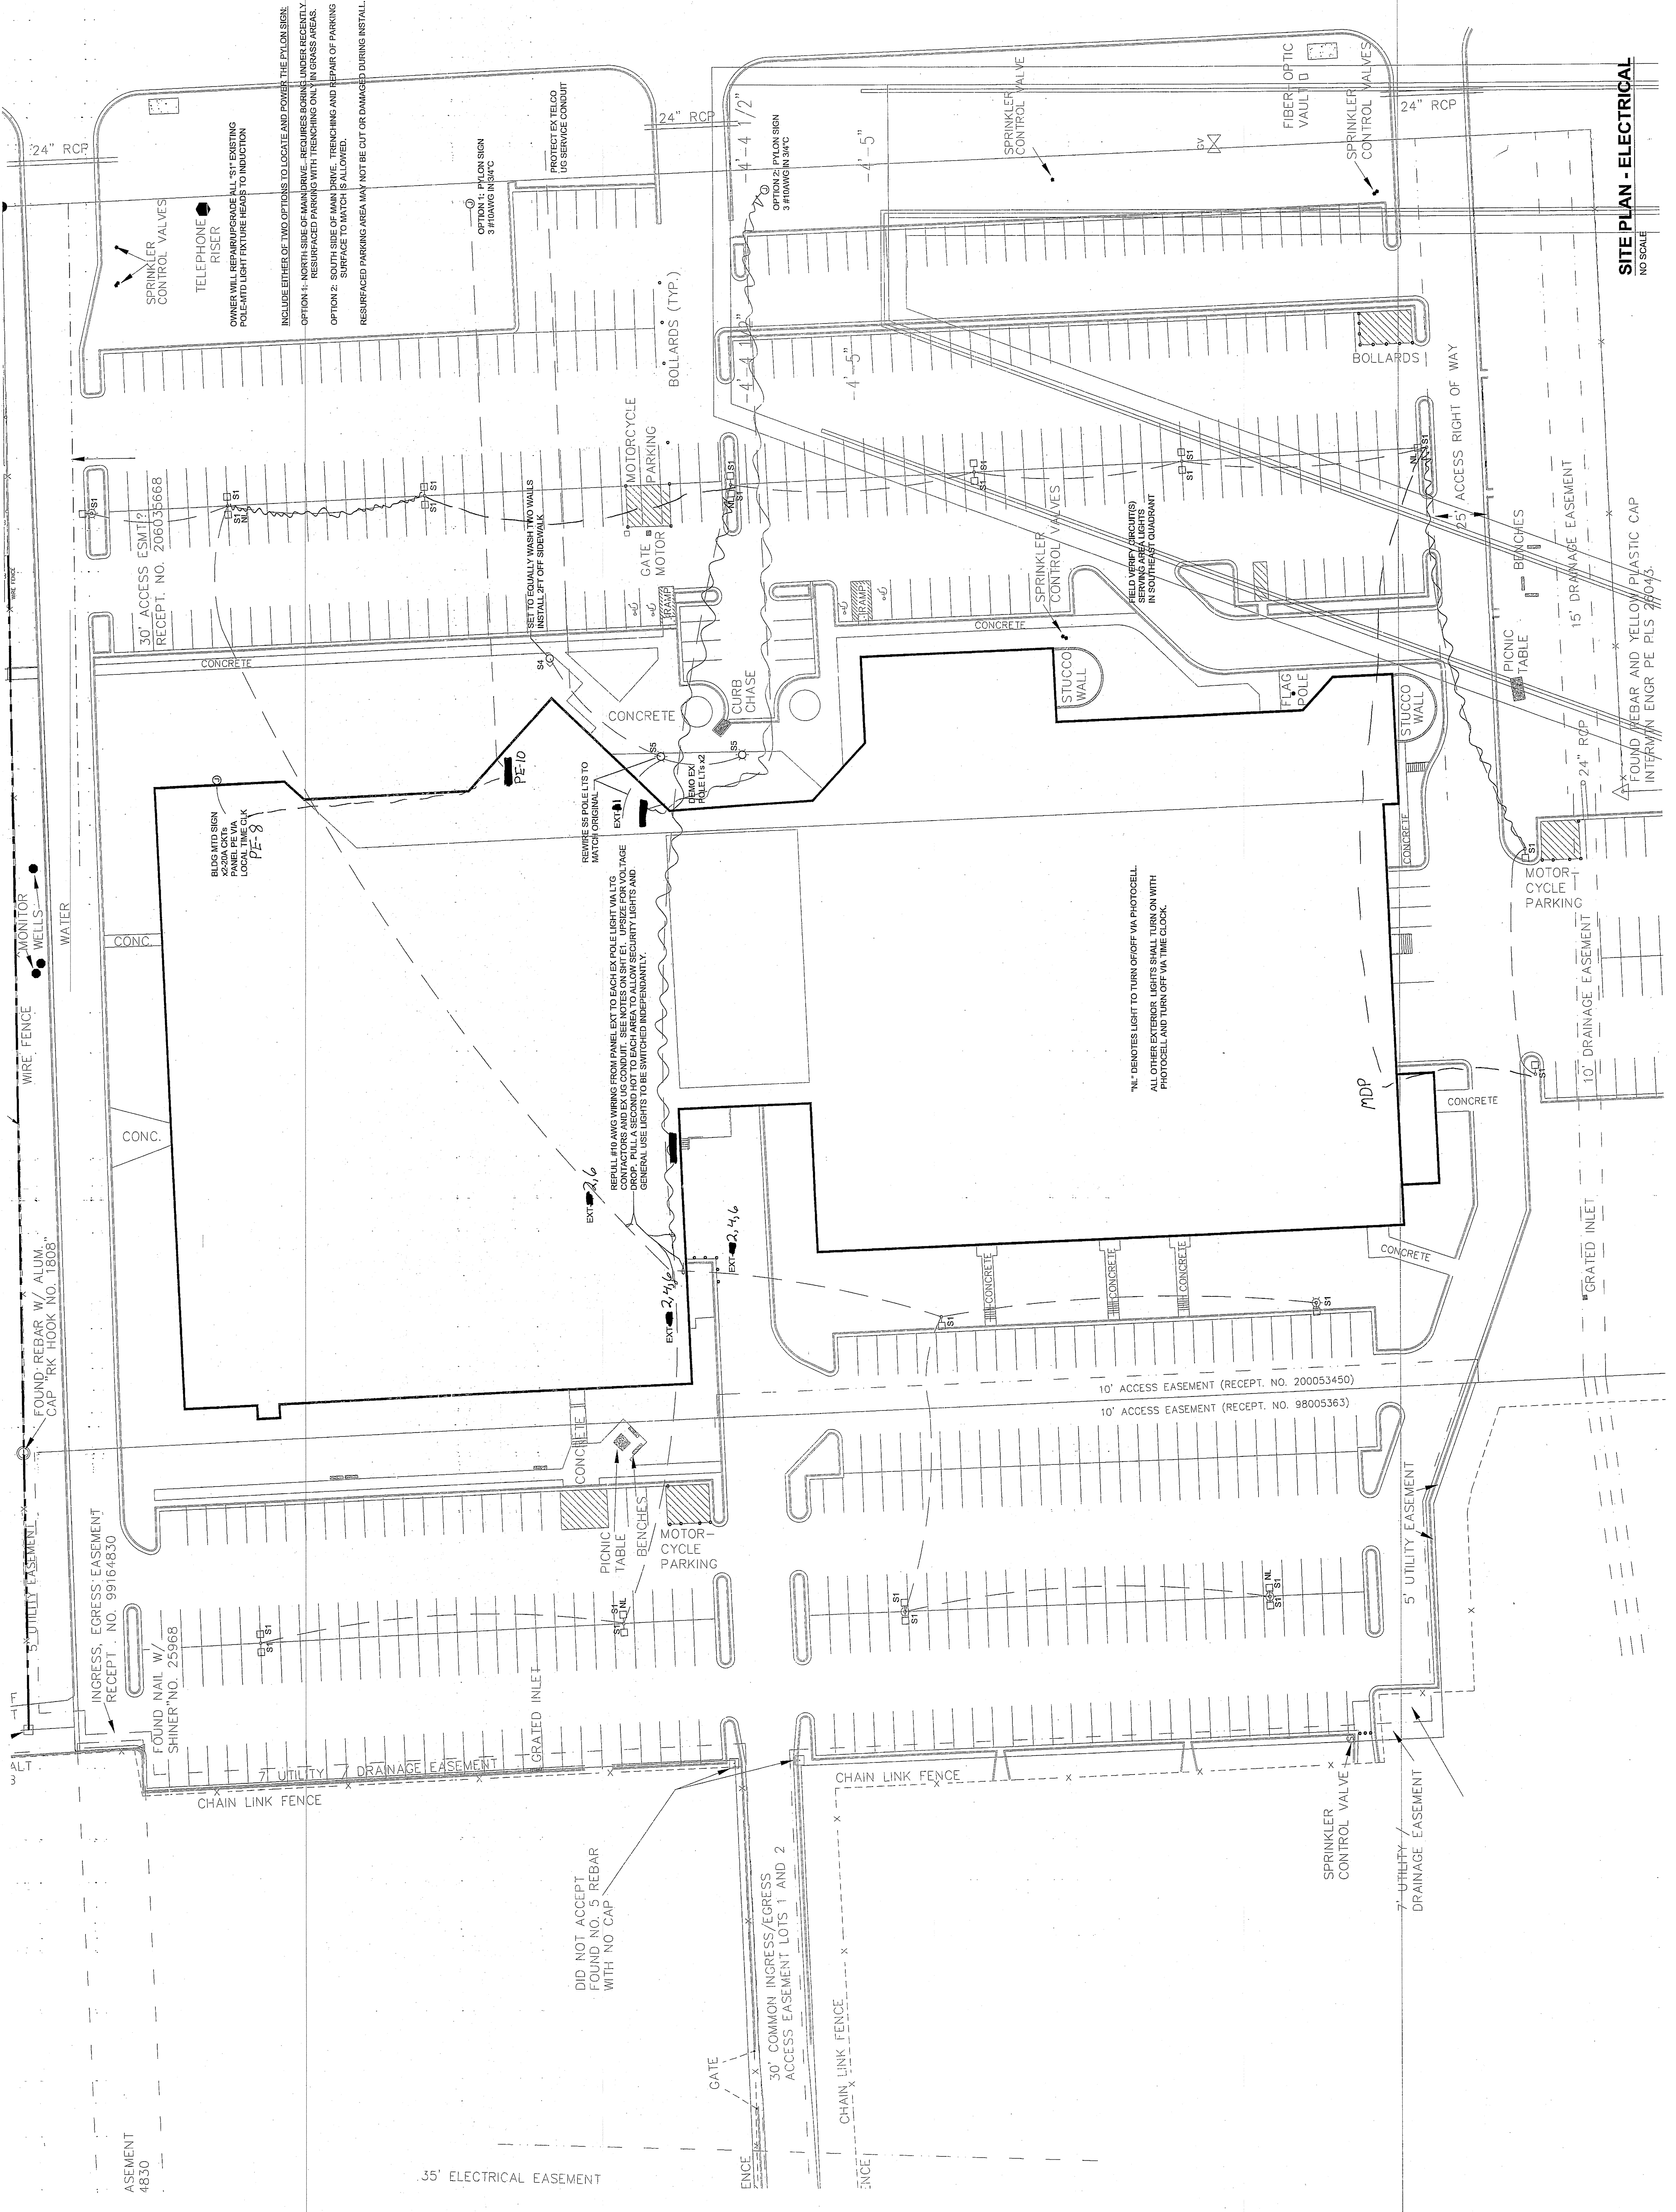

INCLUDE EITHER OF TWO OPTIONS TO LOCATE AND POWER THE Pylon SIGN.  
 OPTION 1: NORTH SIDE OF MAIN DRIVE. REQUIRES POWER UNDER RECENTLY RESURFACED PARKING WITH TRENCHING ONLY IN GRASS AREAS.  
 OPTION 2: SOUTH SIDE OF MAIN DRIVE. TRENCHING AND REPAIR OF PARKING SURFACE TO MATCH IS ALLOWED.  
 RESURFACED PARKING AREA MAY NOT BE CUT OR DAMAGED DURING INSTALL.

"M" DENOTES LIGHT TO TURN OFF VIA PHOTOCELL.  
 ALL OTHER EXTERIOR LIGHTS SHALL TURN ON WITH PHOTOCELL AND TURN OFF VIA TIME CLOCK.

DID NOT ACCEPT FOUND NO. 5 REBAR WITH NO CAP

30' COMMON INGRESS/EGRESS ACCESS EASEMENT LOTS 1 AND 2


SITE PLAN - ELECTRICAL  
 NO SCALE

EASEMENT 4630

35' ELECTRICAL EASEMENT





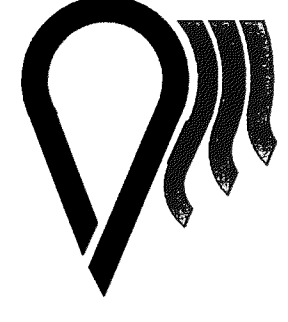

#	DATE	BY	DESCRIPTION
1	9/28/2011	CH	AS BUILT
2	7/18/2011	CH	FOR CONSTRUCTION
3	7/18/2011	CH	FOR APPROVAL

SYMBOL	DESCRIPTION	REPLACE MODEL OR SSP
1/8"	1/8" PIPE	
1/2"	1/2" PIPE	
3/4"	3/4" PIPE	
1"	1" PIPE	
1 1/2"	1 1/2" PIPE	
2"	2" PIPE	
2 1/2"	2 1/2" PIPE	
3"	3" PIPE	
3 1/2"	3 1/2" PIPE	
4"	4" PIPE	
5"	5" PIPE	
6"	6" PIPE	
8"	8" PIPE	


REPLACE MODEL OR SSP  
REPLACE MODEL OR SSP  
REPLACE MODEL OR SSP



SCALE 1/8"=1'-0"  
SCALE 1/4"=1'-0"

DRAWING FILE NAME: AS2465.DWG
DRAWN BY: CH
SCALE: 1/8"=1'-0"
PRINT DATE: 7/23/11
CONTRACT # AS2465
SHT. # FP-01

PROJECT: JCCS N. NEVADA EXPO CENTER  
3956 N. NEVADA AVE  
COLORADO SPRINGS, CO 80907  
CONTRACT WITH: BRYANN CONSTRUCTION  
7025 CAMPUS DRIVE  
COLORADO SPRINGS, CO 80920  
FIRE SPRINKLER PLAN

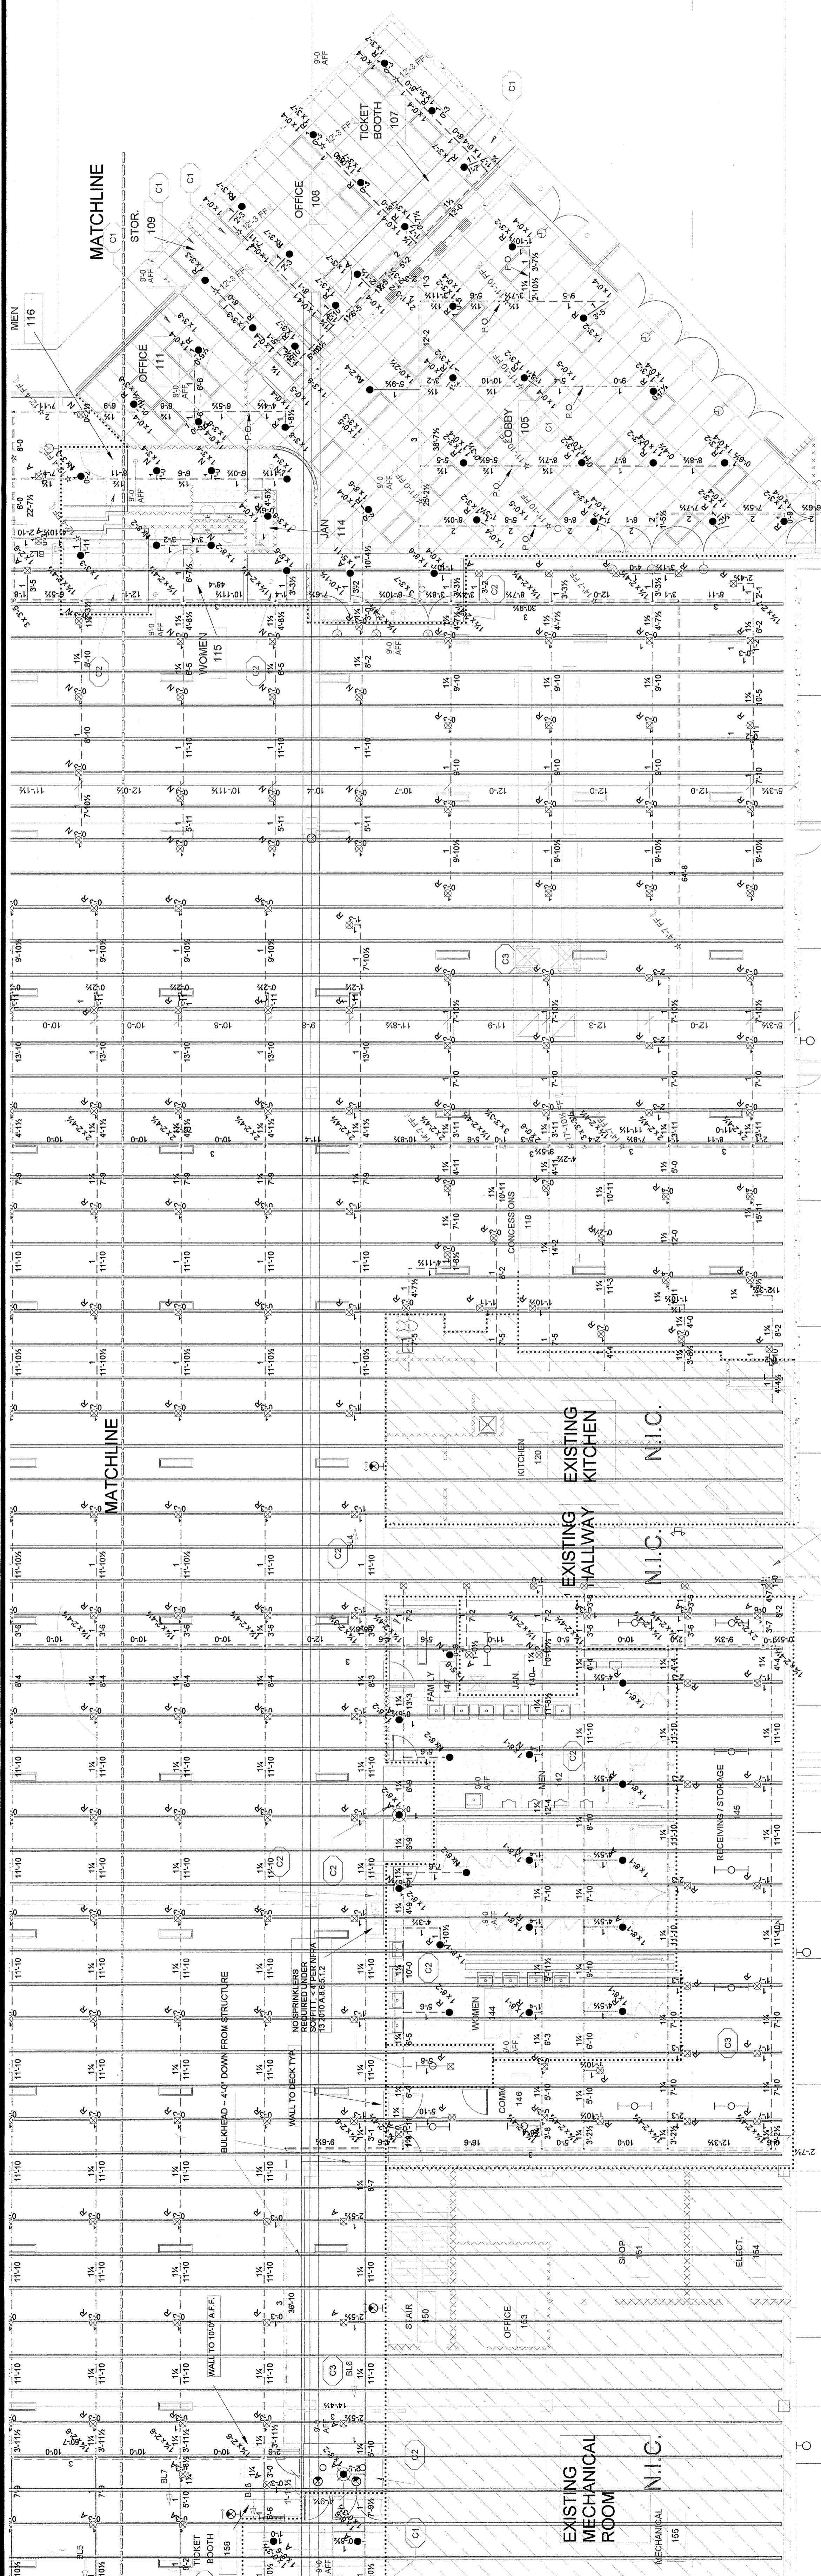

### SCOPE OF WORK








REWORK EXISTING SPRINKLER MAINS FOR TENANT FINISH. BASE MAINS TO 45'7" AFF U/L/O. AND CONVERT PENDENT SPRINKLERS TO UPRIGHT SPRINKLERS IN AREAS EXPOSED TO STRUCTURE NETWORK EXISTING PENDENT SPRINKLERS TO NEW CEILING LAYOUT.

**DESIGN CRITERIA**  
LIGHT HAZARD WORK AREA REQUIRES A DESIGN DENSITY OF 0.1 GPM/SQFT OVER 1000 SQFT. REMOVE AREA WITH 100 GPM HOSE FLOW ADDED AT HYDRAULIC SOURCE NODE  
ORDINARY GROUP 2 HAZARD WORK AREA REQUIRES A DESIGN DENSITY OF 0.2 GPM/SQFT. OVER 1000 SQFT. REMOVE AREA WITH 200 GPM HOSE FLOW ADDED AT HYDRAULIC SOURCE NODE  
STORAGE AREA DESIGN CRITERIA PER NFPA-13 2010 14.2.3 STORAGE 12 FT. OR LESS IN HEIGHT. ABLE TO STORE 100 GPM HOSE FLOW ADDED AT HYDRAULIC SOURCE UP TO 10 FT. IN HEIGHT PER NFPA-13 2010 TABLE 13.2.1 ORDINARY HAZARD GROUP 2 DESIGN CRITERIA  
EXHIBIT AREA DESIGN CRITERIA PER NFPA-13 2010 6.3.2 ORDINARY HAZARD GROUP 2 DESIGN CRITERIA FOR MERCANTILE OCCUPANCY

THE FOLLOWING ROOMS ARE LIGHT HAZARD OCCUPANCY: RESTROOMS, LOBBIES, AND TICKET BOOTHS  
THE FOLLOWING ROOMS ARE ORDINARY HAZARD GROUP 2: STORAGE/ EXHIBIT AREAS





**GENERAL NOTES**  
1. ALL SPRINKLER MAINS AND U/L/O'S PER NFPA 13, 2010 EDITION  
2. ALL MATERIALS INSTALLED SHALL BE LISTED OR APPROVED FOR FIRE SPRINKLER USE  
3. ALL NEW PIPE 1 1/2" AND SMALLER SHALL BE BLACK PIPE SCHED. 40 WITH G Fittings. ALL NEW PIPE 2" AND LARGER SHALL BE BLACK PIPE SCHED. 40 WITH G Fittings. ALL NEW PIPE 2" AND LARGER SHALL BE DESIGNED, SPACED AND INSTALLED AS PER NFPA-13, 2010 EDITION CHAPTER 9  
4. ALL HANGERS SHALL BE DESIGNED, SPACED AND INSTALLED AS PER NFPA-13, 2010 EDITION CHAPTER 9  
5. WALL LENGTH OF UNSUPPORTED MAINS SHALL BE 24'. STATIC PRESSURE 4.00 PSI  
6. OTHERS TO PROVIDE PAINTING, WIRING, FIRE EXTINGUISHERS, HYDRANTS, THREAT BLOCKING, CITY FREEZING, CONSTRUCTION IS NON-COMBUSTIBLE  
7. OWNER SHALL BE RESPONSIBLE FOR ADEQUATE HEAT TO PREVENT SPRINKLER SYSTEM FROM FREEZING  
8. AREA WITHIN SCOPE OF WORK OF SYSTEM # 3 = 28,878 SQFT.  
9. AREA WITHIN SCOPE OF WORK OF SYSTEM # 4 = 31,116 SQFT.  
10. AREA OF COVERAGE OF EACH SYSTEM IS UNKNOWN  
NOTE: NO ADDITIONAL AREA ADDED TO EXISTING SPRINKLER SYSTEMS

FIRE FLOW INFORMATION PER FLOW TEST PERFORMED 3/21/11 BY COLORADO SPRINGS UTILITIES  
WSFIP WILL NOT BE RESPONSIBLE SHOULD THE MINIMUM WATER FLOW VALUES NOT BE SUPPLIED AT THE POINT OF CONNECTION OF THE HYDRAULIC SOURCE NODE.

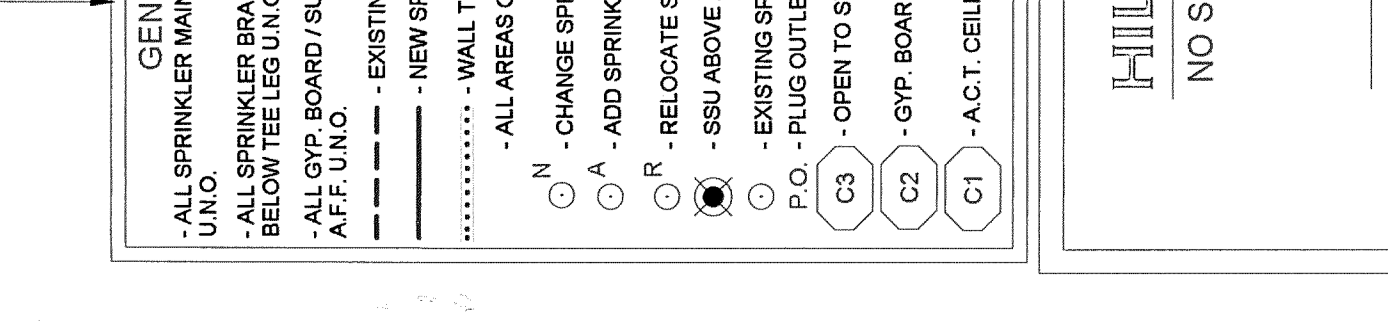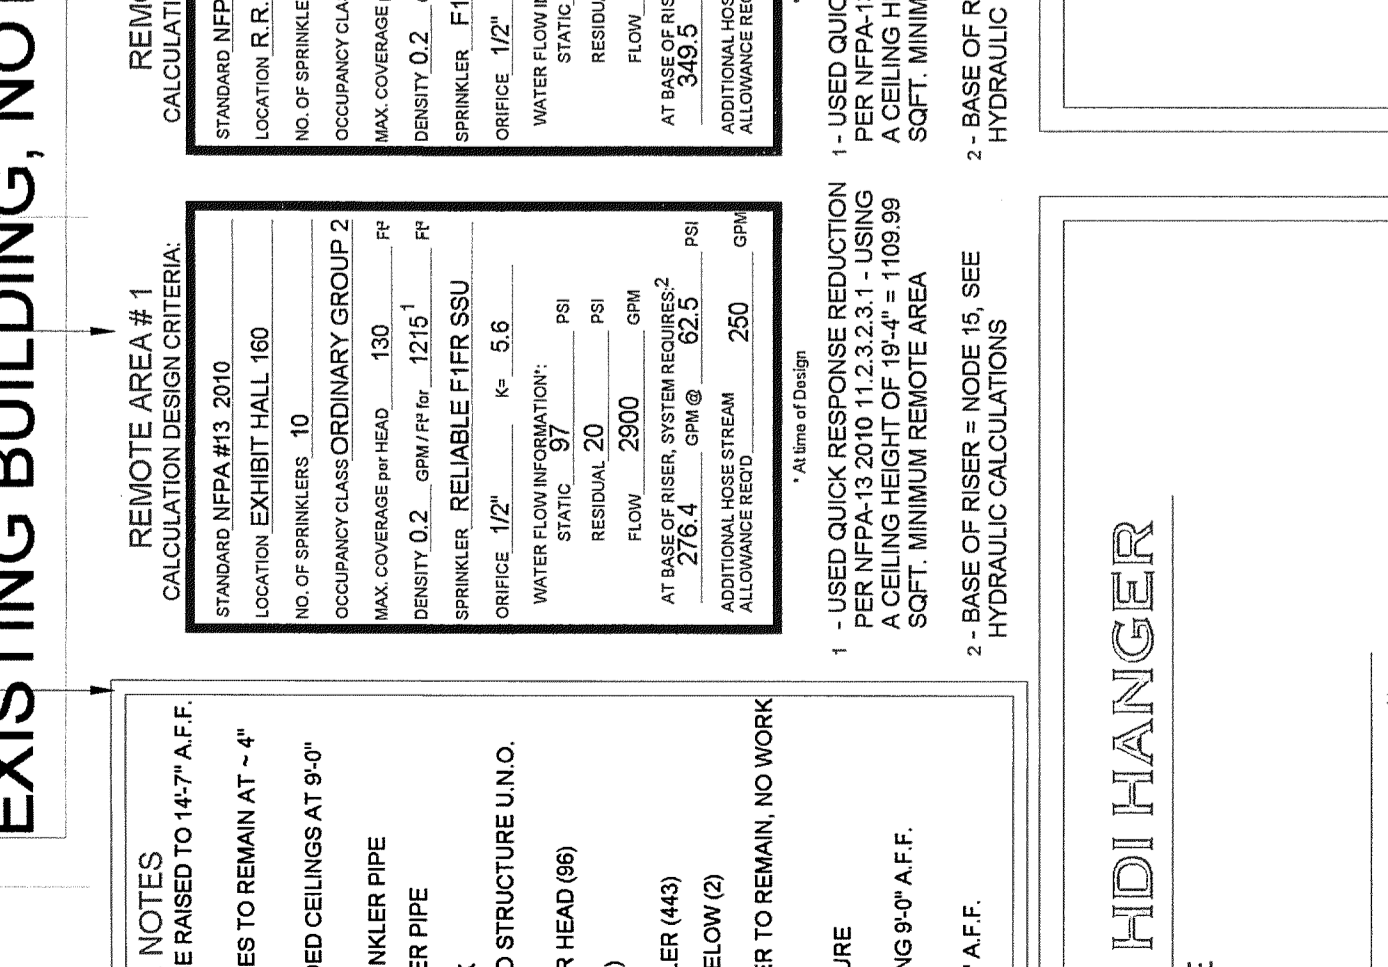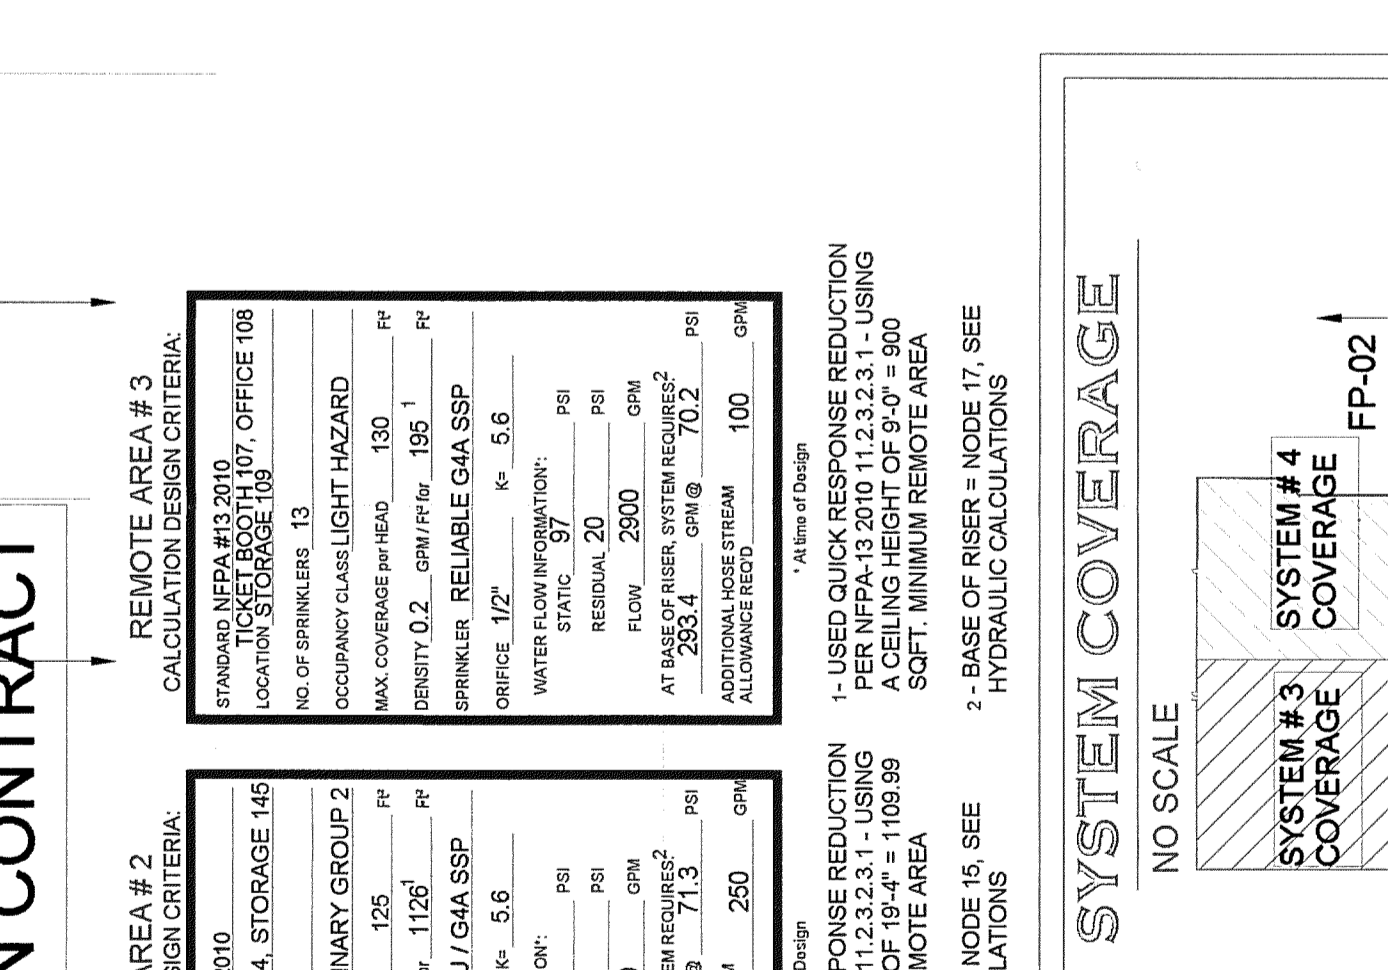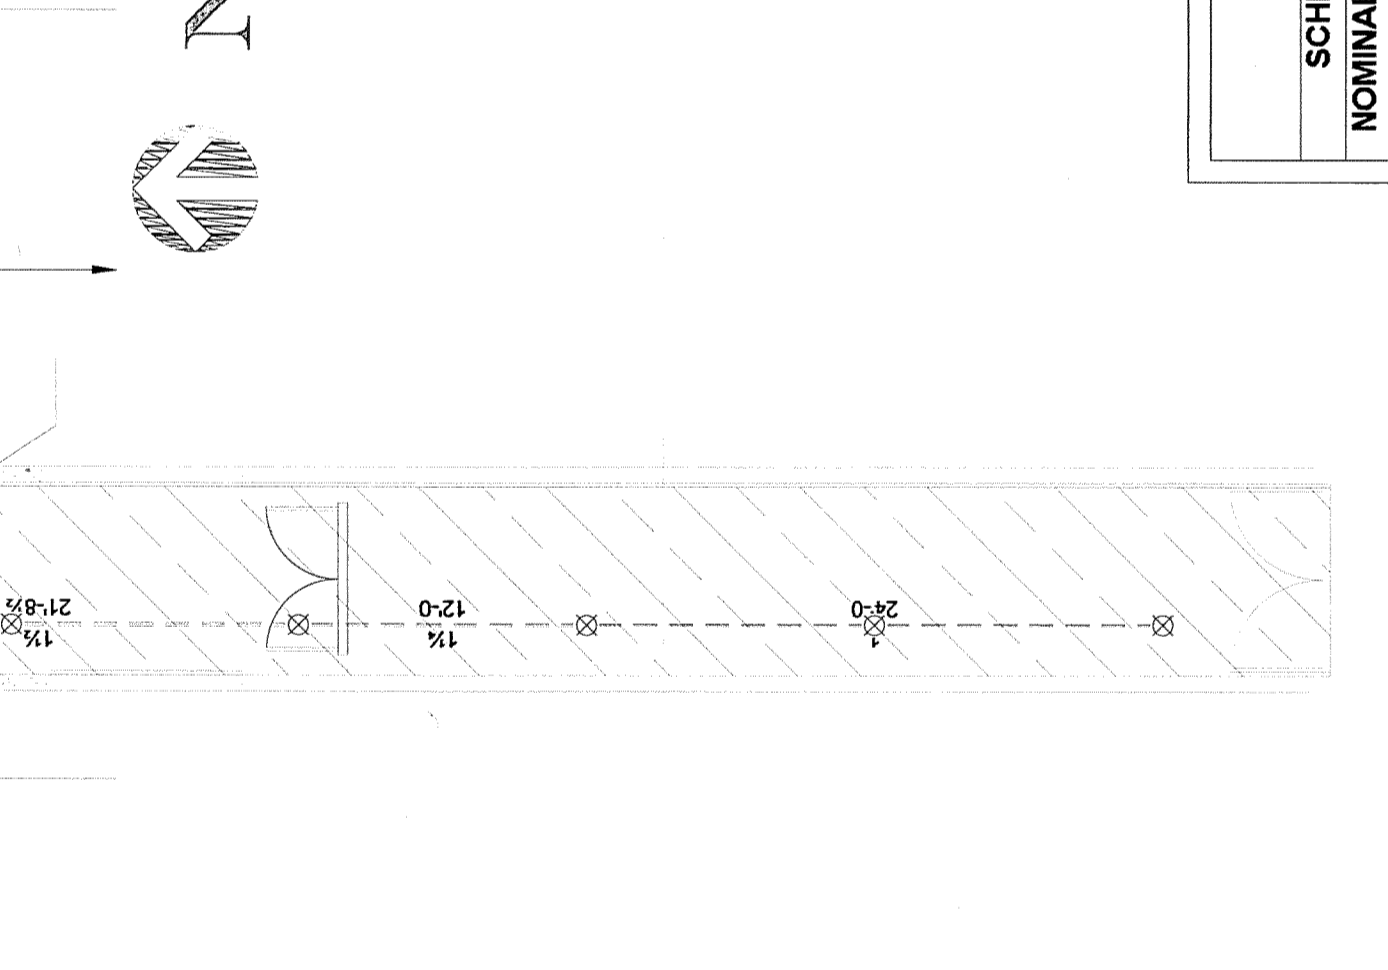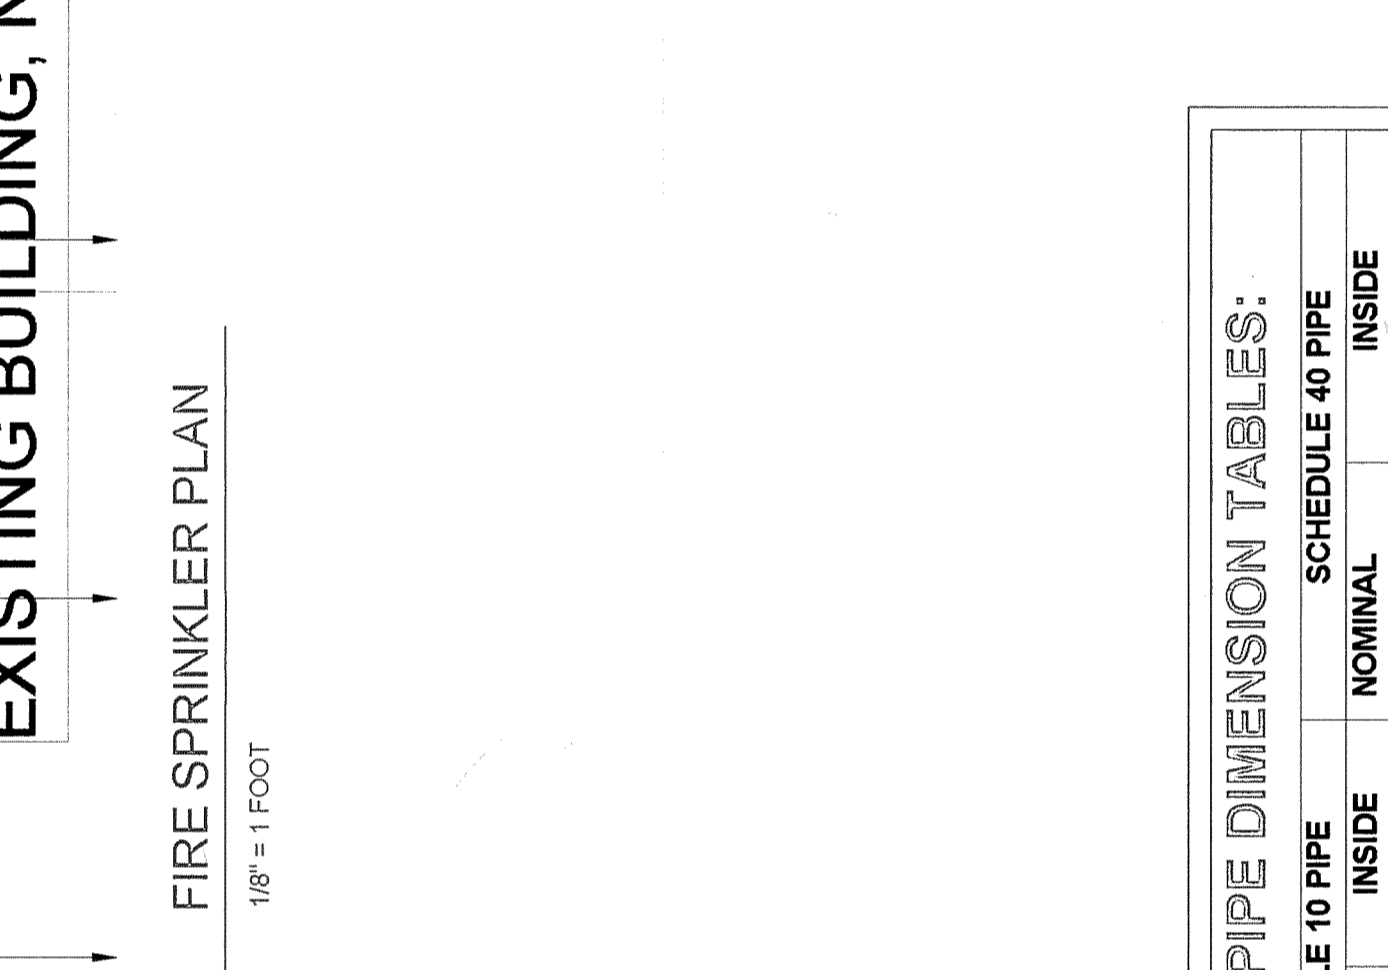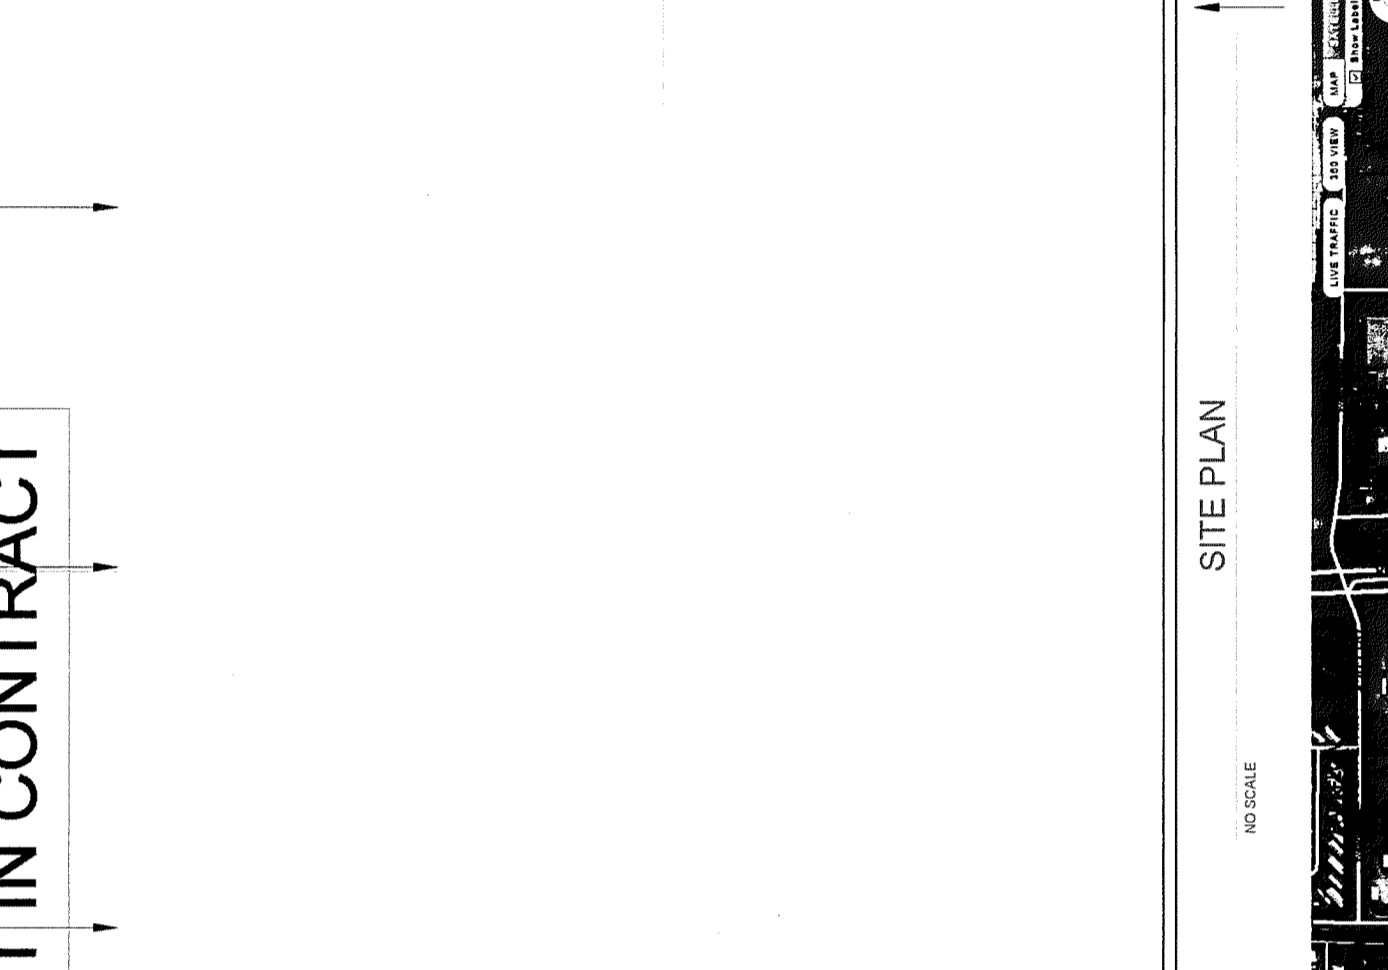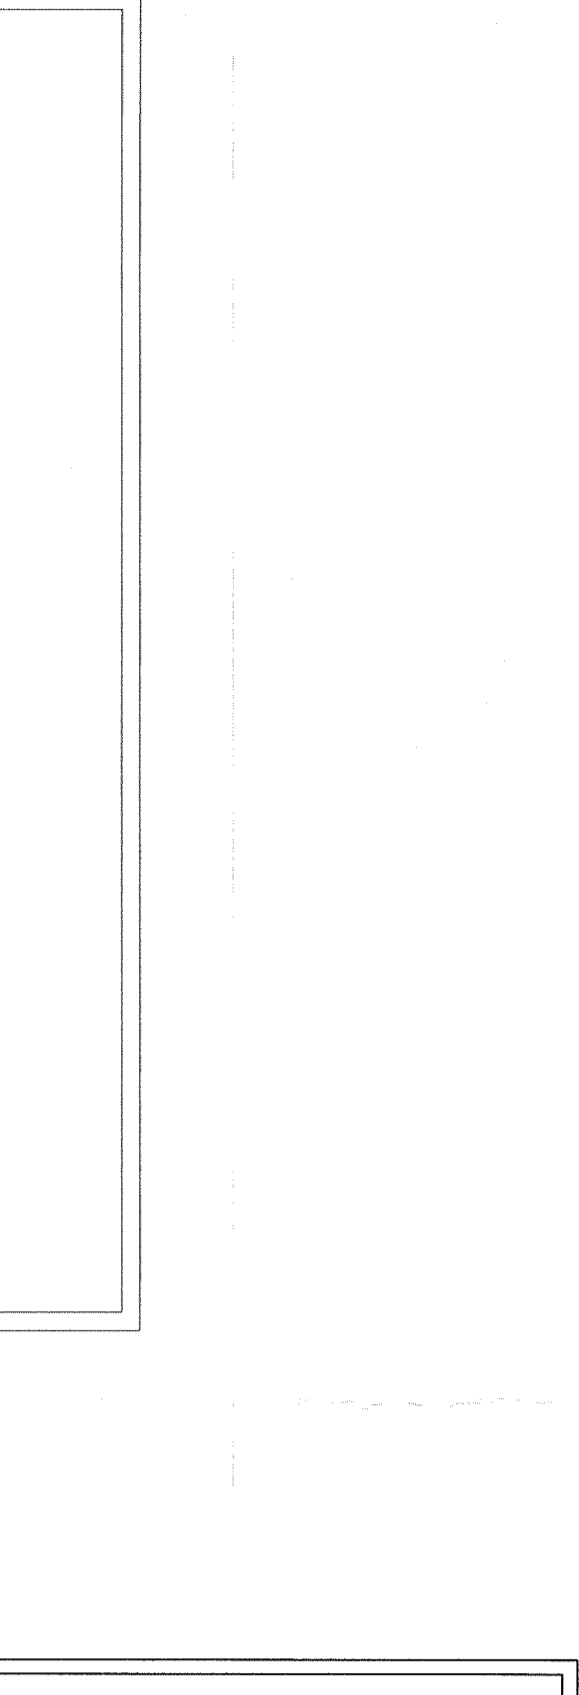

### PIPE DIMENSION TABLES:

SCHEDULE 40 PIPE	SCHEDULE 40 PIPE
NOMINAL PIPE SIZE	NOMINAL DIAMETER
1"	1.049
1 1/2"	1.380
2"	2.067
2 1/2"	2.469
3"	3.068
3 1/2"	3.548
4"	4.026
5"	5.047
6"	6.357
8"	8.249
	7.981

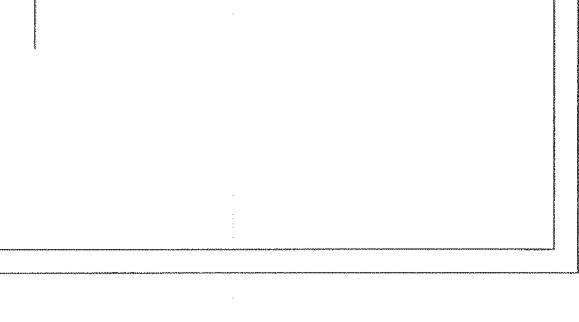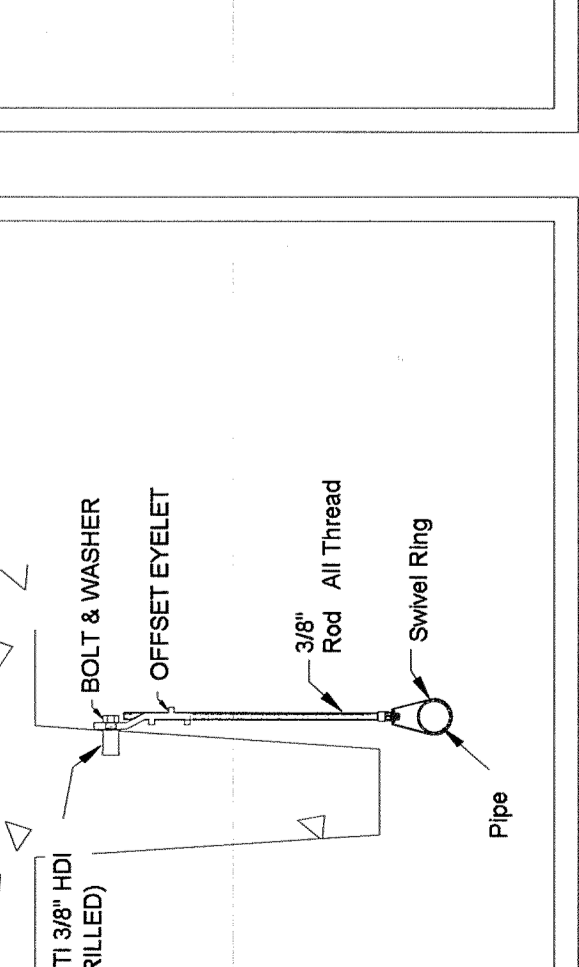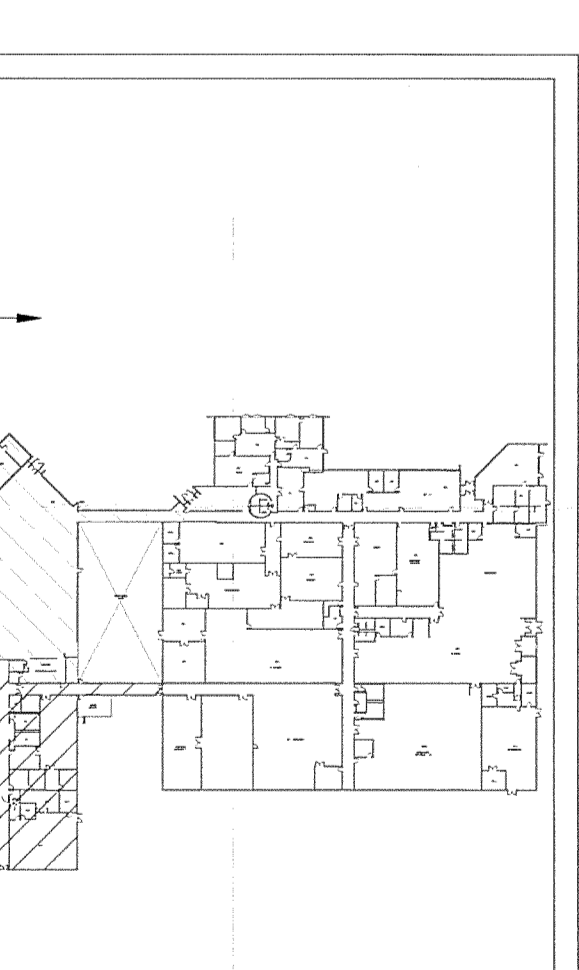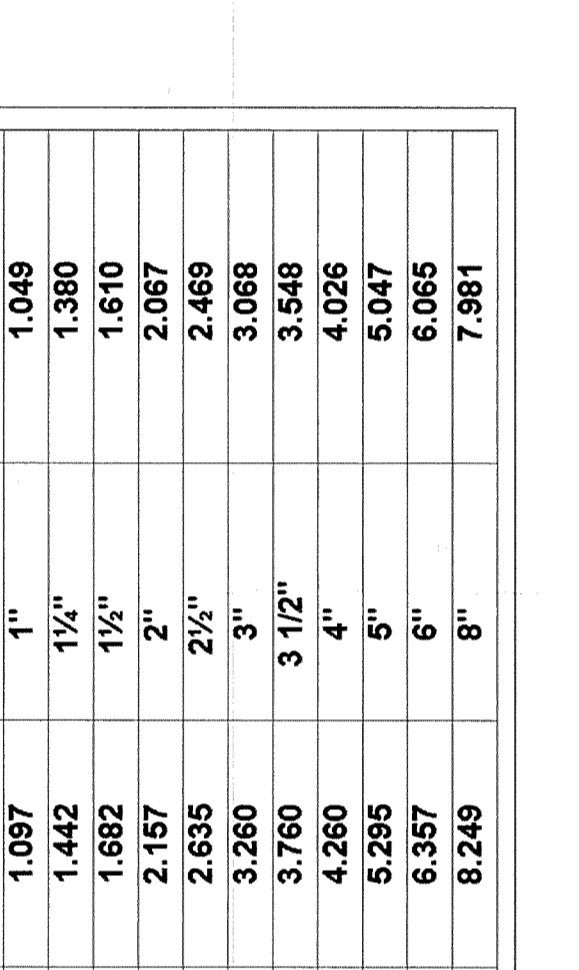

**FIRE DEPARTMENT PLAN REVIEW # 2011-0429-SP-1**  
**CONSTRUCTION TYPE - II-B**  
**OCCUPANCY CLASS: A-3 (EXHIBIT HALL)**  
**B (OFFICE BUILDING)**

**AS BUILT**

### GENERAL NOTES

1. ALL SPRINKLER MAINS TO BE RANSED TO 14'7" AFF.  
2. ALL SPRINKLER BRANCHLINES TO REMAIN AT 4" BELOW THE LEG U/O.  
3. AFF U/L/O - WARD/ SUSPENDED CEILING AT 9'0"  
4. - - - - - EXISTING SPRINKLER PIPE  
5. - - - - - NEW SPRINKLER PIPE  
6. - - - - - WALL TO DECK  
7. - - - - - ALL AREAS OPEN TO STRUCTURE U/L/O.  
8. - - - - - CHANGE SPRINKLER HEAD (SP)  
9. - - - - - ADD SPRINKLER (SP)  
10. - - - - - RELOCATE SPRINKLER (SP)  
11. - - - - - SHU ABOVE / SSP BELOW (S)  
12. - - - - - EXISTING SPRINKLER TO REMAIN, NO WORK  
13. - - - - - PLUG OUTLET  
14. - - - - - OPEN TO STRUCTURE  
15. - - - - - GVR - BOARD CEILING 9'0" AFF.  
16. - - - - - ACT. CEILING 9'0" AFF.

### REMOTE AREA #1

CALCULATION DESIGN CRITERIA:  
STANDARD REPAIRS: 200  
EXPOSED: 100  
TOTAL: 300  
OCCUPANCY CLASS: ORDINARY GROUP 2  
DESIGN DENSITY: 0.2 GPM/FT<sup>2</sup> 121.5  
MAX. COVERAGE PER HEAD: 130  
SPRINKLER: RELIABLE GAA SSP  
OFFICE: 1/2" K = 5.6  
WATER FLOW INFORMATION:  
FLOW: 2000 GPM  
RESIDUAL: 20 PSI  
AT 236.5 FEET  
ADDITIONAL LEGS: 250  
ADDITIONAL LEGS: 100

Values of Design:  
1. USES: CLASS B REVISION PER NFPA 13 2010 12.3.3.1.1 USING A CEILING HEIGHT OF 9'-0" = 300 SQFT. MINIMUM REMOTE AREA:  
2. BASE OF RISER - MODE R. SEE HYDRAULIC CALCULATIONS

### REMOTE AREA #2

CALCULATION DESIGN CRITERIA:  
STANDARD REPAIRS: 200  
EXPOSED: 100  
TOTAL: 300  
OCCUPANCY CLASS: ORDINARY GROUP 2  
DESIGN DENSITY: 0.2 GPM/FT<sup>2</sup> 121.5  
MAX. COVERAGE PER HEAD: 130  
SPRINKLER: RELIABLE GAA SSP  
OFFICE: 1/2" K = 5.6  
WATER FLOW INFORMATION:  
FLOW: 2000 GPM  
RESIDUAL: 20 PSI  
AT 236.5 FEET  
ADDITIONAL LEGS: 250  
ADDITIONAL LEGS: 100

Values of Design:  
1. USES: CLASS B REVISION PER NFPA 13 2010 12.3.3.1.1 USING A CEILING HEIGHT OF 9'-0" = 300 SQFT. MINIMUM REMOTE AREA:  
2. BASE OF RISER - MODE R. SEE HYDRAULIC CALCULATIONS

### REMOTE AREA #3

CALCULATION DESIGN CRITERIA:  
STANDARD REPAIRS: 200  
EXPOSED: 100  
TOTAL: 300  
OCCUPANCY CLASS: LIGHT HAZARD  
DESIGN DENSITY: 0.1 GPM/FT<sup>2</sup> 195  
MAX. COVERAGE PER HEAD: 130  
SPRINKLER: RELIABLE GAA SSP  
OFFICE: 1/2" K = 5.6  
WATER FLOW INFORMATION:  
FLOW: 2000 GPM  
RESIDUAL: 20 PSI  
AT 236.5 FEET  
ADDITIONAL LEGS: 250  
ADDITIONAL LEGS: 100

Values of Design:  
1. USES: CLASS B REVISION PER NFPA 13 2010 12.3.3.1.1 USING A CEILING HEIGHT OF 9'-0" = 300 SQFT. MINIMUM REMOTE AREA:  
2. BASE OF RISER - MODE R. SEE HYDRAULIC CALCULATIONS

### SYSTEM COVERAGE

NO SCALE

SYSTEM # 3 COVERAGE  
SYSTEM # 4 COVERAGE  
MATCHLINE

**BUILDING SECTION A**  
NO SCALE

CONCRETE DBL. TEE  
MASONRY WALL 17'-6" MAX 15'-6" MIN  
CONCRETE FLOOR

**BUILDING SECTION B**  
NO SCALE

CONCRETE DBL. TEE  
MASONRY WALL 17'-6" MAX 15'-6" MIN  
CONCRETE FLOOR

**TYPICAL DROP TO PENDENT SPRINKLER HEAD DETAIL**







EXISTING BRANCHLINE AT VARIOUS HEIGHTS  
1" SCH. 40 DROP  
CONCEALED HEAD  
SUSPENDED / GVP BOARD CEILING HEADS SHALL BE INSTALLED IN CENTER OF TILE

**UPRIGHT SPRINKLER DETAIL**  
NO SCALE

UPRIGHT HEAD  
1" SCH. 40 SPRIG  
BRANCHLINE @ VARIOUS HEIGHTS  
CAST IRON TEE  
UPRIGHT HEAD  
BRANCHLINE @ VARIOUS HEIGHTS  
CAST IRON TEE  
POSITION / DEFLECTOR MAXIMUM OF 1" BELOW LEG OF CONCRETE TEE PER NFPA 13 2010 8.6.4.1.2 (5)

**HILTI HDI HANGER**  
NO SCALE

HILTI 388 HDI (DRILLED)  
BOLT & WASHER  
OFFSET EYELET  
3/8" Rod All Thread  
Swivel Ring  
Pipe

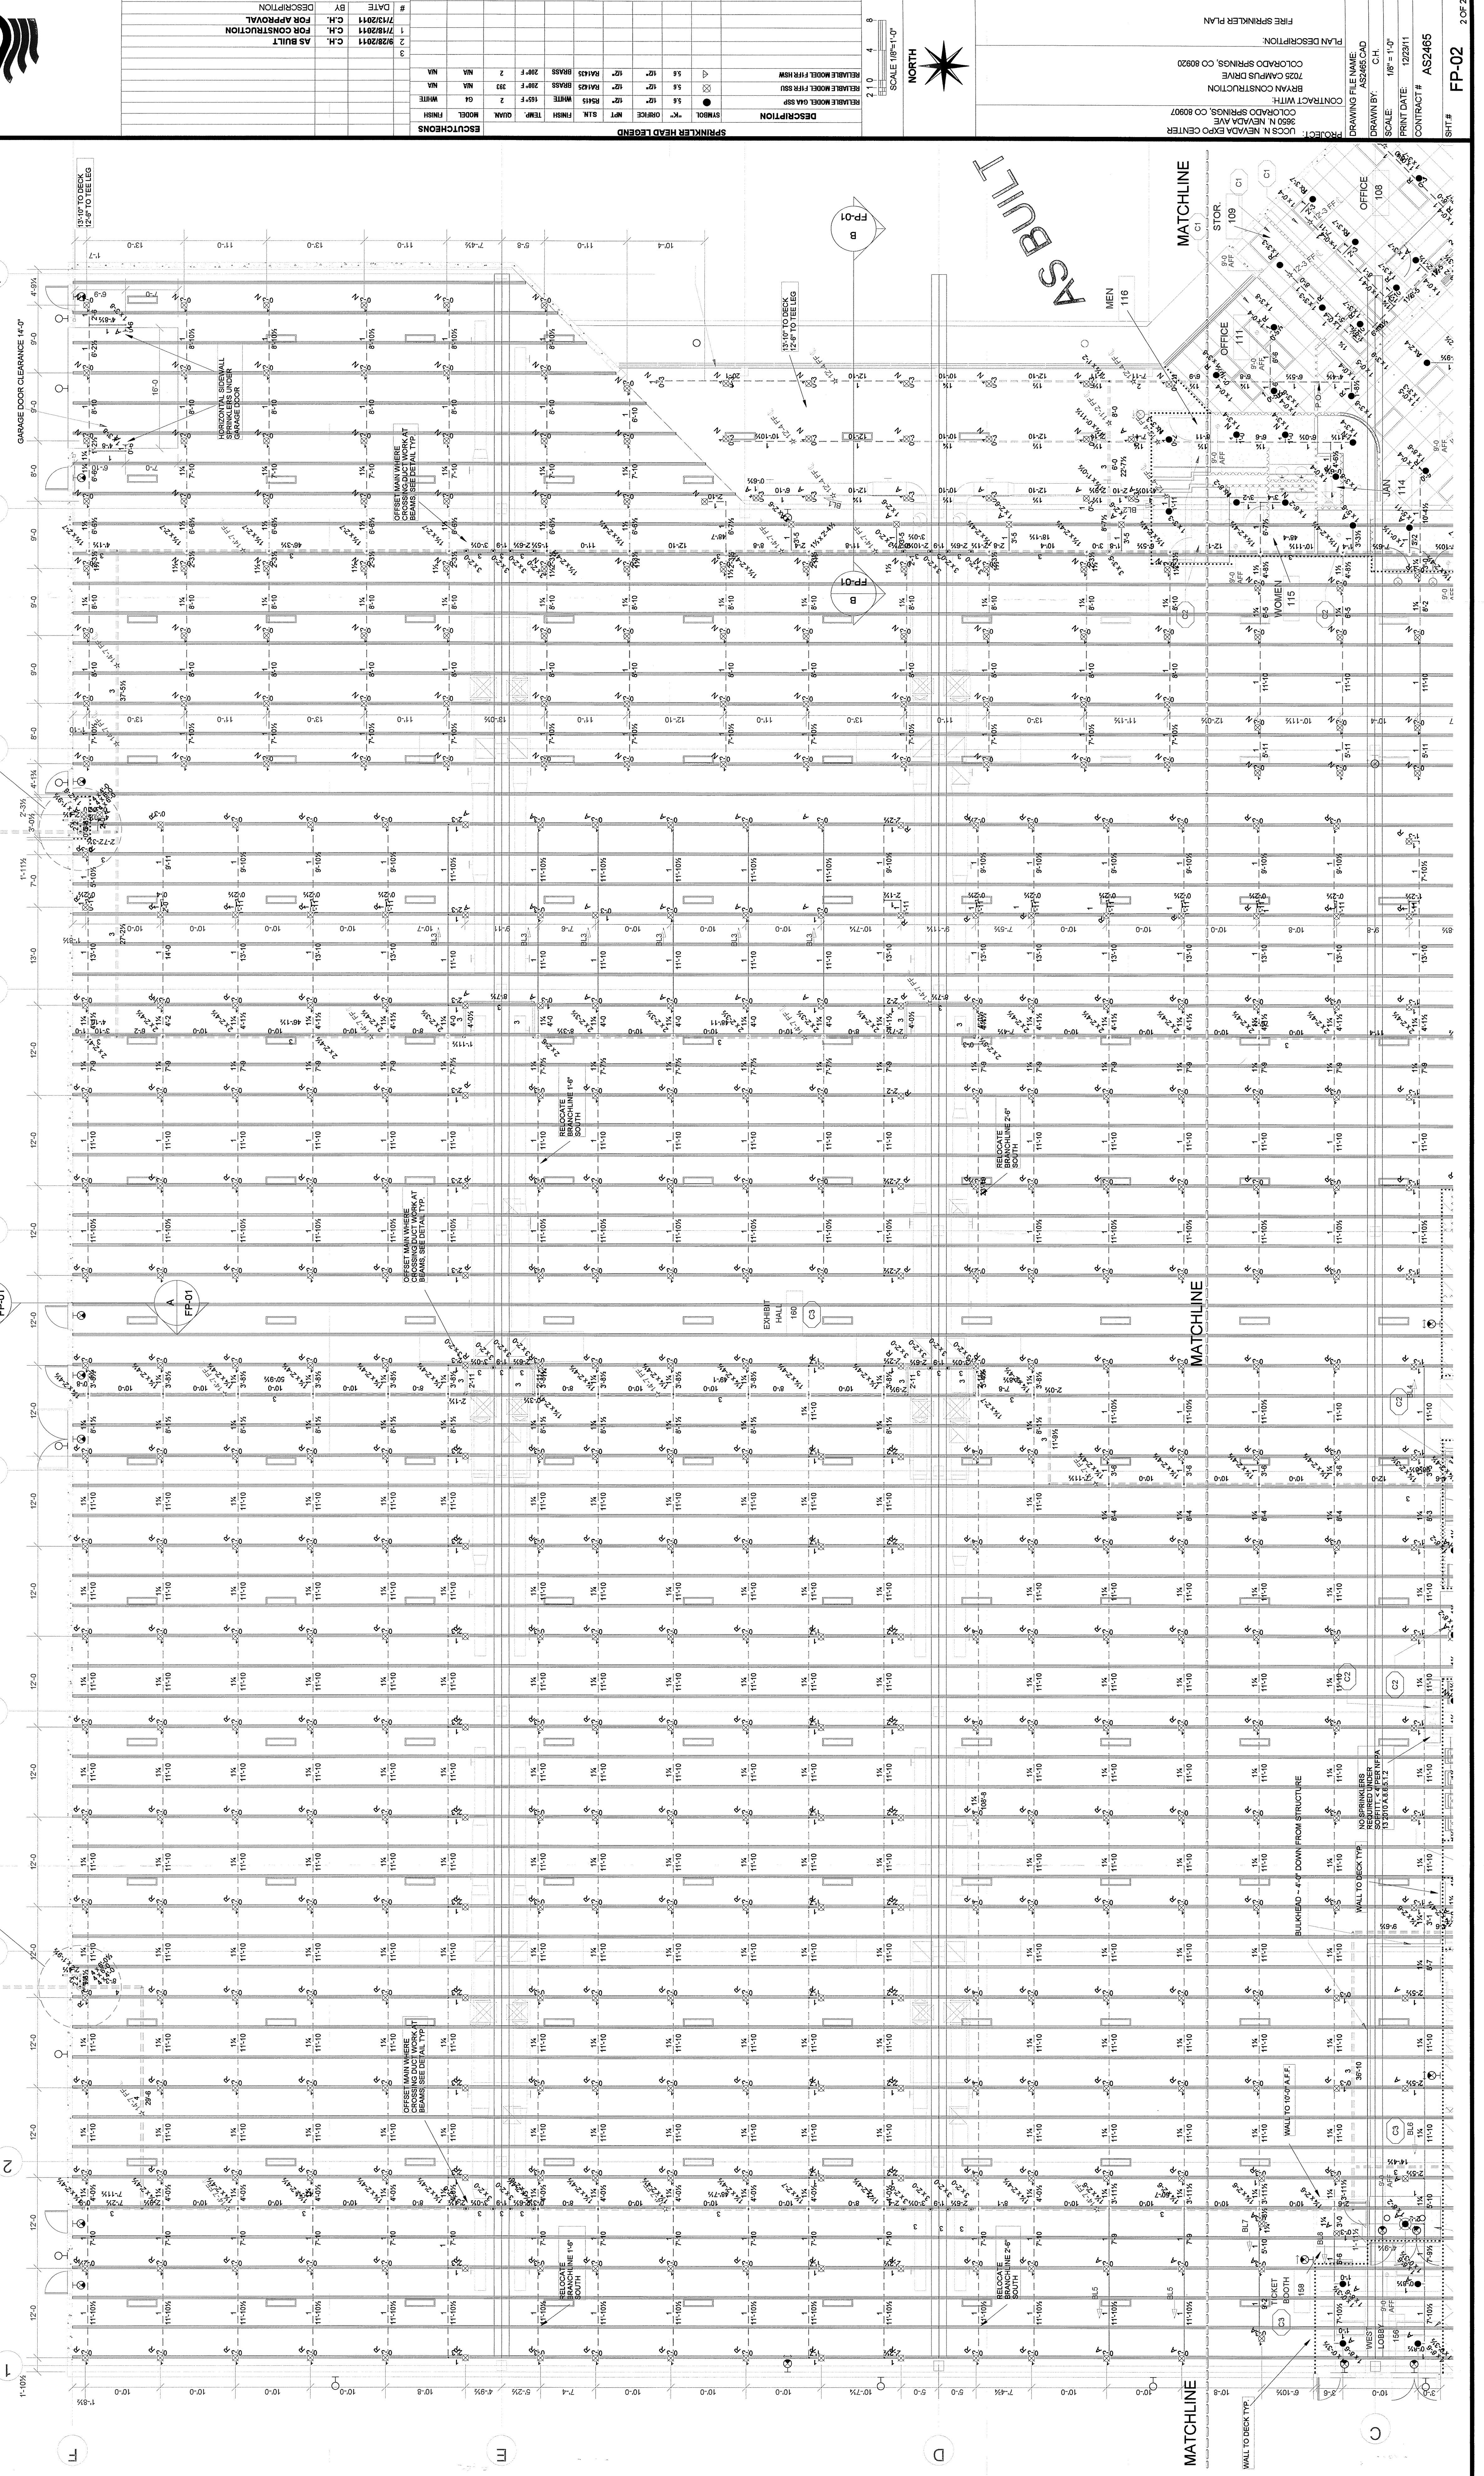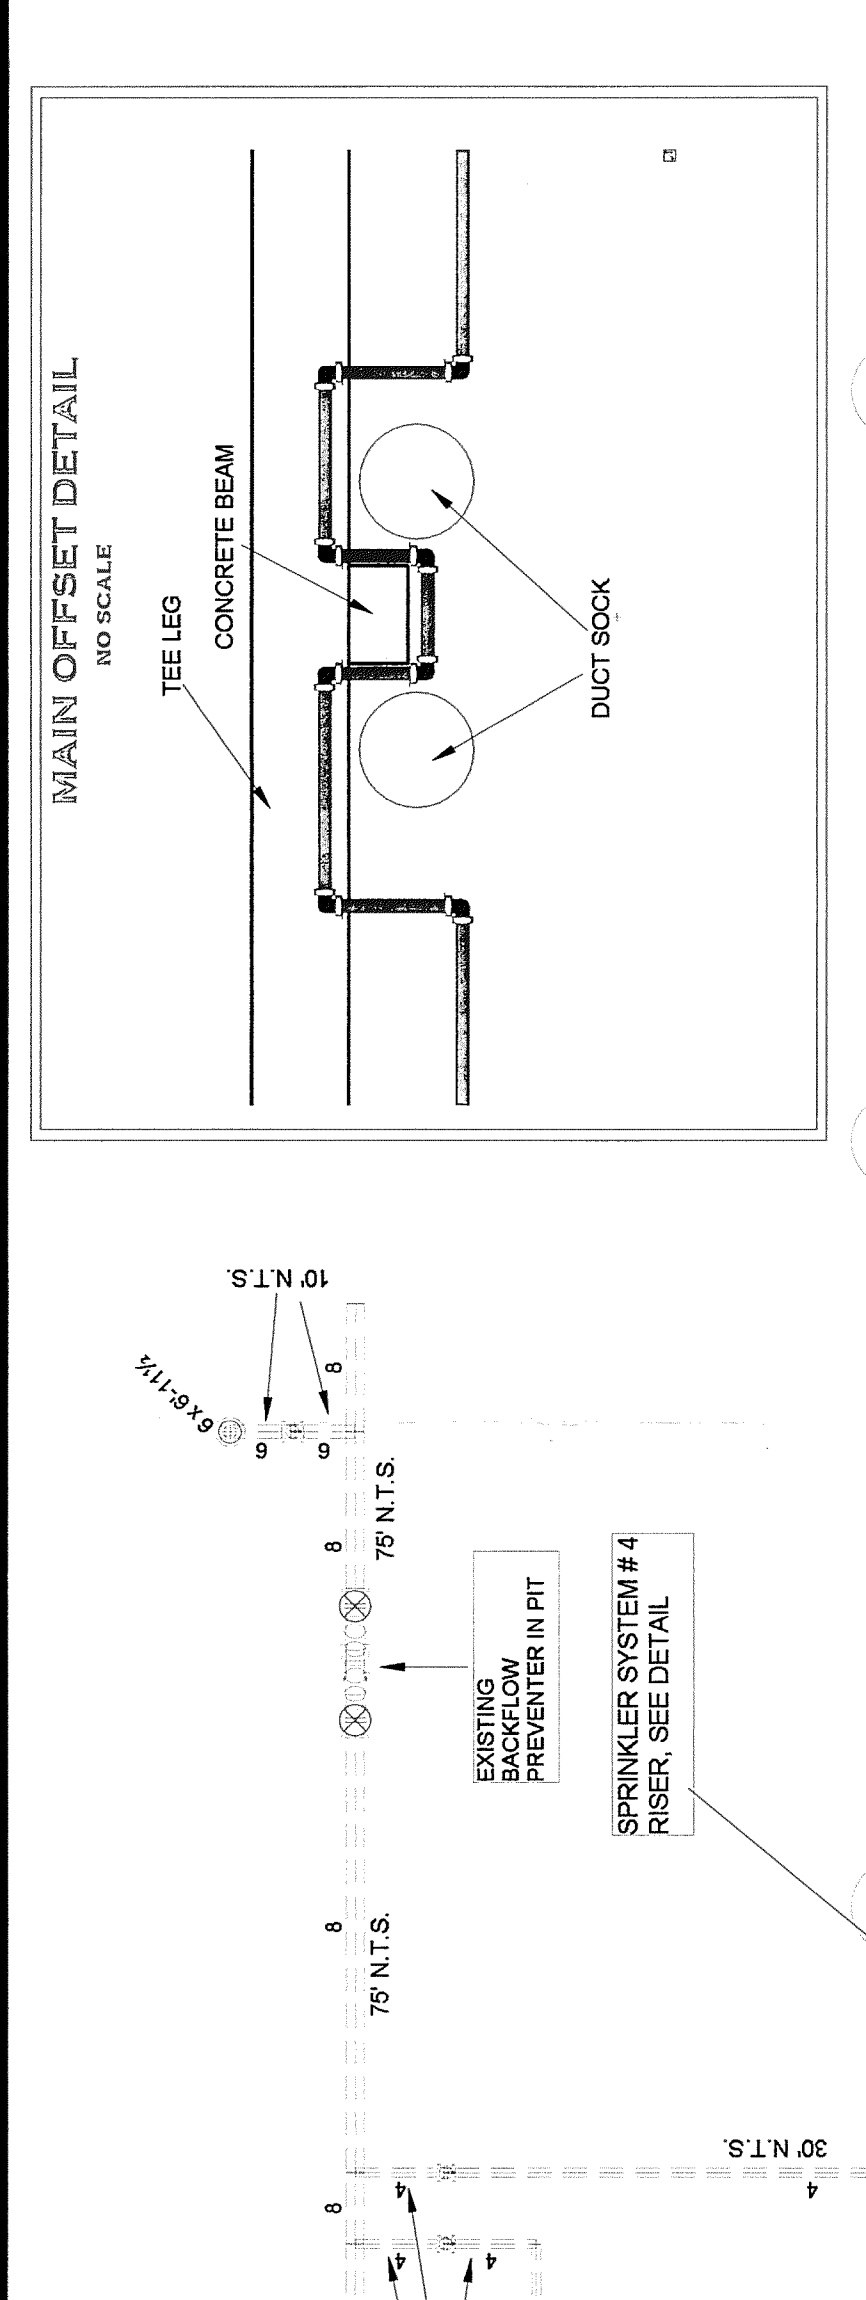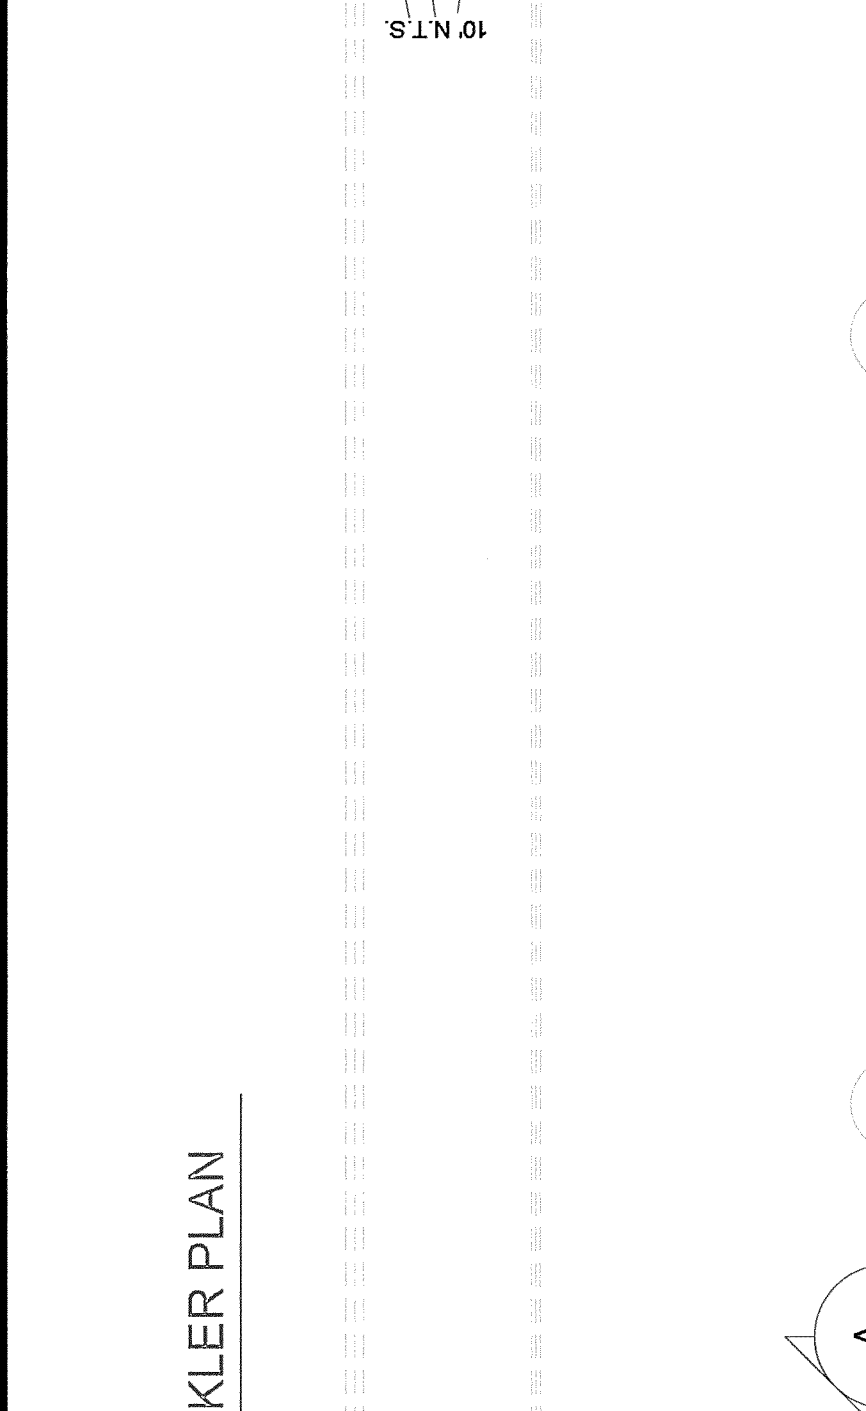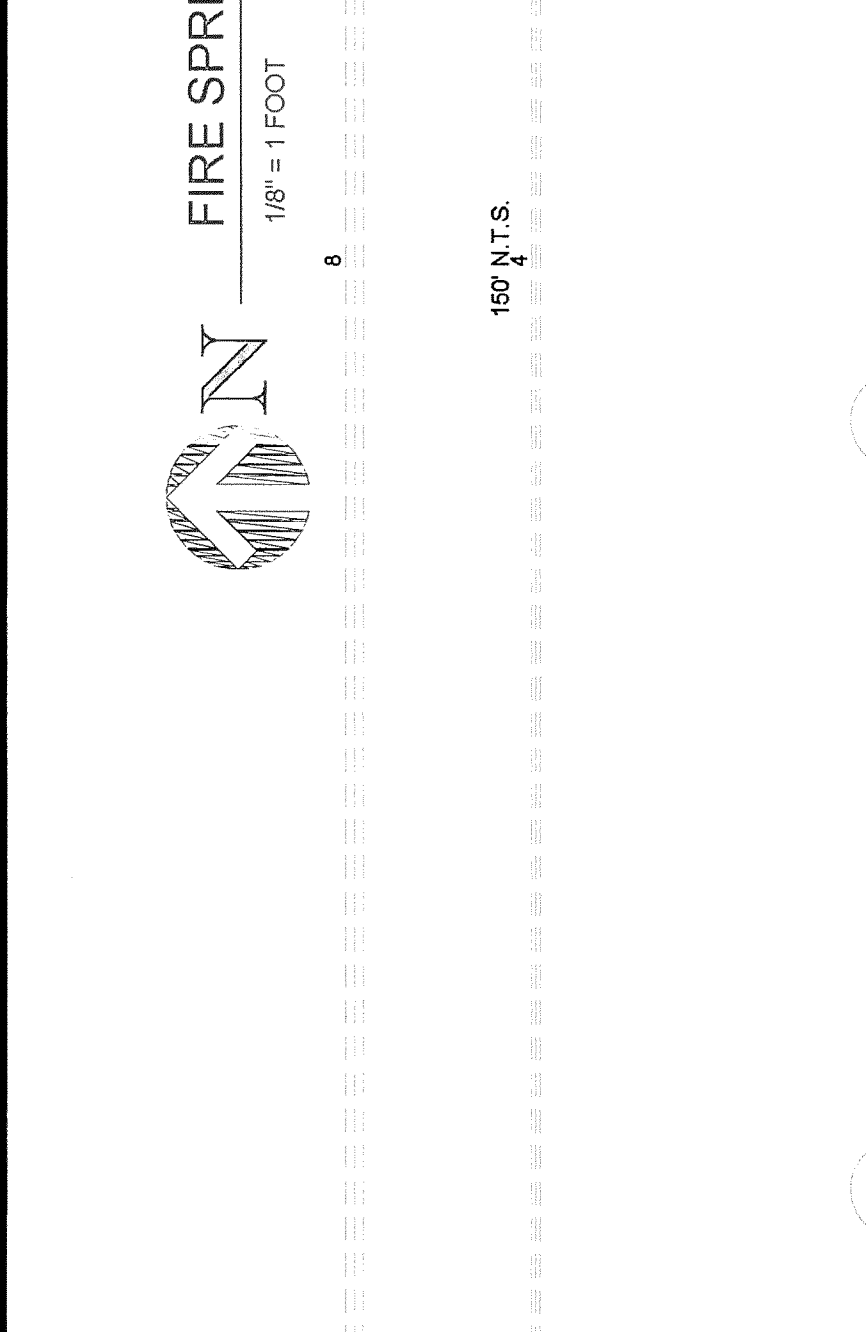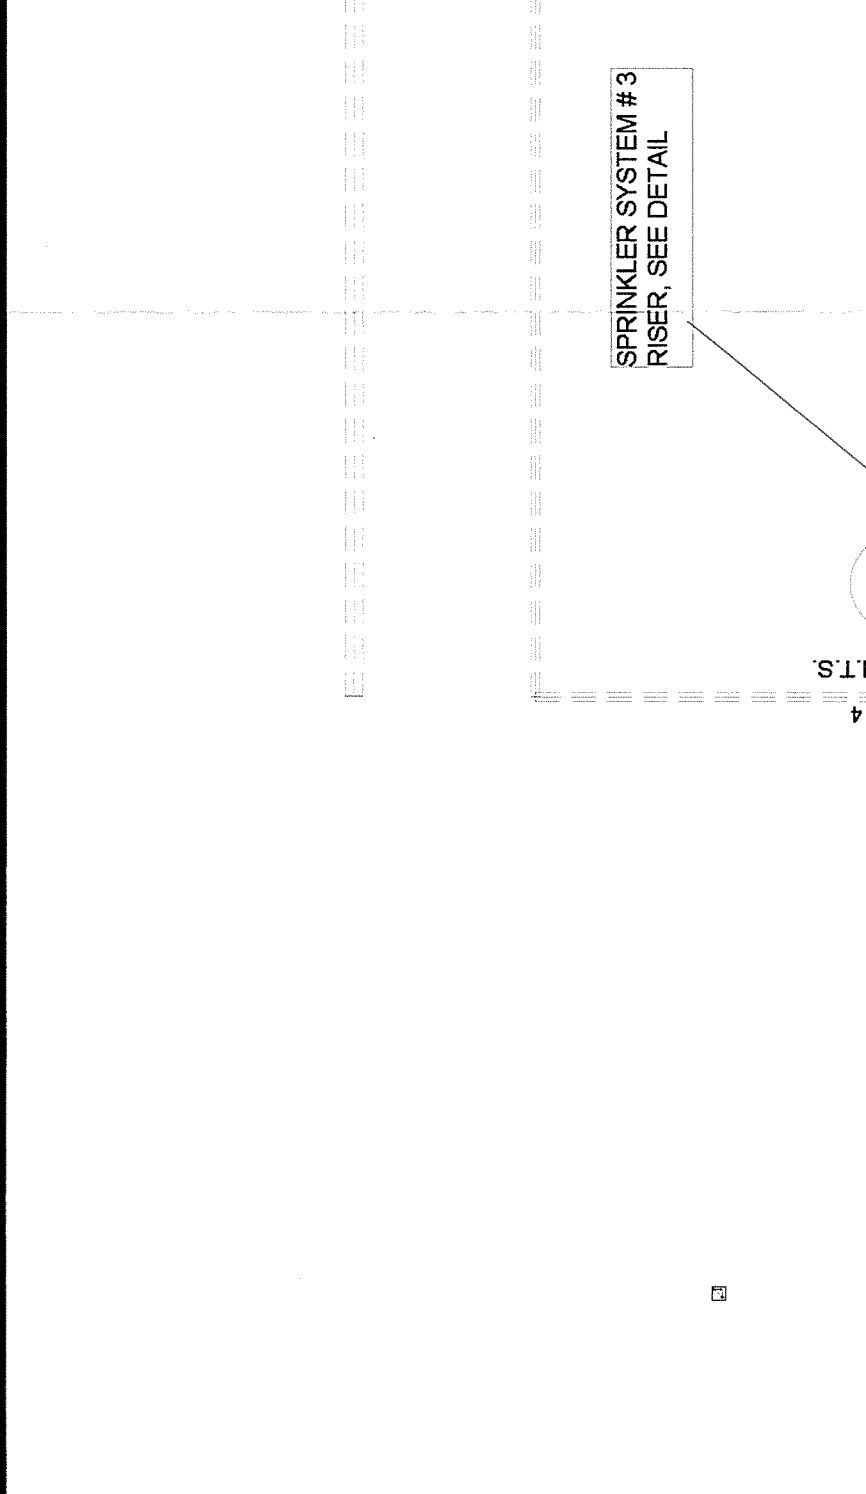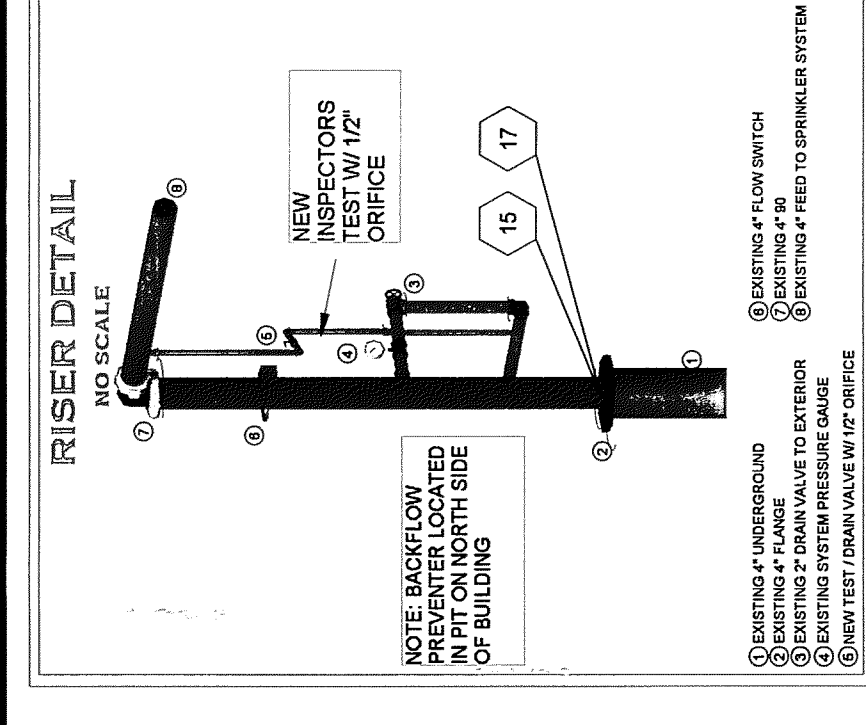

#	DATE	BY	DESCRIPTION
1	7/12/2014	C.H.	FOR APPROVAL
2	9/28/2014	C.H.	AS BUILT
3		C.H.	FOR CONSTRUCTION

SYMBOL	DESCRIPTION	RELIABLE MODEL FPR SSI	RELIABLE MODEL FPR HSW
○	SPIRATOR	0.5	0.5
○	ORifice	0.5	0.5
○	TEMP. QUAN.	0.5	0.5
○	FINISH	0.5	0.5
○	DRIPS	0.5	0.5
○	ORifice	0.5	0.5
○	TEMP. QUAN.	0.5	0.5
○	FINISH	0.5	0.5
○	DRIPS	0.5	0.5
○	ORifice	0.5	0.5
○	TEMP. QUAN.	0.5	0.5
○	FINISH	0.5	0.5
○	DRIPS	0.5	0.5

DATE	DESCRIPTION	BY
7/12/2014	FOR APPROVAL	C.H.
9/28/2014	AS BUILT	C.H.
	FOR CONSTRUCTION	C.H.

**PROJECT:** UCCS N. NEVADA EXP. CENTER  
9800 N. NEVADA AVE  
COLORADO SPRINGS, CO 80907

**CONTRACTOR:** BRYAN CONSTRUCTION  
7025 CAMPUS DRIVE  
COLORADO SPRINGS, CO 80907

**PLAN DESCRIPTION:** FIRE SPRINKLER PLAN

**DRAWING FILE NAME:** UCCS\_N\_COLEDGE.DWG  
DRAWN BY: C.H.  
SCALE: 1/8" = 1'-0"

**PRINT DATE:** 12/23/11  
**CONTRACT #:** AS2485

**SHEET #:** FP-02  
**TOTAL SHEETS:** 25

**REVISIONS**

#	DATE	BY	DESCRIPTION
1	7/12/2014	C.H.	FOR APPROVAL
2	9/28/2014	C.H.	AS BUILT
3		C.H.	FOR CONSTRUCTION

**ESCUTCIONS**

SYMBOL	DESCRIPTION	RELIABLE MODEL FPR SSI	RELIABLE MODEL FPR HSW
○	SPIRATOR	0.5	0.5
○	ORifice	0.5	0.5
○	TEMP. QUAN.	0.5	0.5
○	FINISH	0.5	0.5
○	DRIPS	0.5	0.5
○	ORifice	0.5	0.5
○	TEMP. QUAN.	0.5	0.5
○	FINISH	0.5	0.5
○	DRIPS	0.5	0.5
○	ORifice	0.5	0.5
○	TEMP. QUAN.	0.5	0.5
○	FINISH	0.5	0.5
○	DRIPS	0.5	0.5

**SHEET TOTAL**

SCALE: 1/8" = 1'-0"  
NORTH